

Basis of this breakdown

1. Bulletin 3 (M-529 / M-530 / M-531, revision 4, 08/10/2026) was issued after the ductwork in the affected areas had been fabricated and installed per the Addendum 1 drawings. The change therefore includes **disconnecting and removing installed ductwork**, in addition to fabricating and installing the revised work.
2. Each floor is shown with the Addendum 1 drawing ("Before") overlaid on the Bulletin 3 drawing ("After"). Every change area is numbered and has its own detail page with the before, after and overlay views and the cost for that area.
3. Each area is broken down into disconnect / removal labor, ductwork material (fabricated duct, fittings, insulation, accessories), ductwork relocation / install labor and air outlet material; shop drawings are listed per floor. Labor is at \$125.00 per man-hour as submitted. The total equals COP-SF-05, \$66,780.
4. Quantities (LF) are approximate, taken from the drawings at 1/8" = 1'-0".
5. Red revision clouds in the overlays are Addendum 1 clouds that were dropped from Bulletin 3; moved tags and labels also show in red / blue. Only the ductwork within the numbered areas is priced.


- Unchanged
- Addendum 1 only - installed, removed
- Bulletin 3 only - new work

Summary by floor

Floor	Disconnect / removal labor	Ductwork material	Ductwork install labor	Air outlet material	Shop drawings	Total
29th floor (M-529.00)	\$2,625	\$10,725	\$15,250	-	\$1,000	\$29,600
30th floor (M-530.00)	\$2,750	\$3,850	\$10,000	\$500	\$1,000	\$18,100
31th floor (M-531.00)	\$2,125	\$5,830	\$10,125	-	\$1,000	\$19,080
Total	\$7,500	\$20,405	\$35,375	\$500	\$3,000	\$66,780
Man-hours	60 MH		283 MH			

Change areas




Area	Description	Total
29-1	North supply main - reroute through existing beam cuts	\$15,075
29-2	Supply main resized 56x16 to 42x12	\$11,025
29-3	FPB-HW-E (1400) relocation and discharge reroute	\$2,500
30-1	IT Build Rm 30.23 / F&B Storage 30.14 / west dining	\$6,700
30-2	Lounge 30.02 - new transfer ducts	\$5,400
30-3	Meeting Rms 30.04 / 30.05, Storage 30.09, Vestibule 30.07	\$5,000
31-1	Zoom rooms, northwest - transfer ducts	\$1,205
31-2	Transfer duct TD 32x16, north	\$1,050
31-3	Storage 31.02 - new transfer ducts	\$4,700
31-4	Coffee Bar 31.12 - transfer ducts and main fitting	\$5,200
31-5	Transfer duct TD 32x16, southwest	\$2,900
31-6	Storage 31.15 / Room 31.16, southeast	\$3,025
	Shop drawings (29 / 30 / 31, \$1,000 each)	\$3,000
	Total	\$66,780

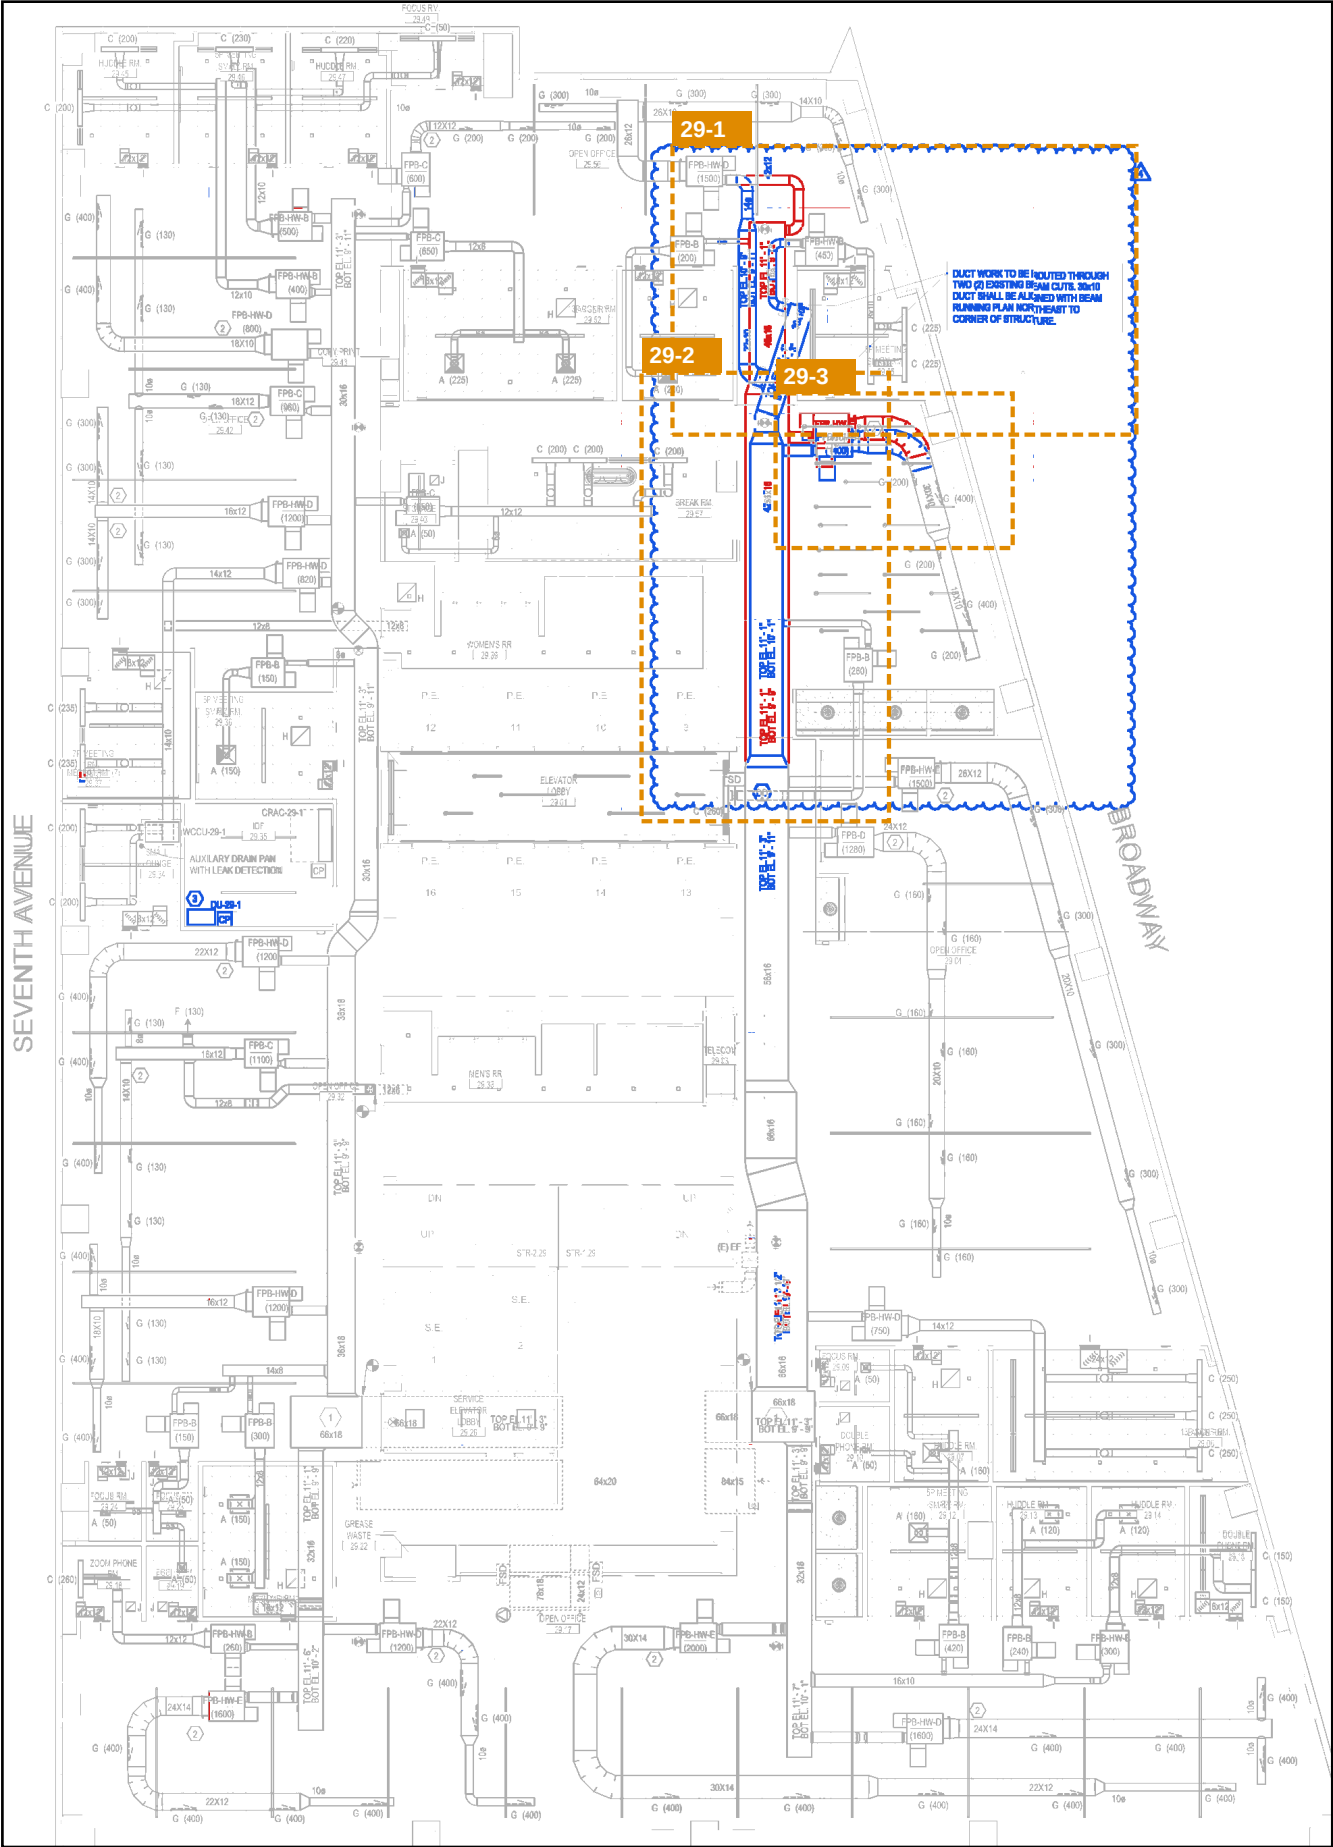

29th floor - cost by area

Area	Description	Disconnect	Material	Labor	Total
29-1	North supply main - reroute through existing beam cuts	\$1,500	\$6,075	\$7,500	\$15,075
29-2	Supply main resized 56x16 to 42x12	\$875	\$3,900	\$6,250	\$11,025
29-3	FPB-HW-E (1400) relocation and discharge reroute	\$250	\$750	\$1,500	\$2,500
	Shop drawings for revised design				\$1,000
29th floor total		\$2,625	\$10,725	\$15,250	\$29,600

Disconnect = disconnect / removal labor of installed Addendum 1 work incl. haul away and clean up. Material = fabricated ductwork, fittings, insulation, accessories and air outlets. Labor = relocation / installation of ductwork, terminal units and air outlets.

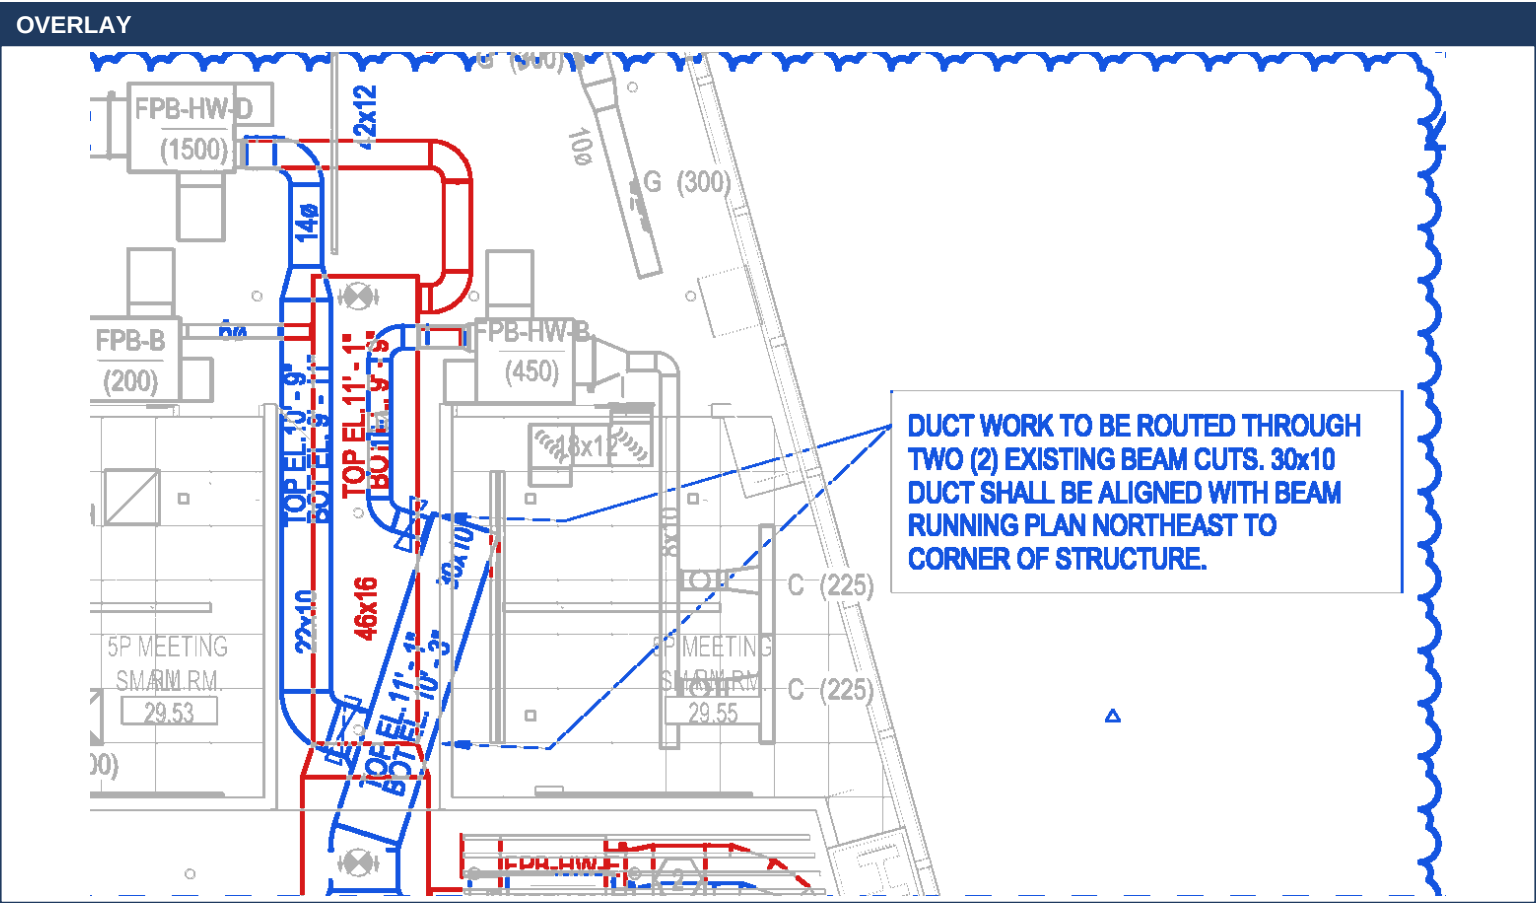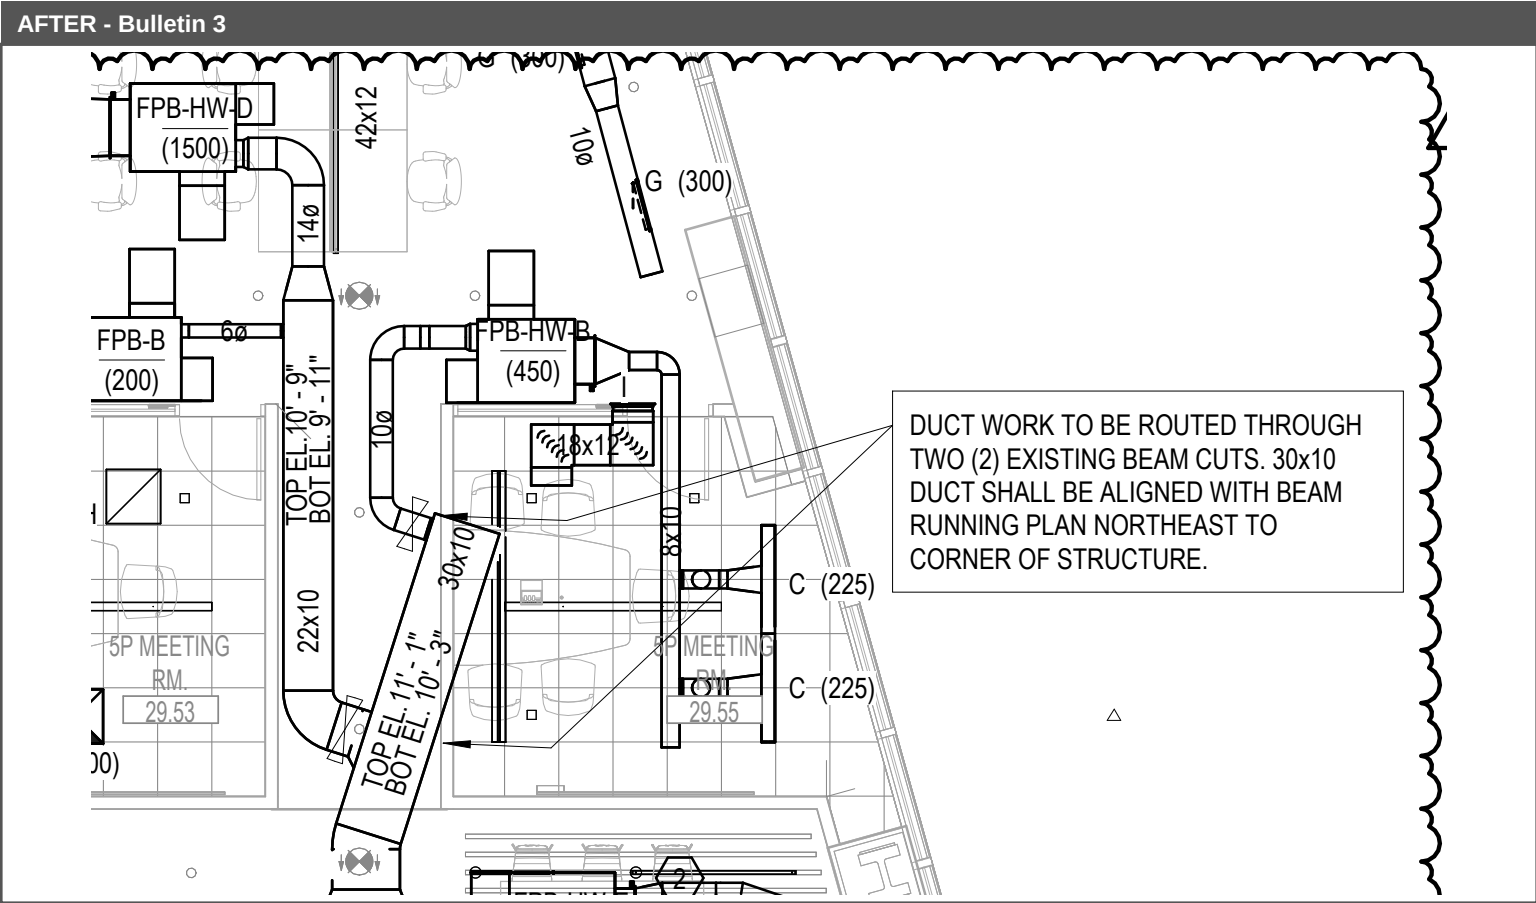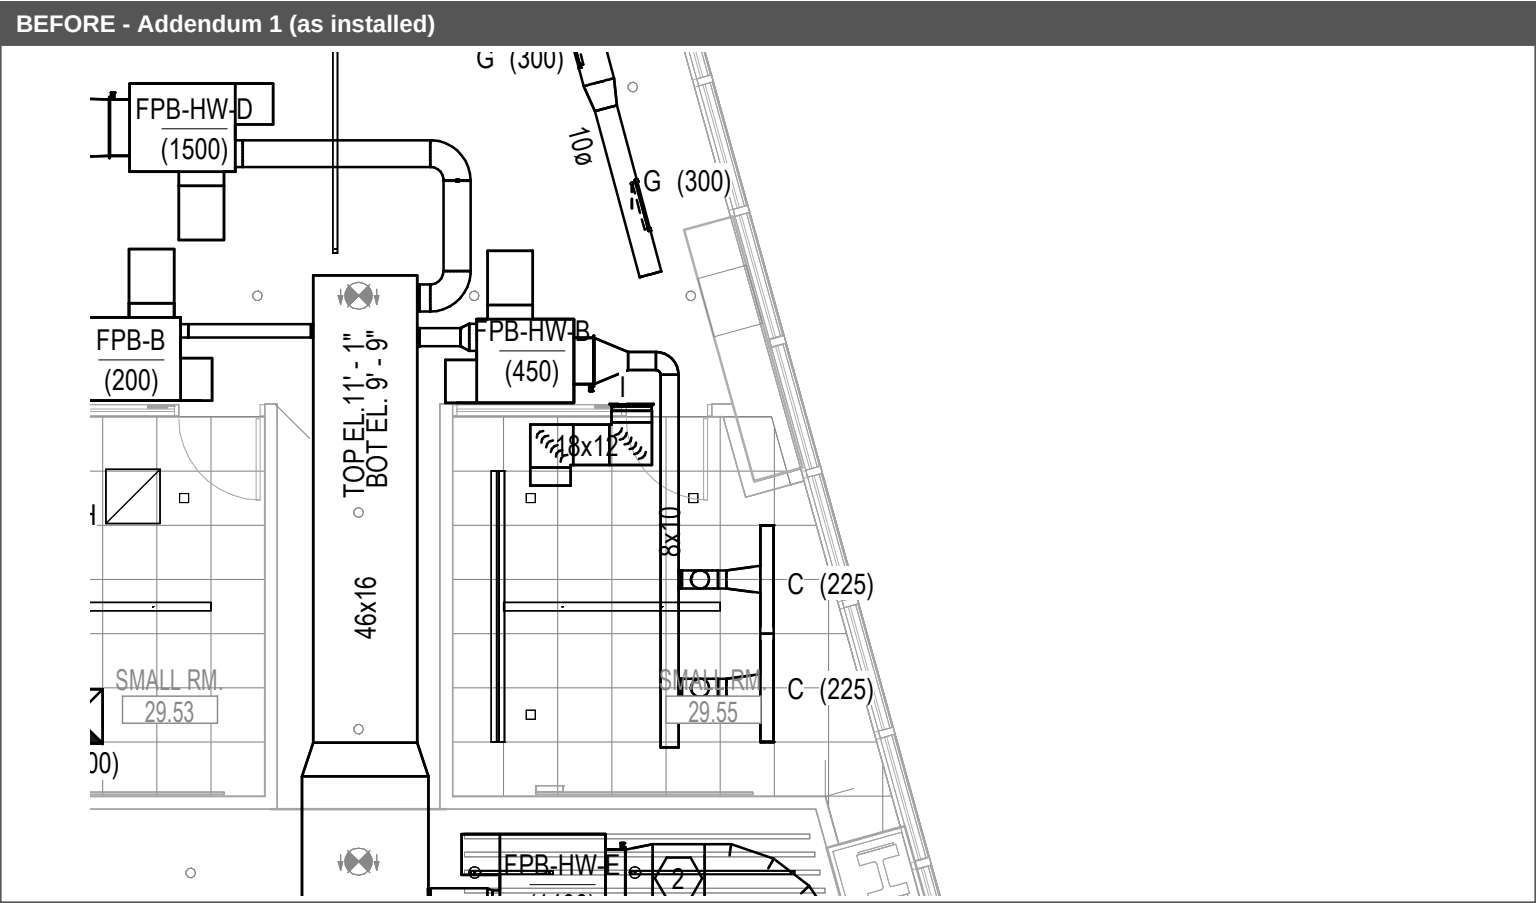


- Unchanged
- Addendum 1 only - installed, removed
- Bulletin 3 only - new work

Before (Addendum 1, installed): 46x16 supply main (approx. 20 LF, bottom el. 9'-9") with branch connections to FPB-HW-D (1500), FPB-HW-B (450) and FPB-B (200).

After (Bulletin 3): Main rerouted as 22x10 and 30x10 through (2) existing beam cuts, 30x10 aligned with the beam running plan northeast. New 14ø branch to FPB-HW-D, 10ø to FPB-HW-B and 6ø to FPB-B.

Work required: Disconnect and remove installed 46x16 section and branch connections. Fabricate and install 22x10 / 30x10 duct and round branches with insulation, reconnect terminal units.

Cost item	Qty	Unit	Rate	Amount
Disconnect / removal of installed ductwork, haul away (labor)	12	MH	\$125	\$1,500
Fabricated ductwork, fittings, insulation, accessories (material)	1	LS		\$6,075
Relocation / installation of ductwork (labor)	60	MH	\$125	\$7,500
Area 29-1 total				\$15,075

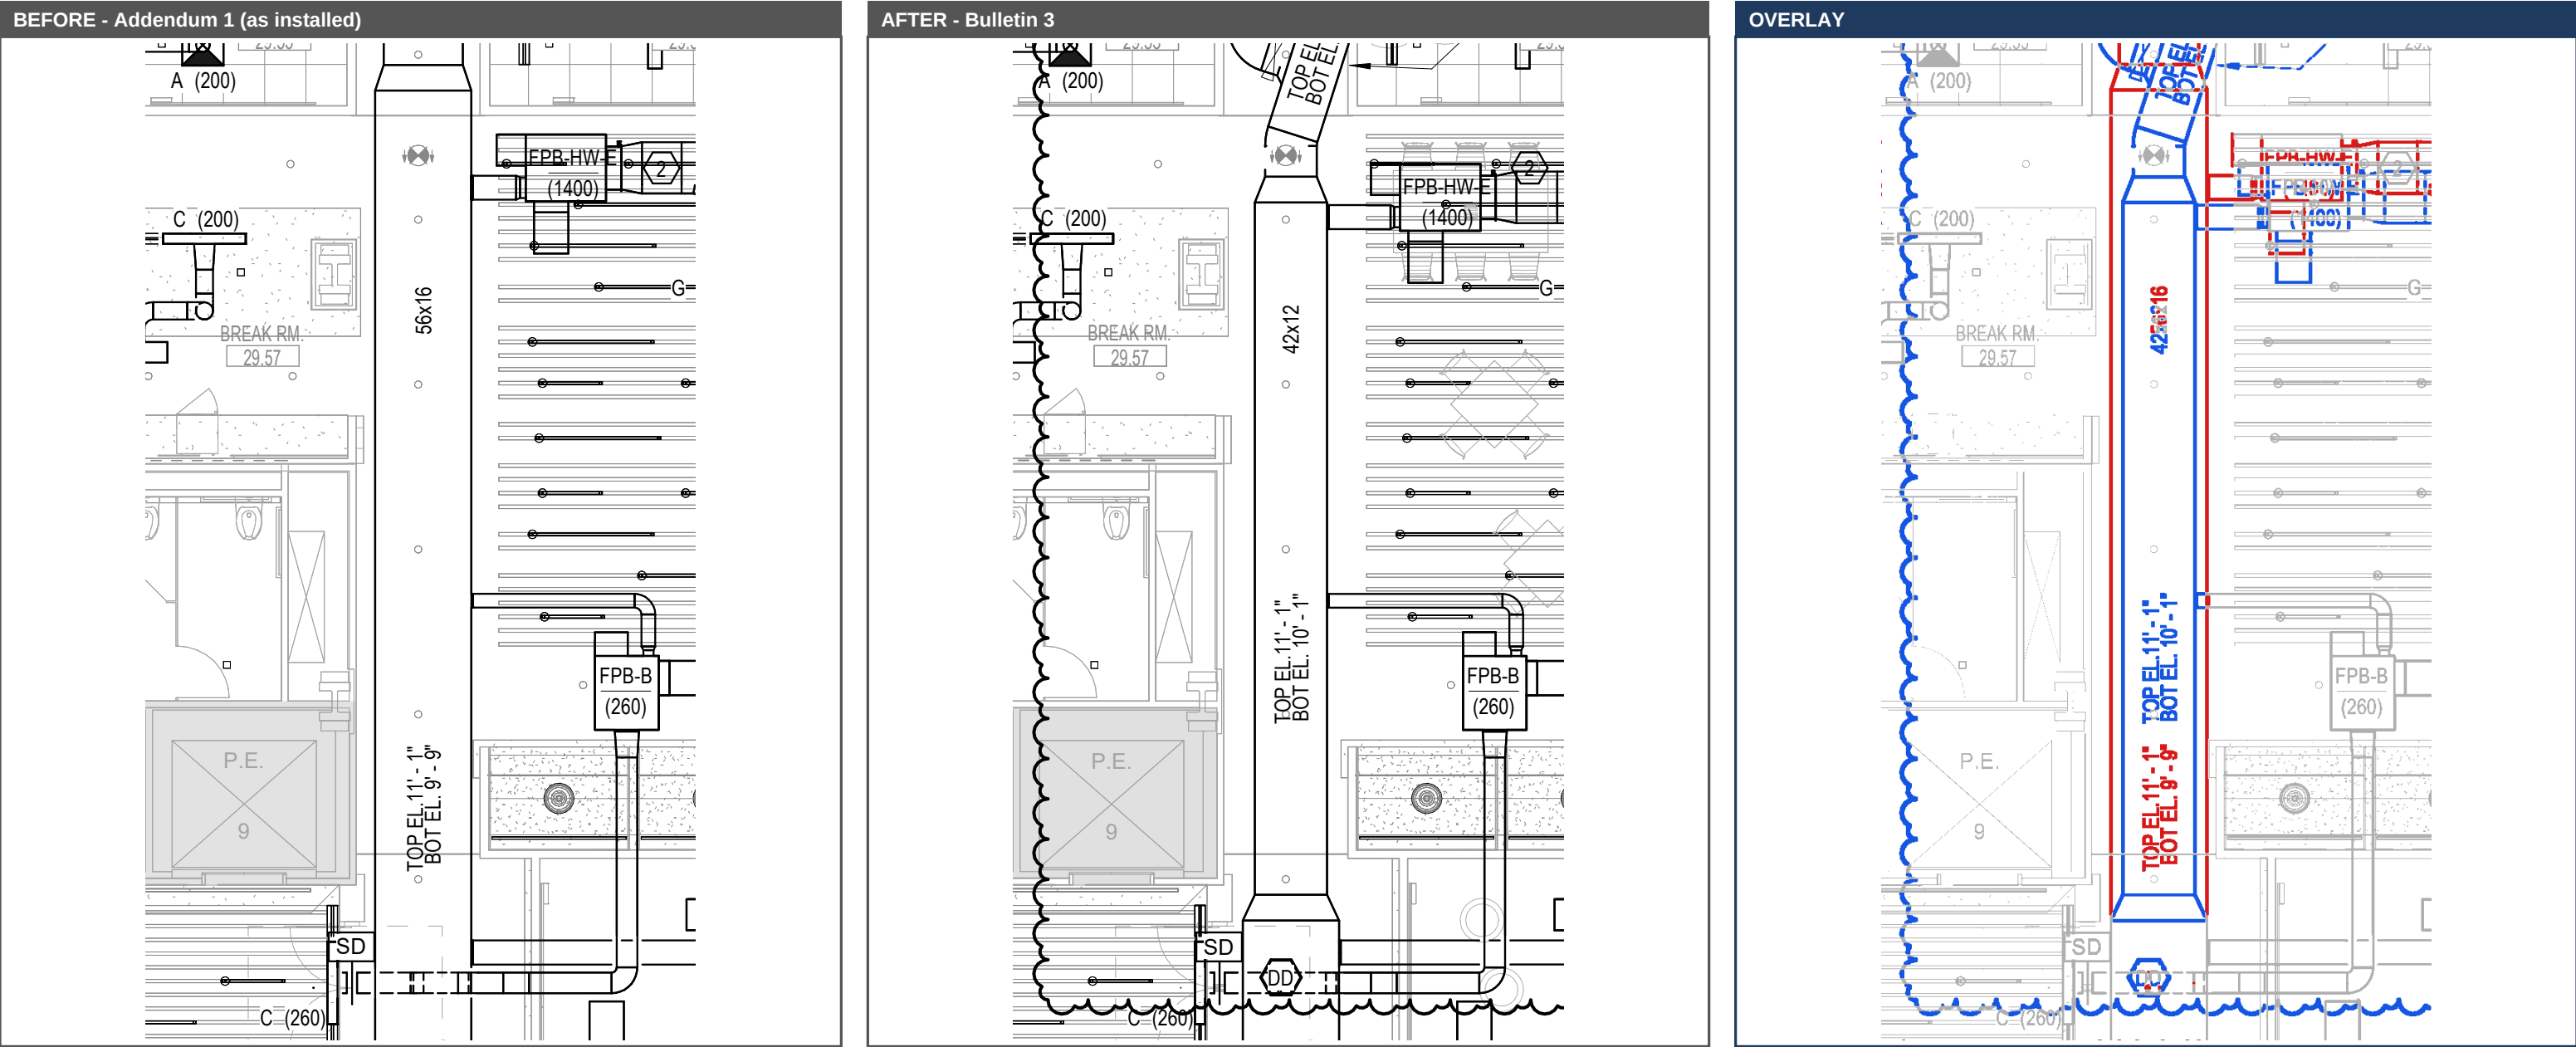

— Unchanged

— Addendum 1 only - installed, removed




— Bulletin 3 only - new work

Before (Addendum 1, installed): 56x16 supply main, approx. 44 LF, top el. 11'-1" / bottom el. 9'-9", Break Rm 29.57 to P.E.

After (Bulletin 3): Main resized to 42x12 on the same route, top el. 11'-1" / bottom el. 10'-1".

Work required: Disconnect and remove installed 56x16 main. Fabricate and install 42x12 main with insulation, reconnect branch takeoffs (FPB-HW-E, FPB-B (260)).

Cost item	Qty	Unit	Rate	Amount
Disconnect / removal of installed ductwork, haul away (labor)	7	MH	\$125	\$875
Fabricated ductwork, fittings, insulation, accessories (material)	1	LS		\$3,900
Relocation / installation of ductwork (labor)	50	MH	\$125	\$6,250
Area 29-2 total				\$11,025

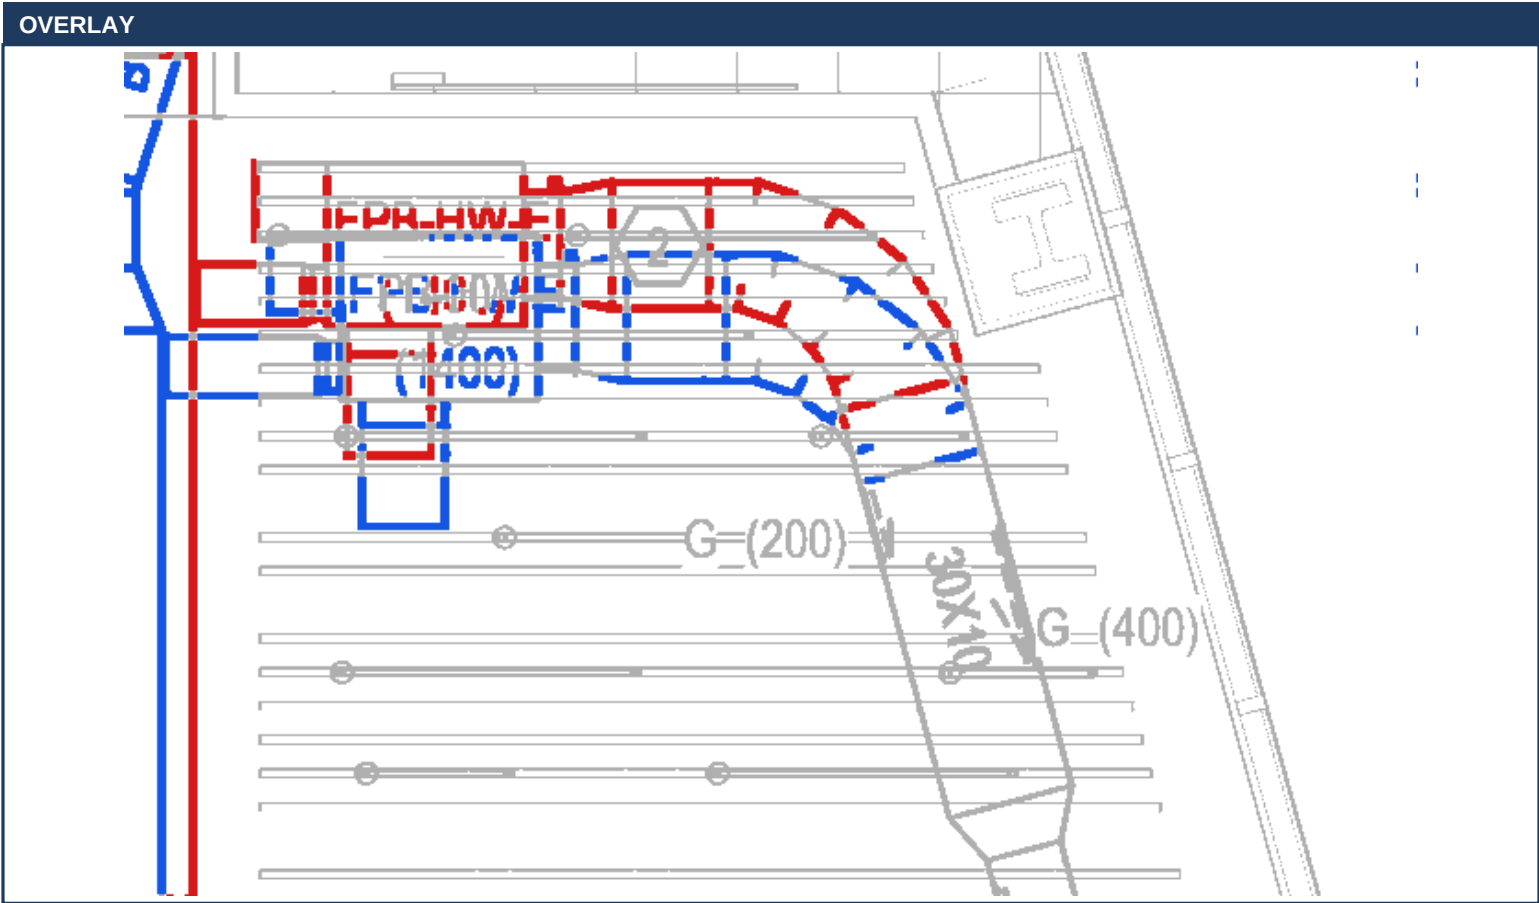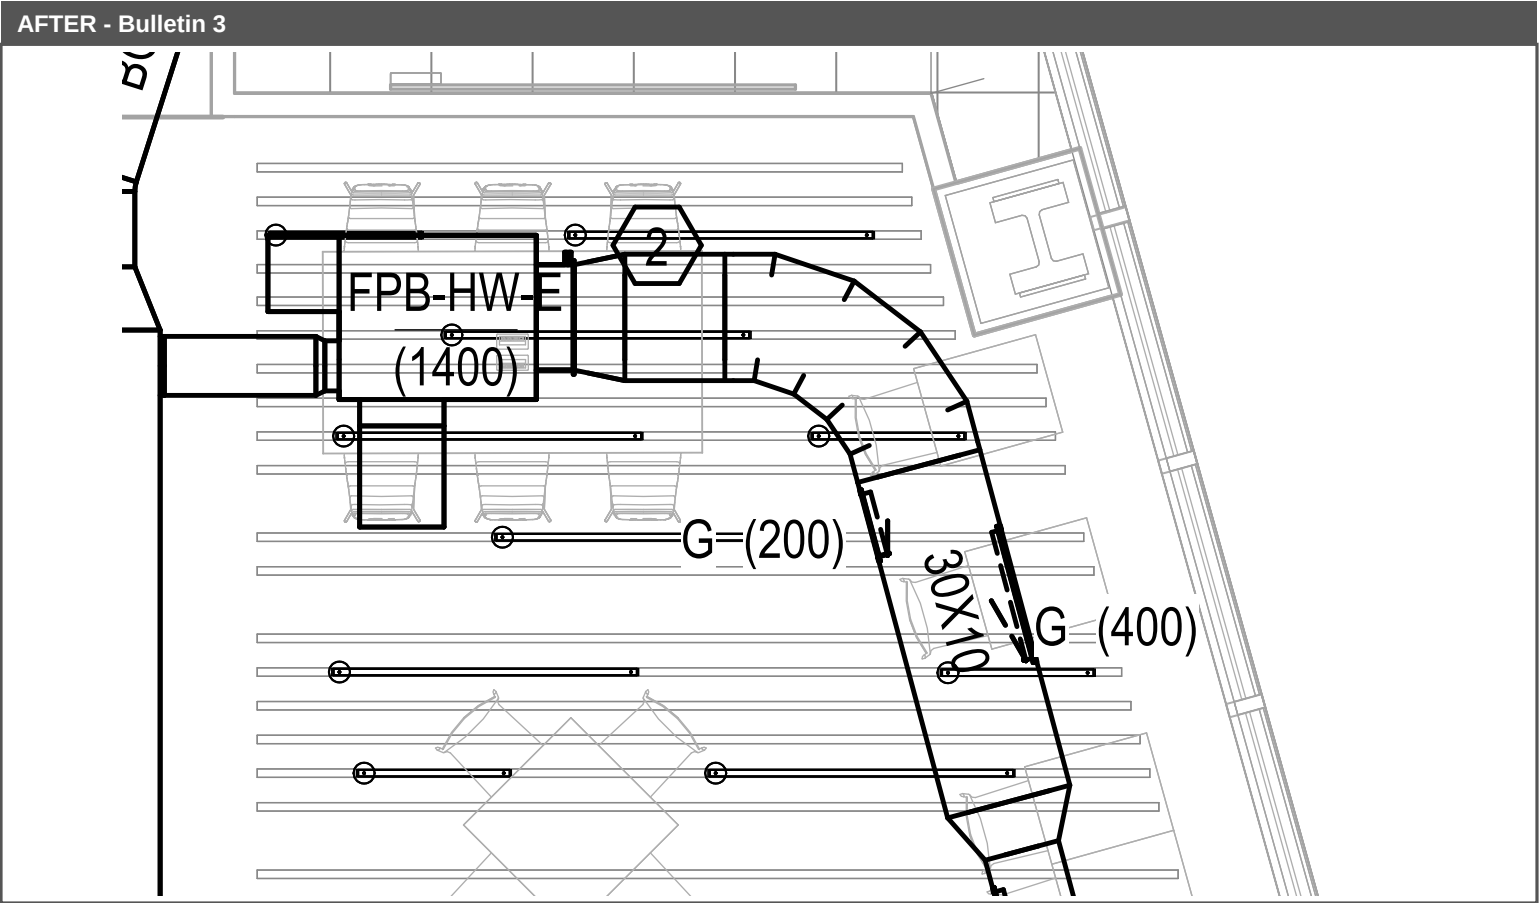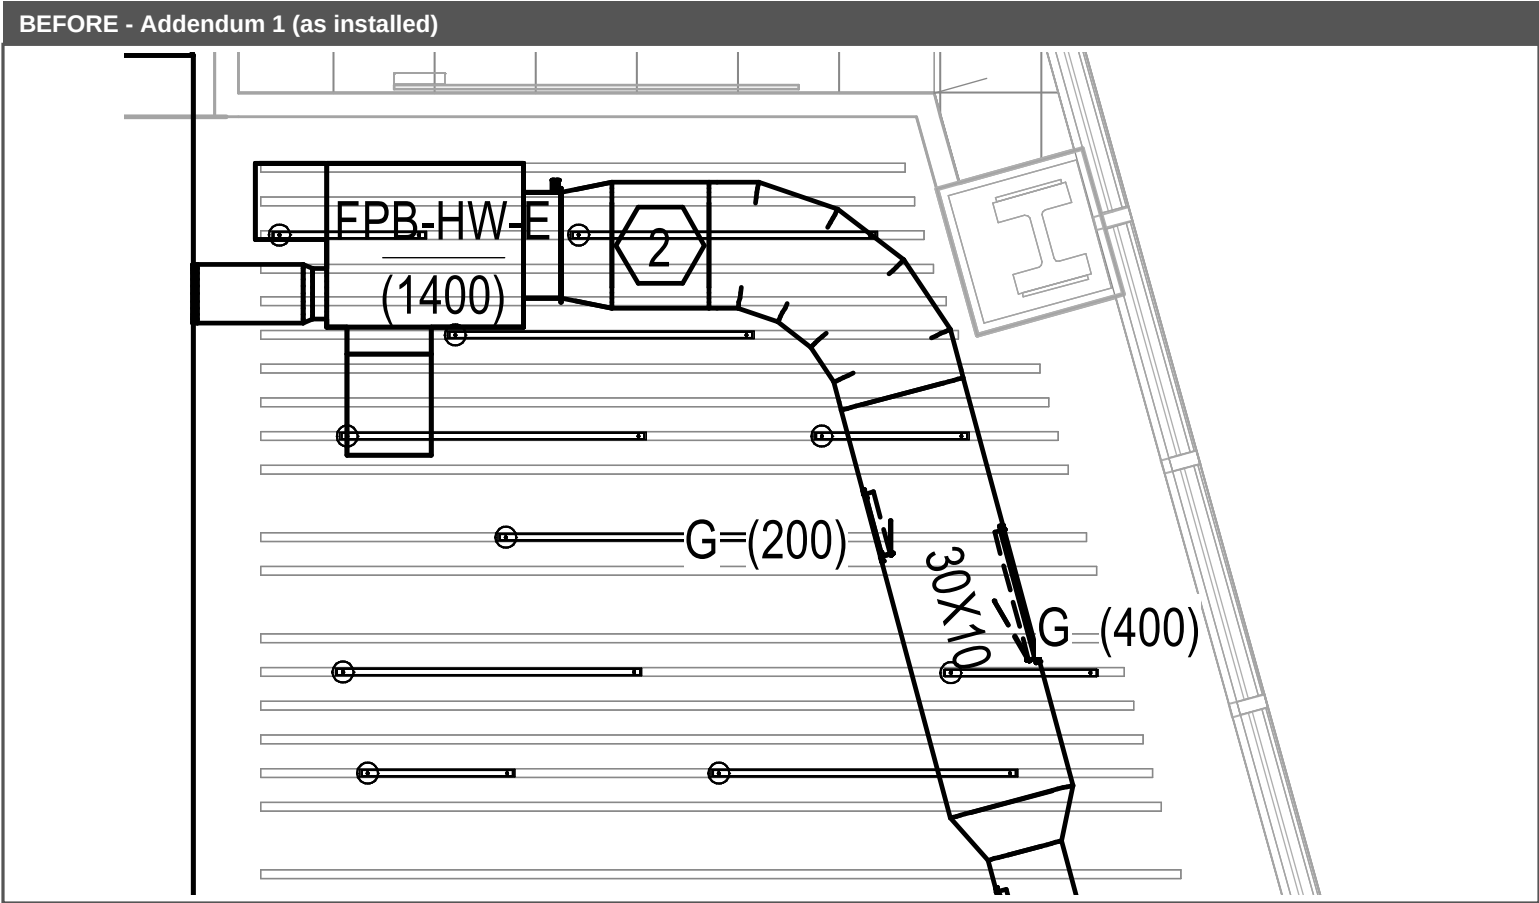

- Unchanged
- Addendum 1 only - installed, removed
- Bulletin 3 only - new work

Before (Addendum 1, installed): FPB-HW-E (1400) with inlet and 30x10 discharge to the G(400) / G(200) linear diffusers along the northeast wall.

After (Bulletin 3): FPB-HW-E relocated; inlet connection and 30x10 discharge elbow rerouted.


Work required: Disconnect inlet and discharge, relocate and rehang FPB-HW-E, fabricate and install new inlet and 30x10 discharge fittings, reconnect.

Cost item	Qty	Unit	Rate	Amount
Disconnect / removal of installed ductwork, haul away (labor)	2	MH	\$125	\$250
Fabricated ductwork, fittings, insulation, accessories (material)	1	LS		\$750
Relocation / installation of ductwork (labor)	12	MH	\$125	\$1,500
Area 29-3 total				\$2,500

30th Floor - M-530.00: Addendum 1 vs Bulletin 3 overlay

Gray = unchanged Red = Addendum 1 only (installed, removed) Blue = Bulletin 3 only (new) Numbered boxes = change areas, see detail pages


Snowflake Fitout - 7 Times Square, Floors 29-31 | COP-SF-05 Bulletin 3 Revision

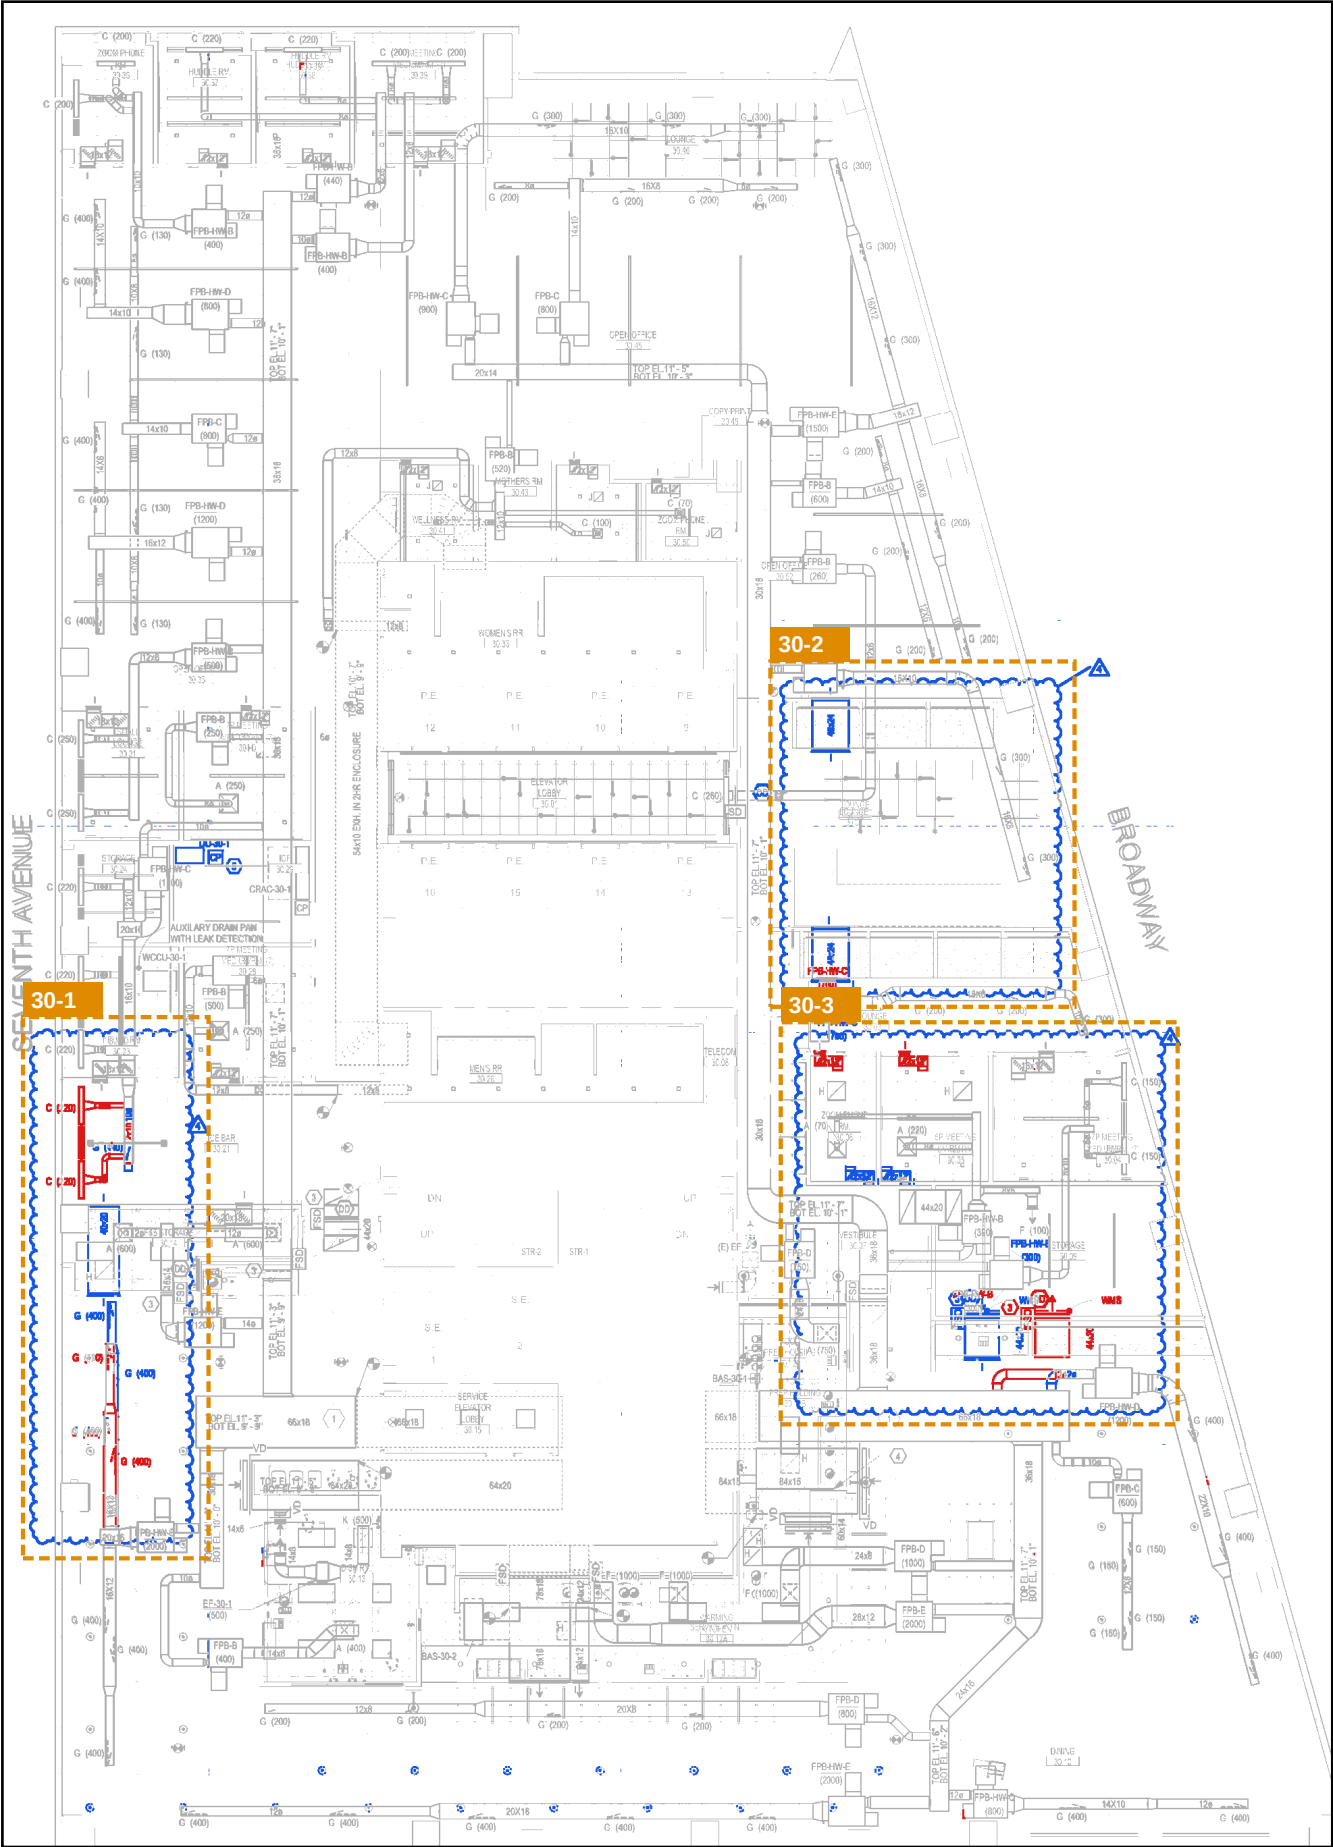

30th floor - cost by area

Area	Description	Disconnect	Material	Labor	Total
30-1	IT Build Rm 30.23 / F&B Storage 30.14 / west dining	\$750	\$2,200	\$3,750	\$6,700
30-2	Lounge 30.02 - new transfer ducts	-	\$2,150	\$3,250	\$5,400
30-3	Meeting Rms 30.04 / 30.05, Storage 30.09, Vestibule 30.07	\$2,000	-	\$3,000	\$5,000
	Shop drawings for revised design				\$1,000
30th floor total		\$2,750	\$4,350	\$10,000	\$18,100

Disconnect = disconnect / removal labor of installed Addendum 1 work incl. haul away and clean up. Material = fabricated ductwork, fittings, insulation, accessories and air outlets. Labor = relocation / installation of ductwork, terminal units and air outlets.

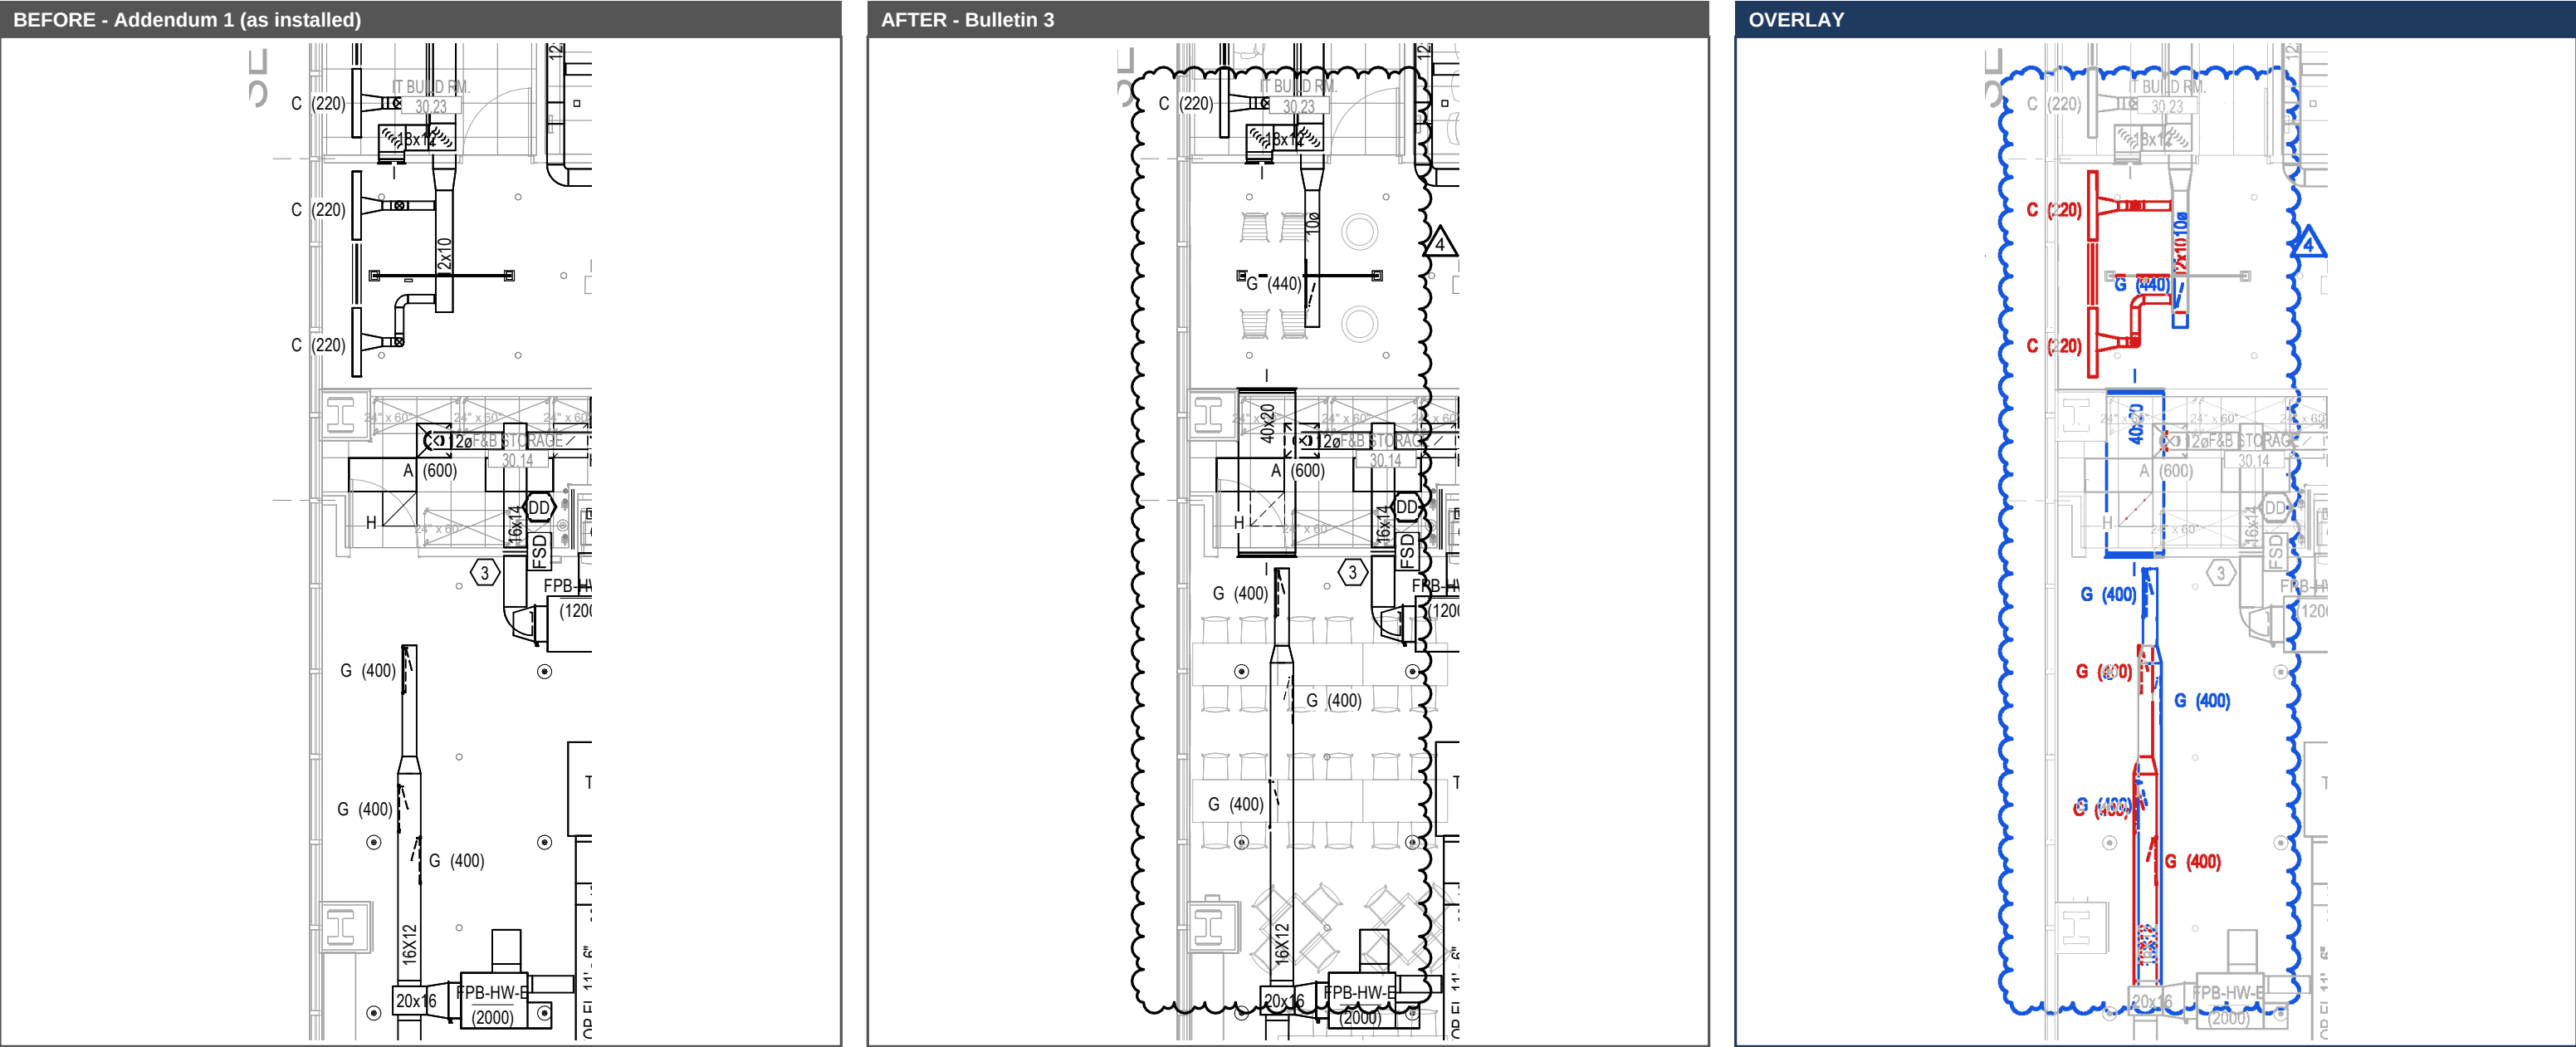

- Unchanged
- Addendum 1 only - installed, removed
- Bulletin 3 only - new work

Before (Addendum 1, installed): 12x10 branch with (2) C(220) ceiling diffusers; G(400) linear diffuser run on 16x12 branch.


After (Bulletin 3): 12x10 branch and (2) C(220) deleted, replaced with 10ø branch to (1) new G(440) linear diffuser. New 40x20 transfer duct at F&B Storage 30.14. G(400) linear diffusers relocated along the 16x12 branch.

Work required: Disconnect and remove 12x10 branch and (2) C(220). Install 10ø branch, 40x20 transfer duct, rework 16x12 branch. F&I G(440) linear diffuser with plenum, relocate G(400) diffusers.

Cost item	Qty	Unit	Rate	Amount
Disconnect / removal of installed ductwork, haul away (labor)	6	MH	\$125	\$750
Fabricated ductwork, fittings, insulation, accessories (material)	1	LS		\$1,700
Installation of ductwork (labor)	30	MH	\$125	\$3,750
Air outlets (material)	1	LS		\$500
Area 30-1 total				\$6,700

Area 30-2 - Lounge 30.02 - new transfer ducts


30th floor, M-530.00 | Before = Addendum 1 After = Bulletin 3 (rev 4, 08/10/2026)

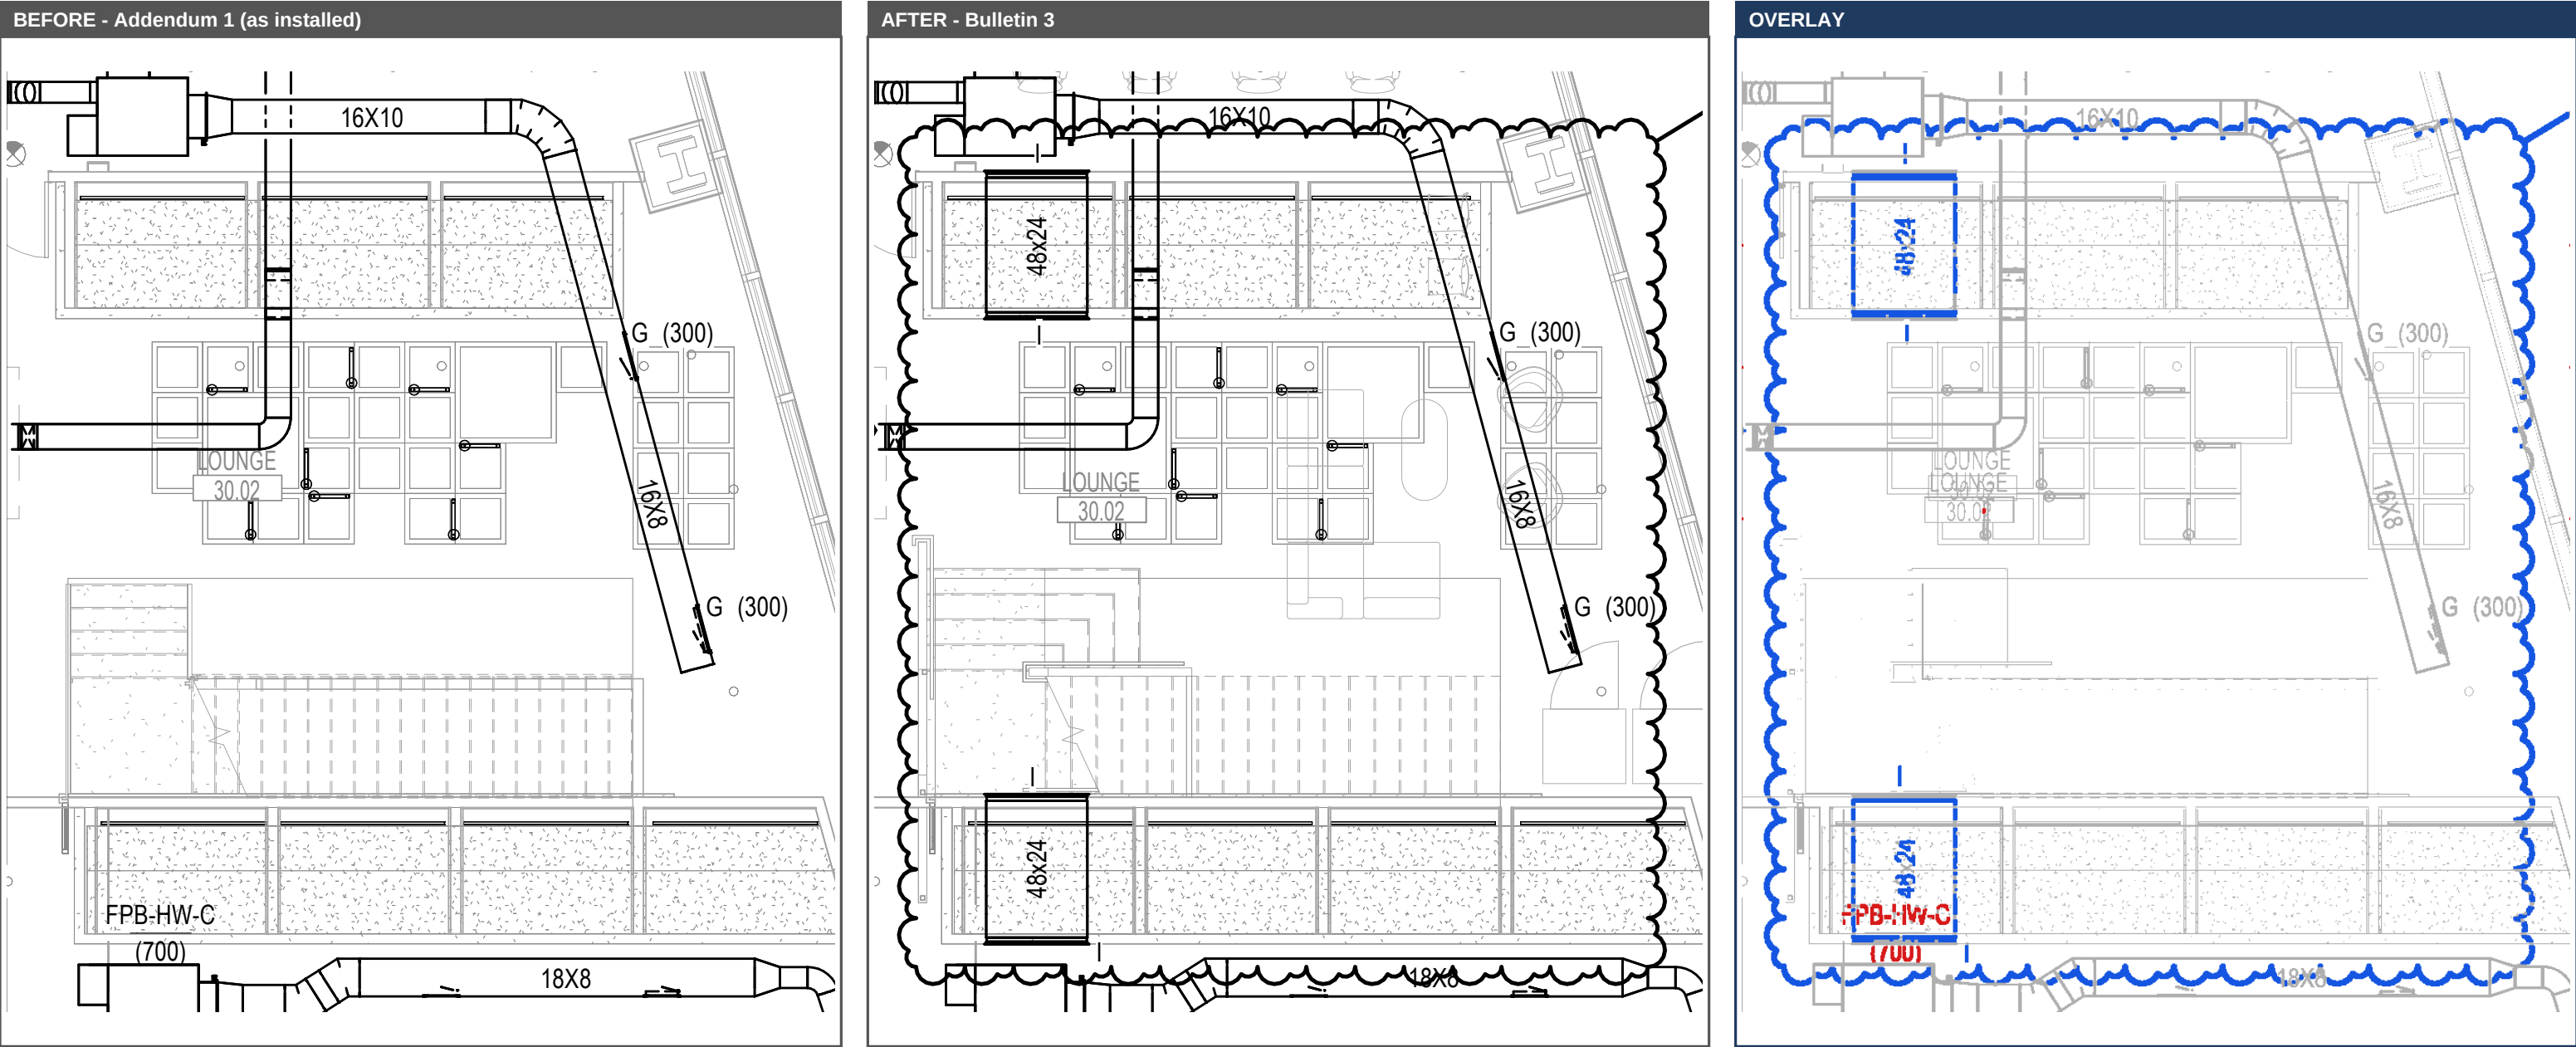


Before (Addendum 1, installed): No transfer ducts at Lounge 30.02 walls.

After (Bulletin 3): (2) new 48x24 transfer ducts.

Work required: Fabricate and install (2) 48x24 lined transfer ducts.

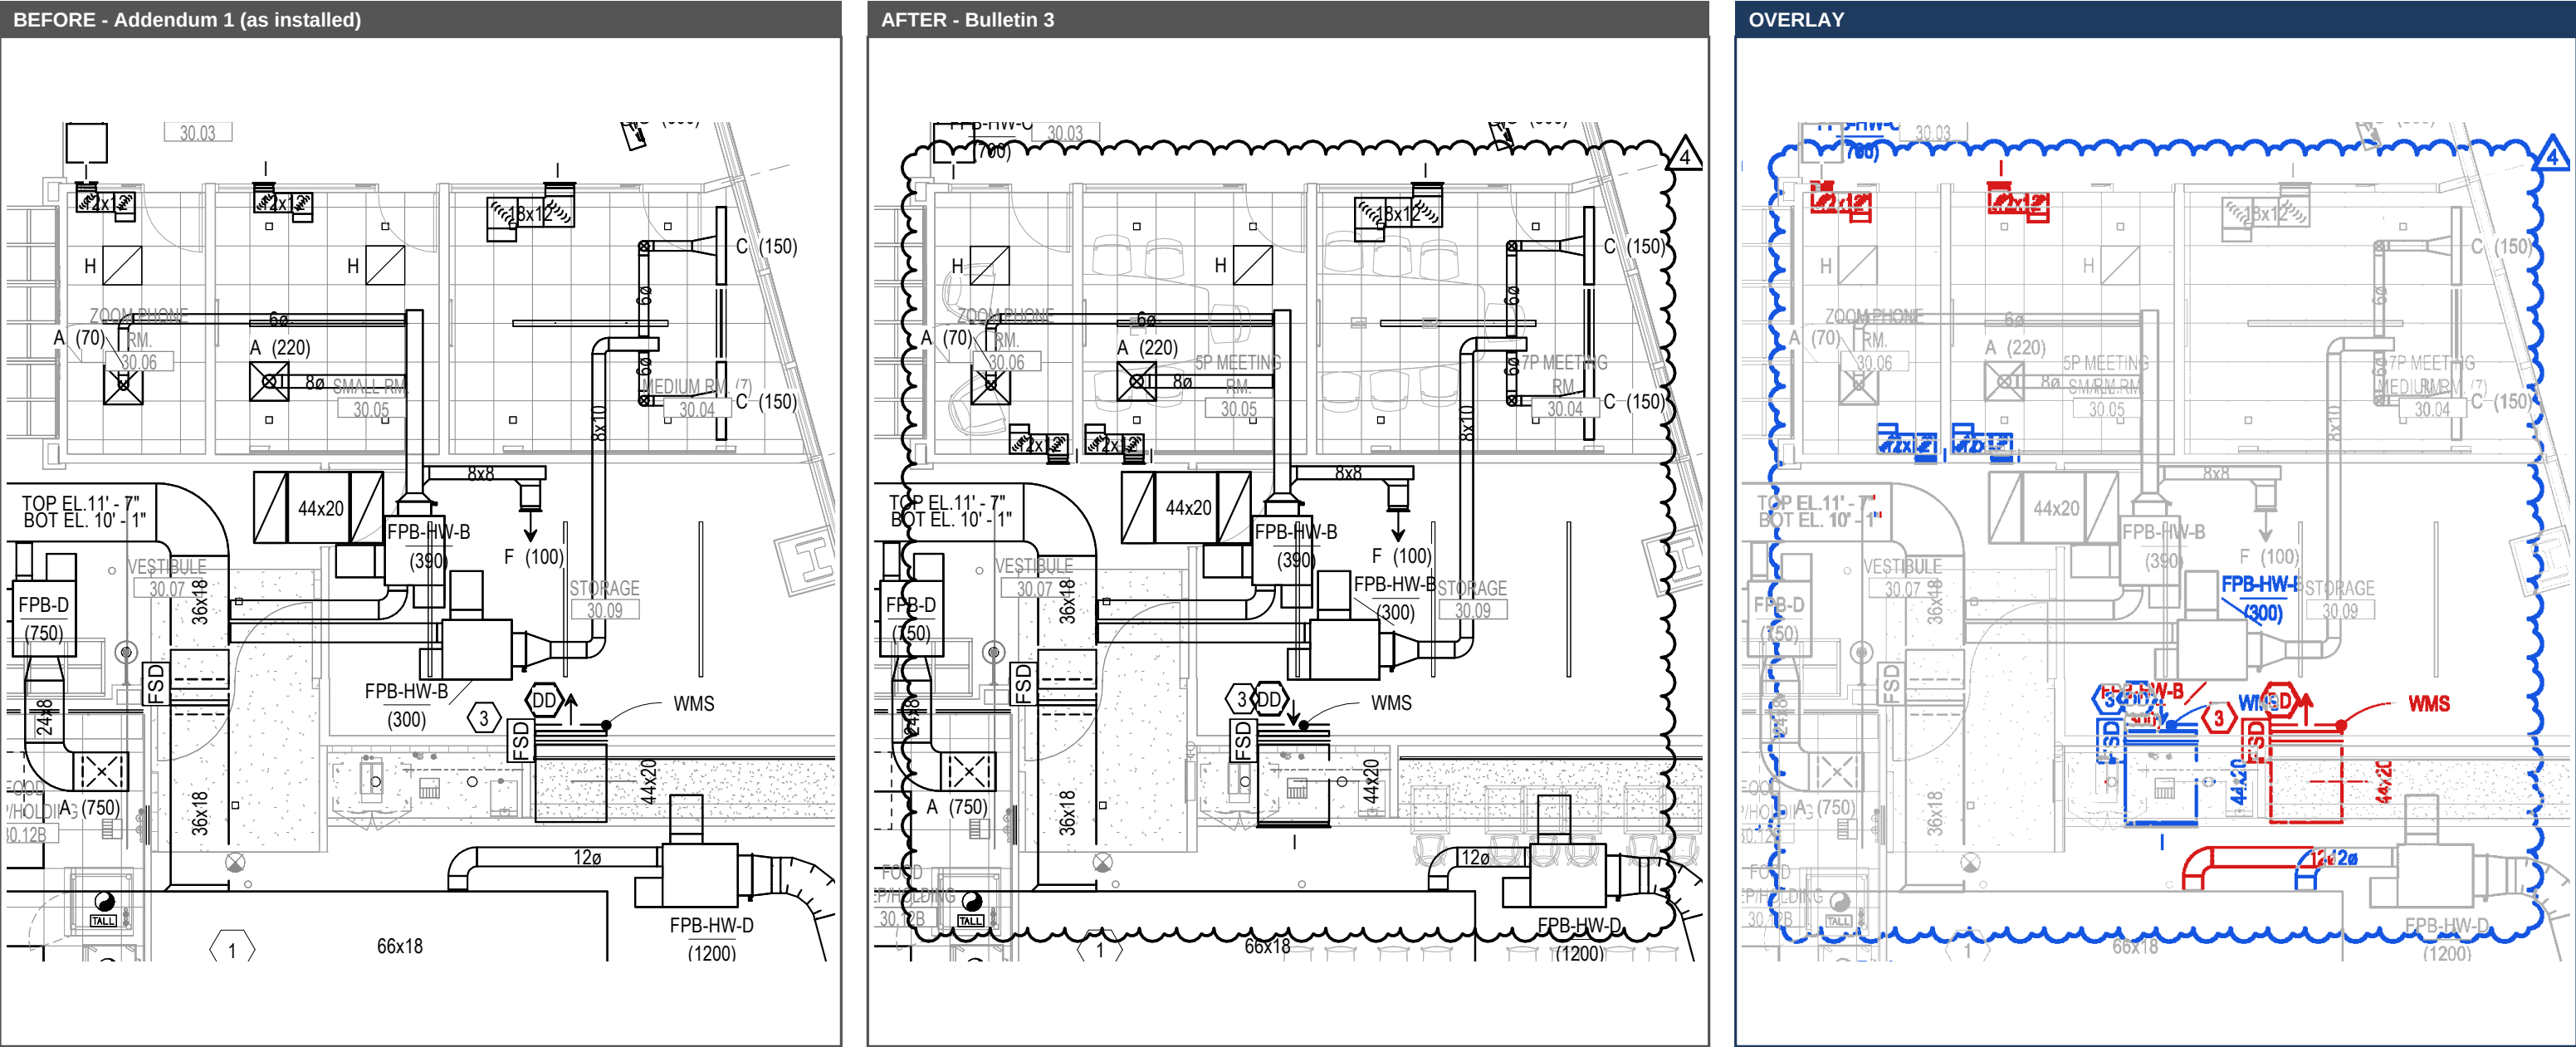




Cost item	Qty	Unit	Rate	Amount
Disconnect / removal of installed ductwork, haul away (labor)	16	MH	\$125	\$2,000
Relocation / installation of ductwork (labor)	24	MH	\$125	\$3,000
Area 30-3 total				\$5,000

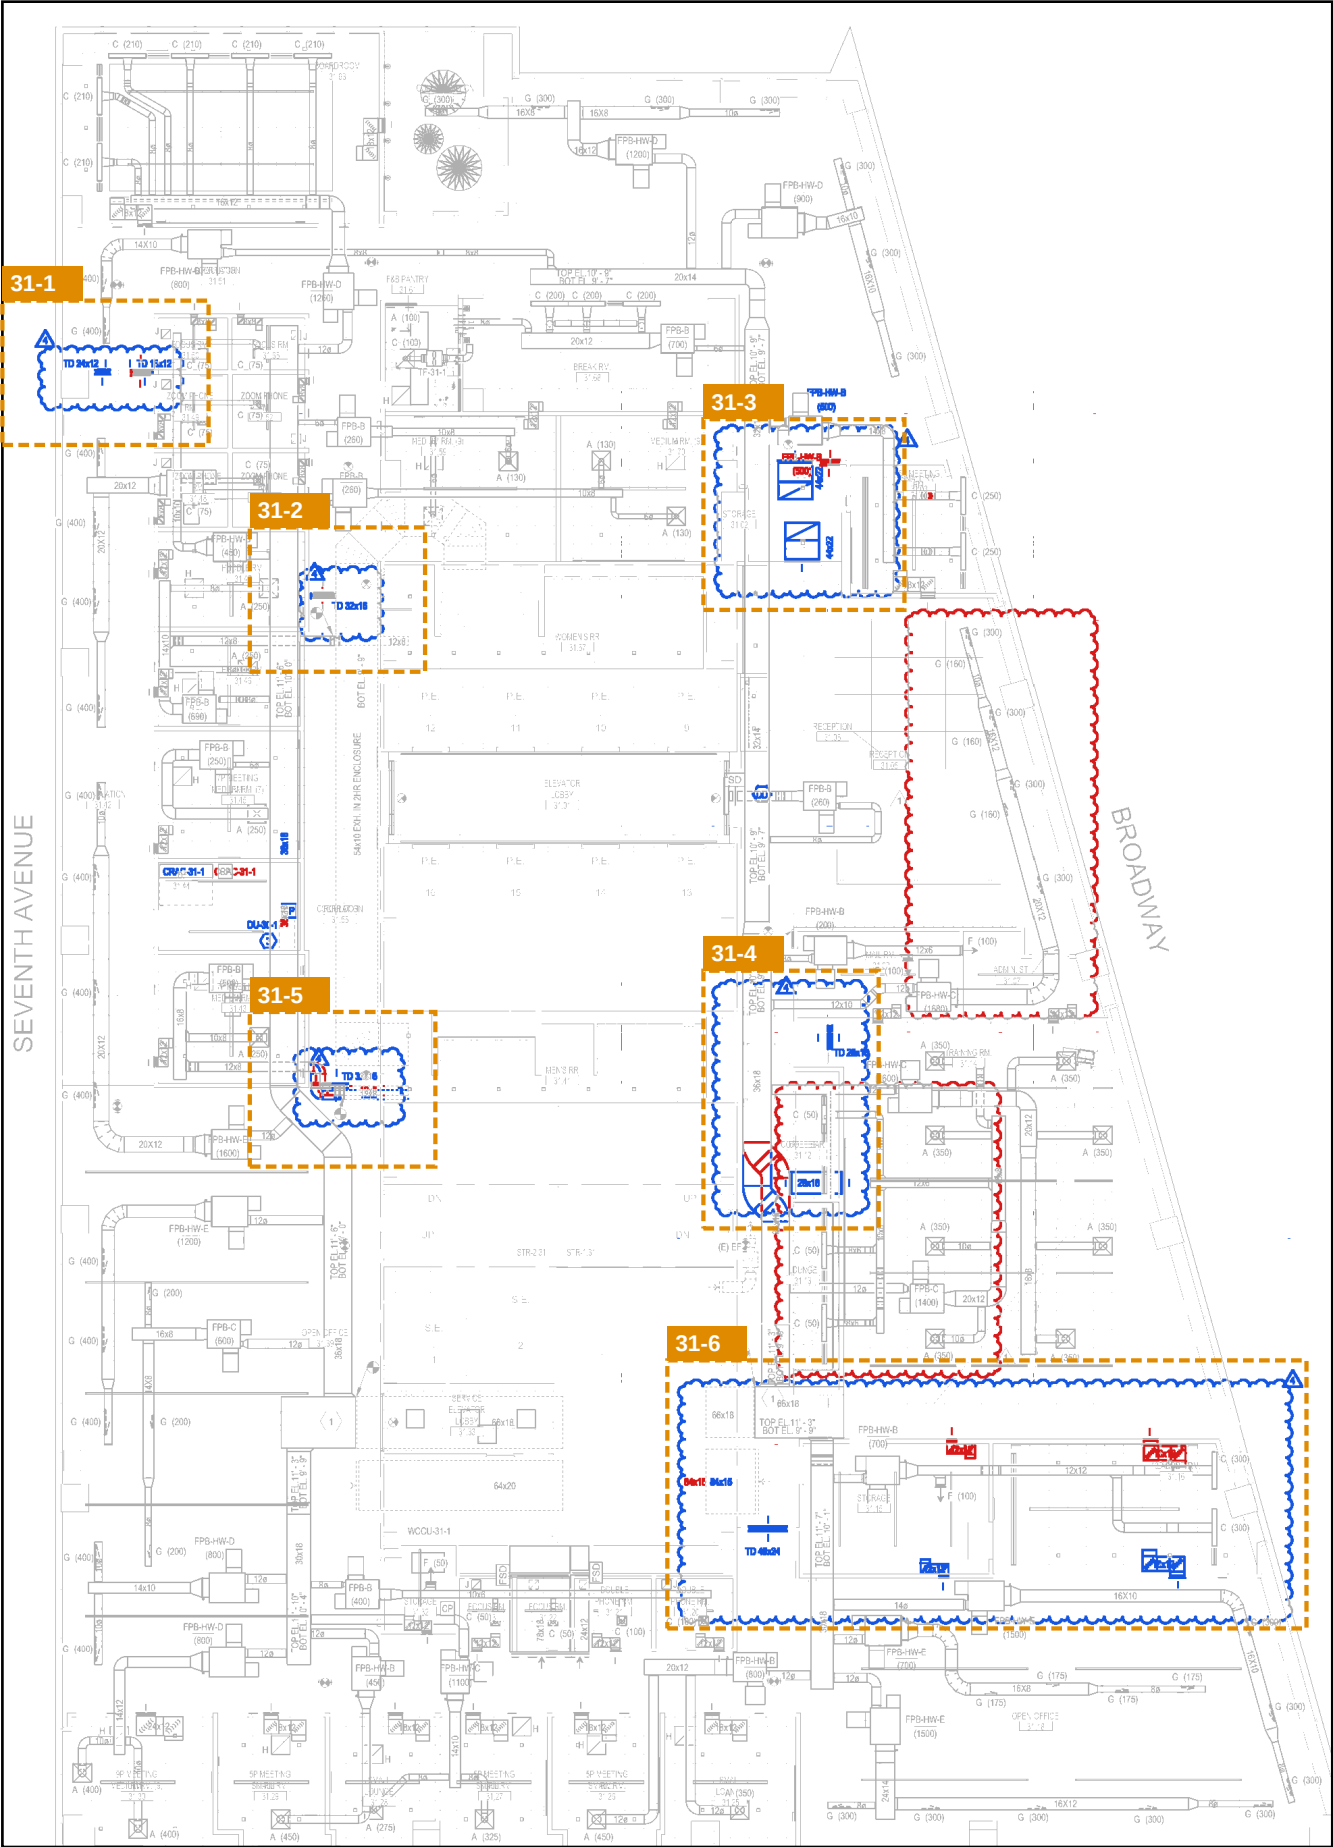

31th floor - cost by area

Area	Description	Disconnect	Material	Labor	Total
31-1	Zoom rooms, northwest - transfer ducts	\$125	\$330	\$750	\$1,205
31-2	Transfer duct TD 32x16, north	\$125	\$300	\$625	\$1,050
31-3	Storage 31.02 - new transfer ducts	\$500	\$1,700	\$2,500	\$4,700
31-4	Coffee Bar 31.12 - transfer ducts and main fitting	\$750	\$1,700	\$2,750	\$5,200
31-5	Transfer duct TD 32x16, southwest	\$250	\$650	\$2,000	\$2,900
31-6	Storage 31.15 / Room 31.16, southeast	\$375	\$1,150	\$1,500	\$3,025
	Shop drawings for revised design				\$1,000
	31th floor total	\$2,125	\$5,830	\$10,125	\$19,080

Disconnect = disconnect / removal labor of installed Addendum 1 work incl. haul away and clean up. Material = fabricated ductwork, fittings, insulation, accessories and air outlets. Labor = relocation / installation of ductwork, terminal units and air outlets.

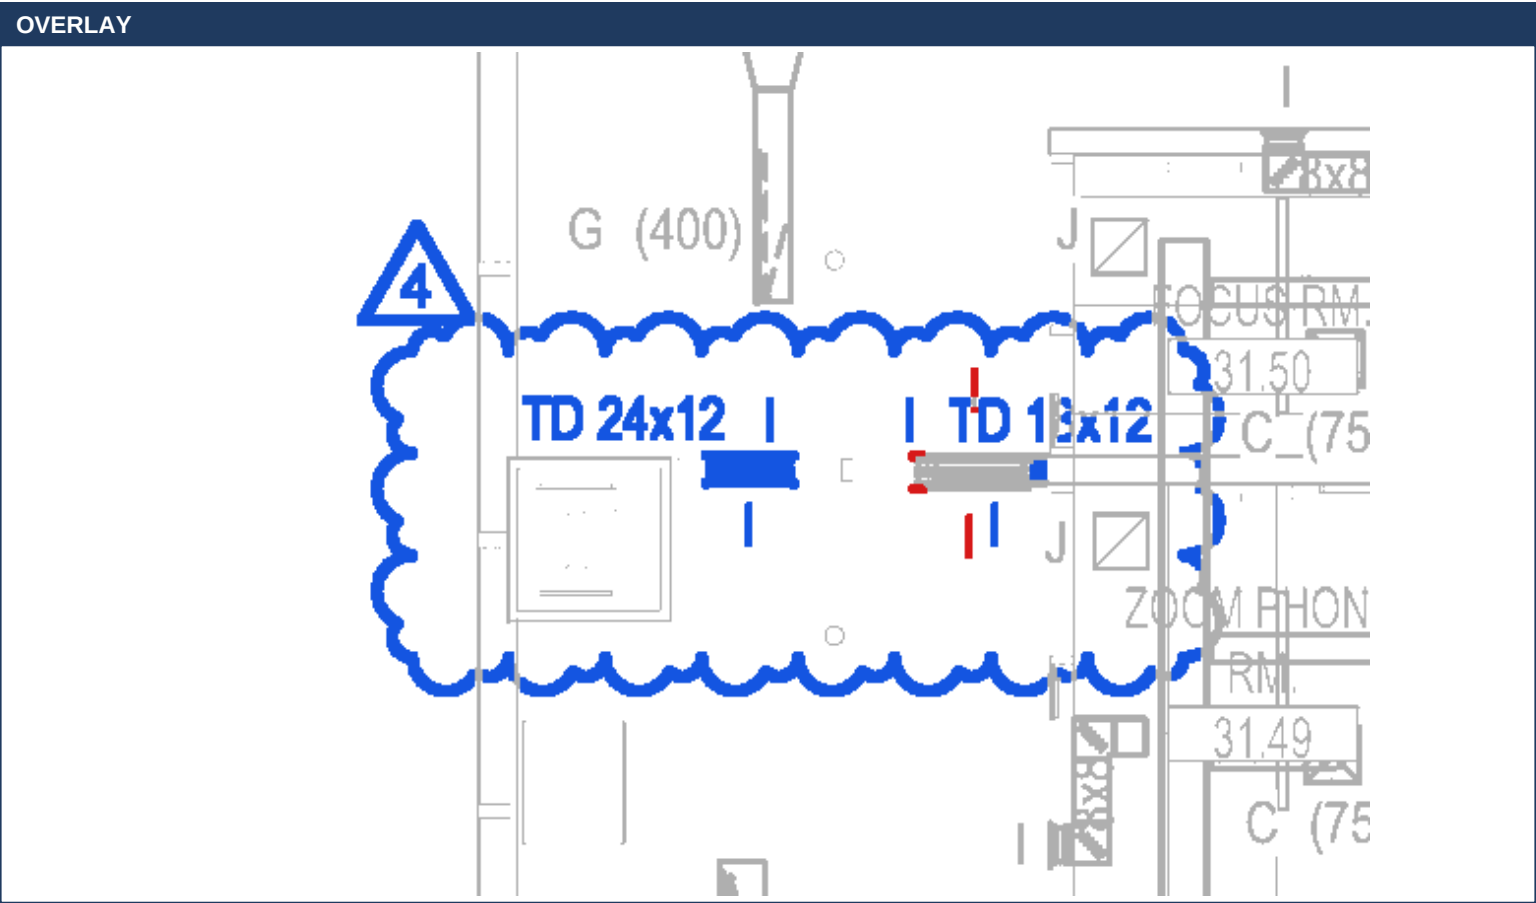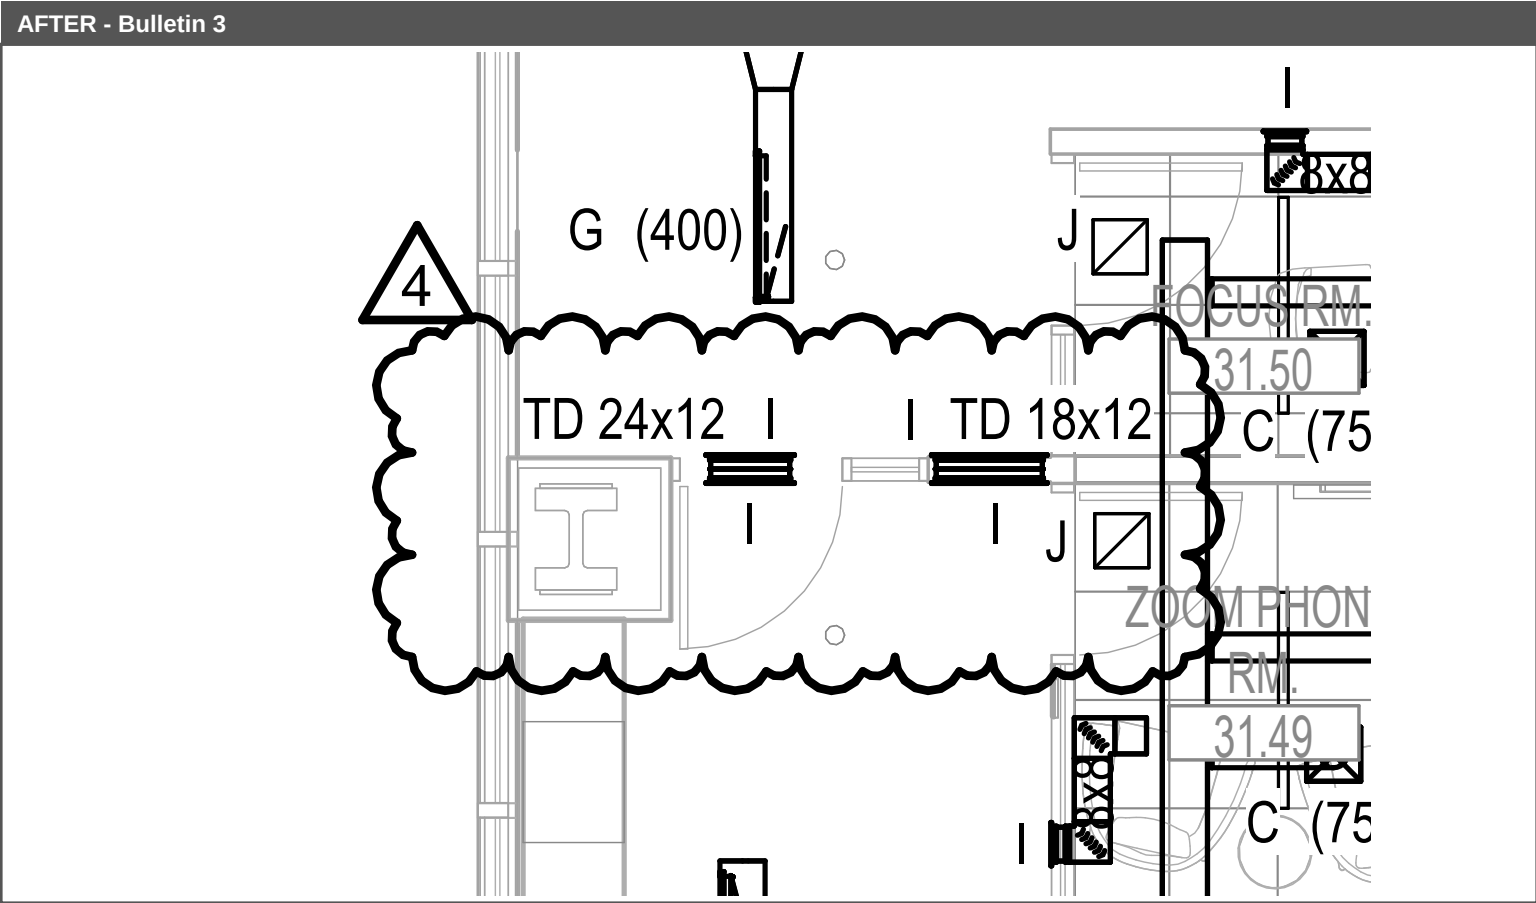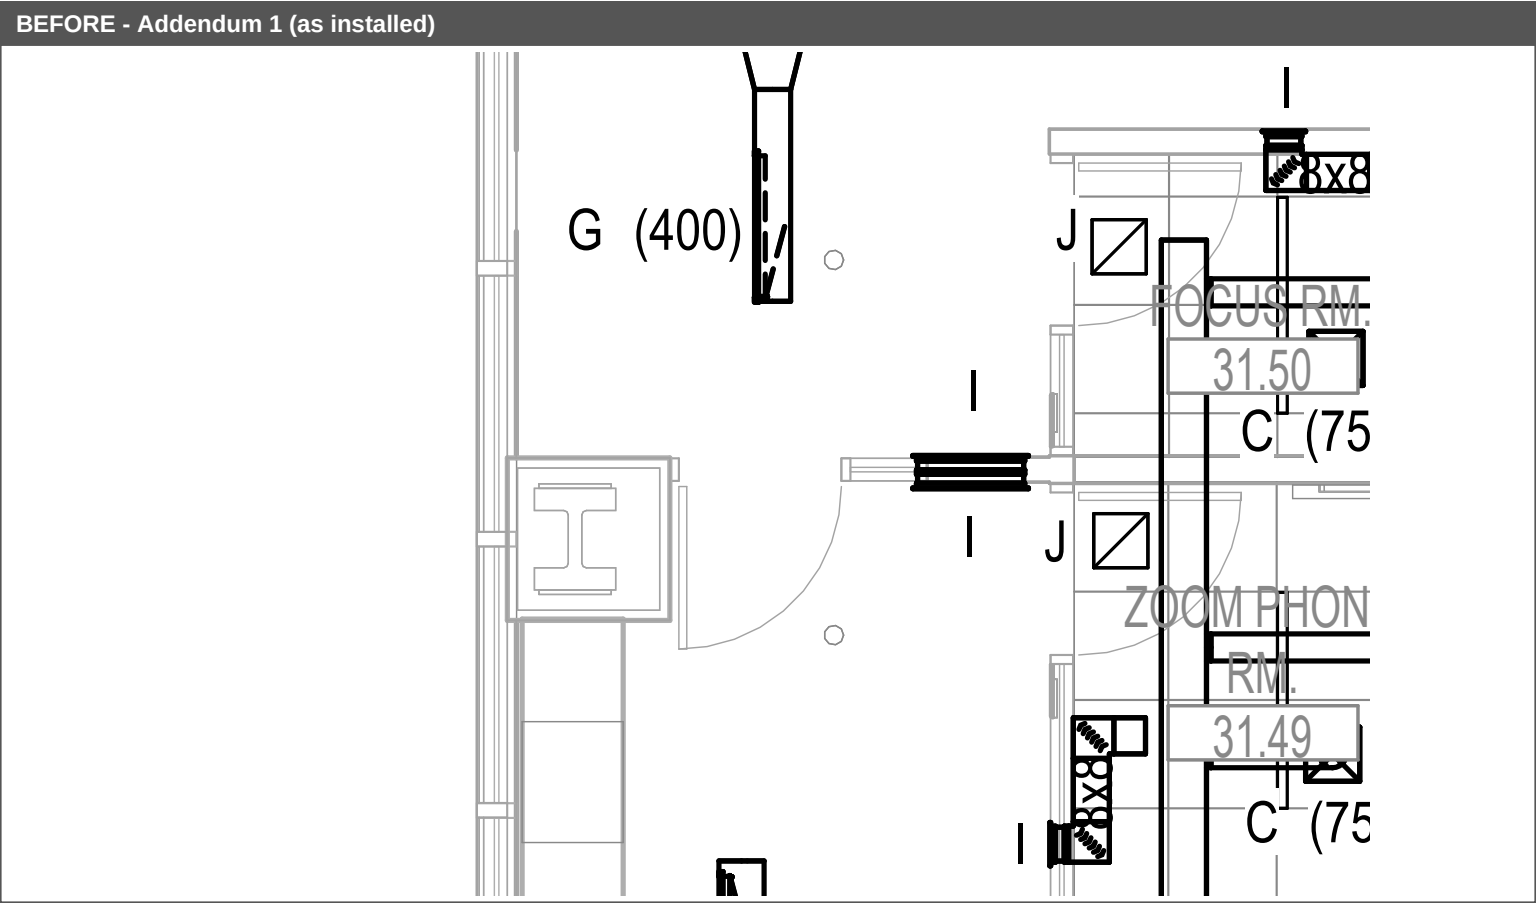


- Unchanged
- Addendum 1 only - installed, removed
- Bulletin 3 only - new work

Before (Addendum 1, installed): (1) transfer duct (not sized on Addendum 1).

After (Bulletin 3): TD 24x12 and new TD 18x12.

Work required: Remove existing transfer duct; fabricate and install TD 24x12 and TD 18x12.

Cost item	Qty	Unit	Rate	Amount
Disconnect / removal of installed ductwork, haul away (labor)	1	MH	\$125	\$125
Fabricated ductwork, fittings, insulation, accessories (material)	1	LS		\$330
Relocation / installation of ductwork (labor)	6	MH	\$125	\$750
Area 31-1 total				\$1,205

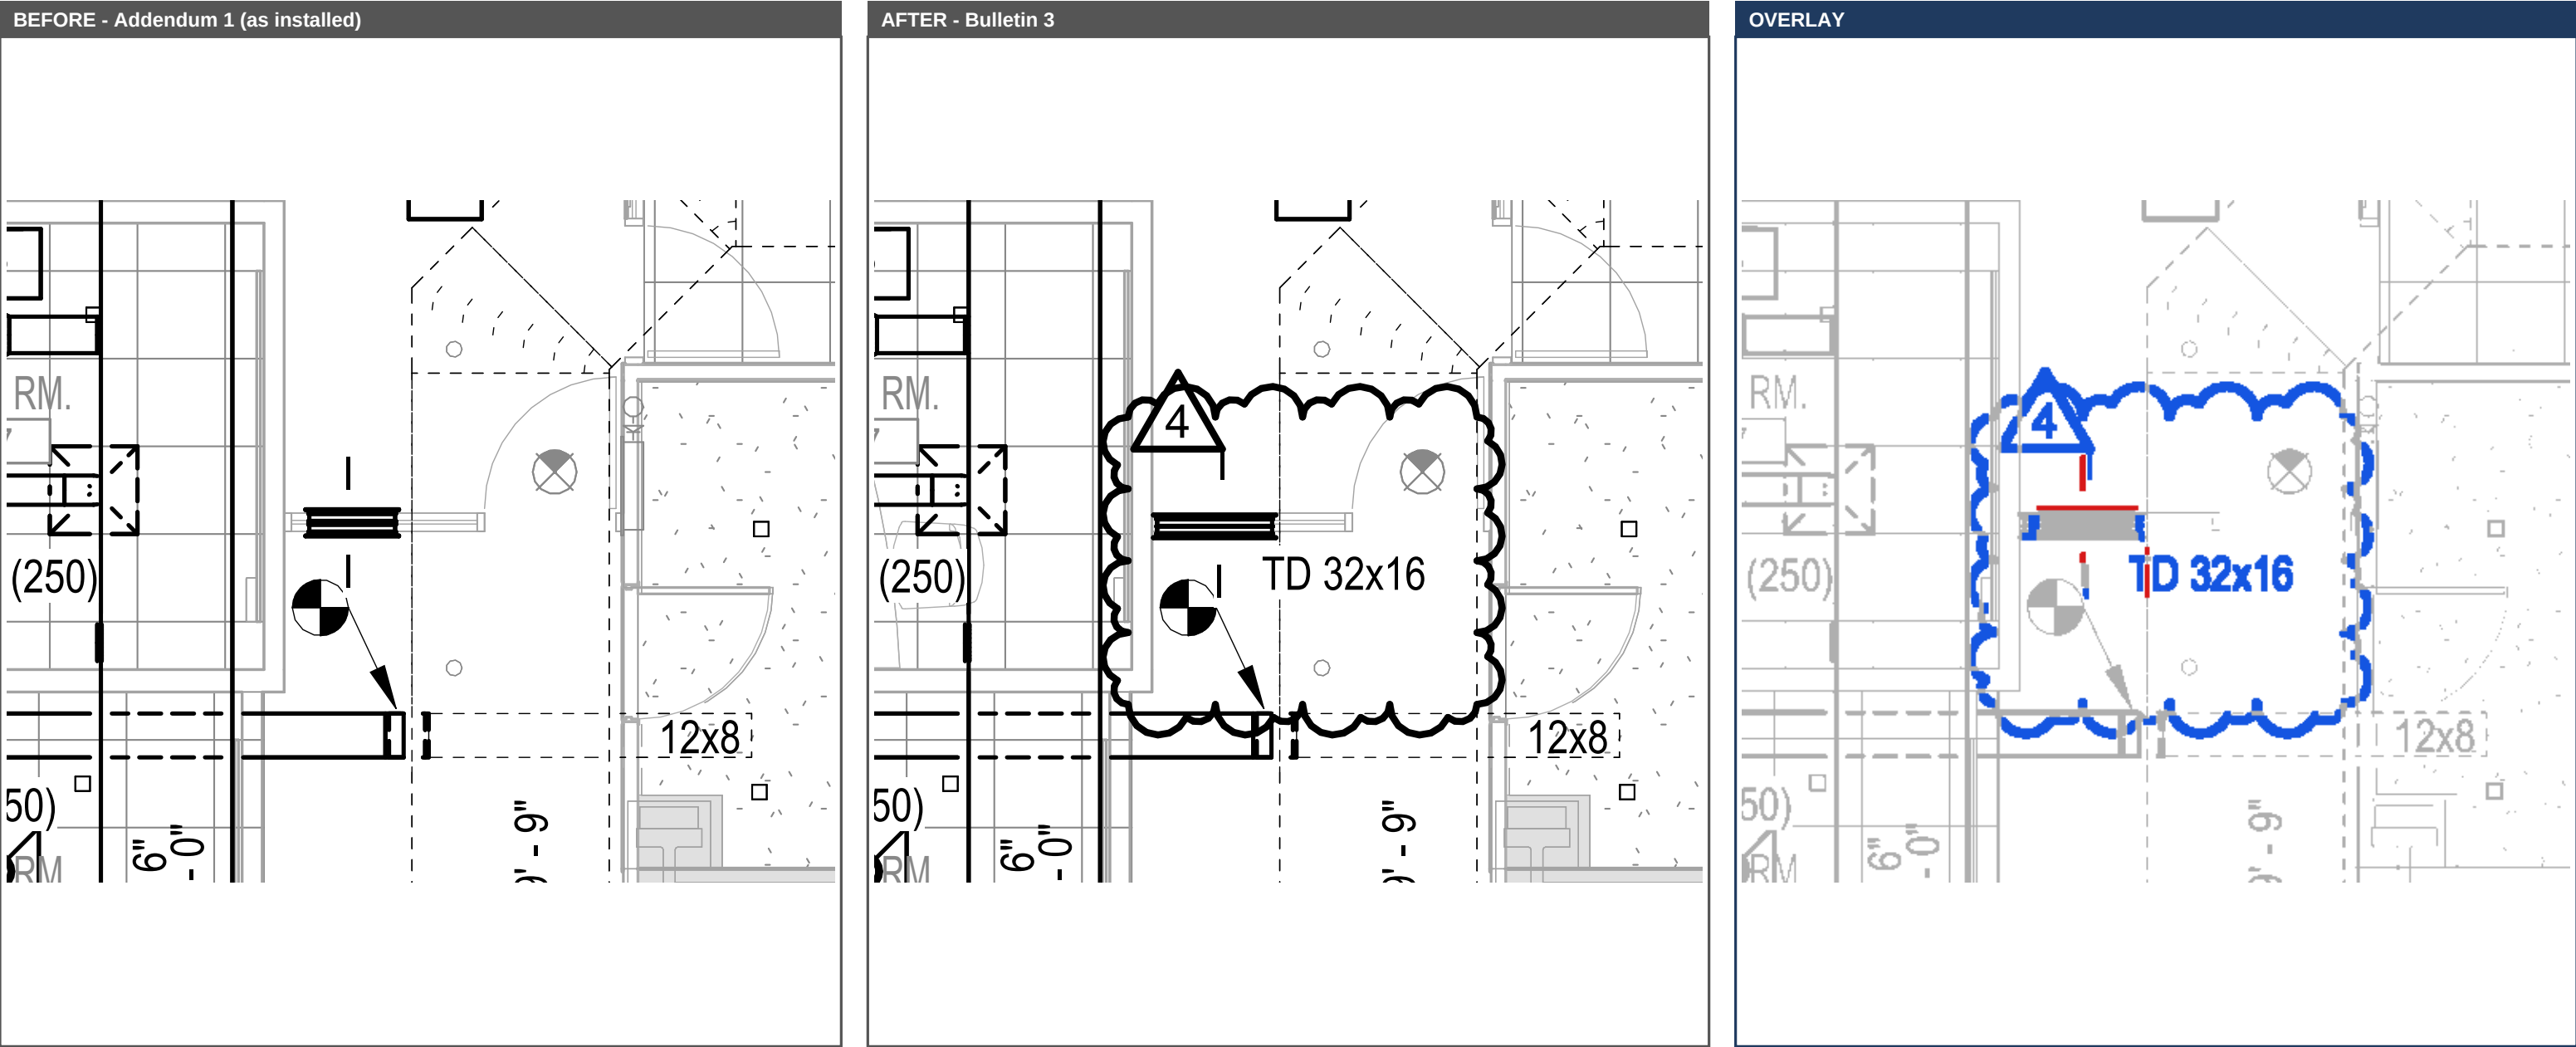

- Unchanged
- Addendum 1 only - installed, removed
- Bulletin 3 only - new work

Before (Addendum 1, installed): Transfer duct as installed per Addendum 1 (not sized on Addendum 1).


After (Bulletin 3): Transfer duct revised to TD 32x16.

Work required: Remove installed transfer duct; fabricate and install TD 32x16.

Cost item	Qty	Unit	Rate	Amount
Disconnect / removal of installed ductwork, haul away (labor)	1	MH	\$125	\$125
Fabricated ductwork, fittings, insulation, accessories (material)	1	LS		\$300
Relocation / installation of ductwork (labor)	5	MH	\$125	\$625
Area 31-2 total				\$1,050

Area 31-3 - Storage 31.02 - new transfer ducts

31th floor, M-531.00 | Before = Addendum 1 After = Bulletin 3 (rev 4, 08/10/2026)

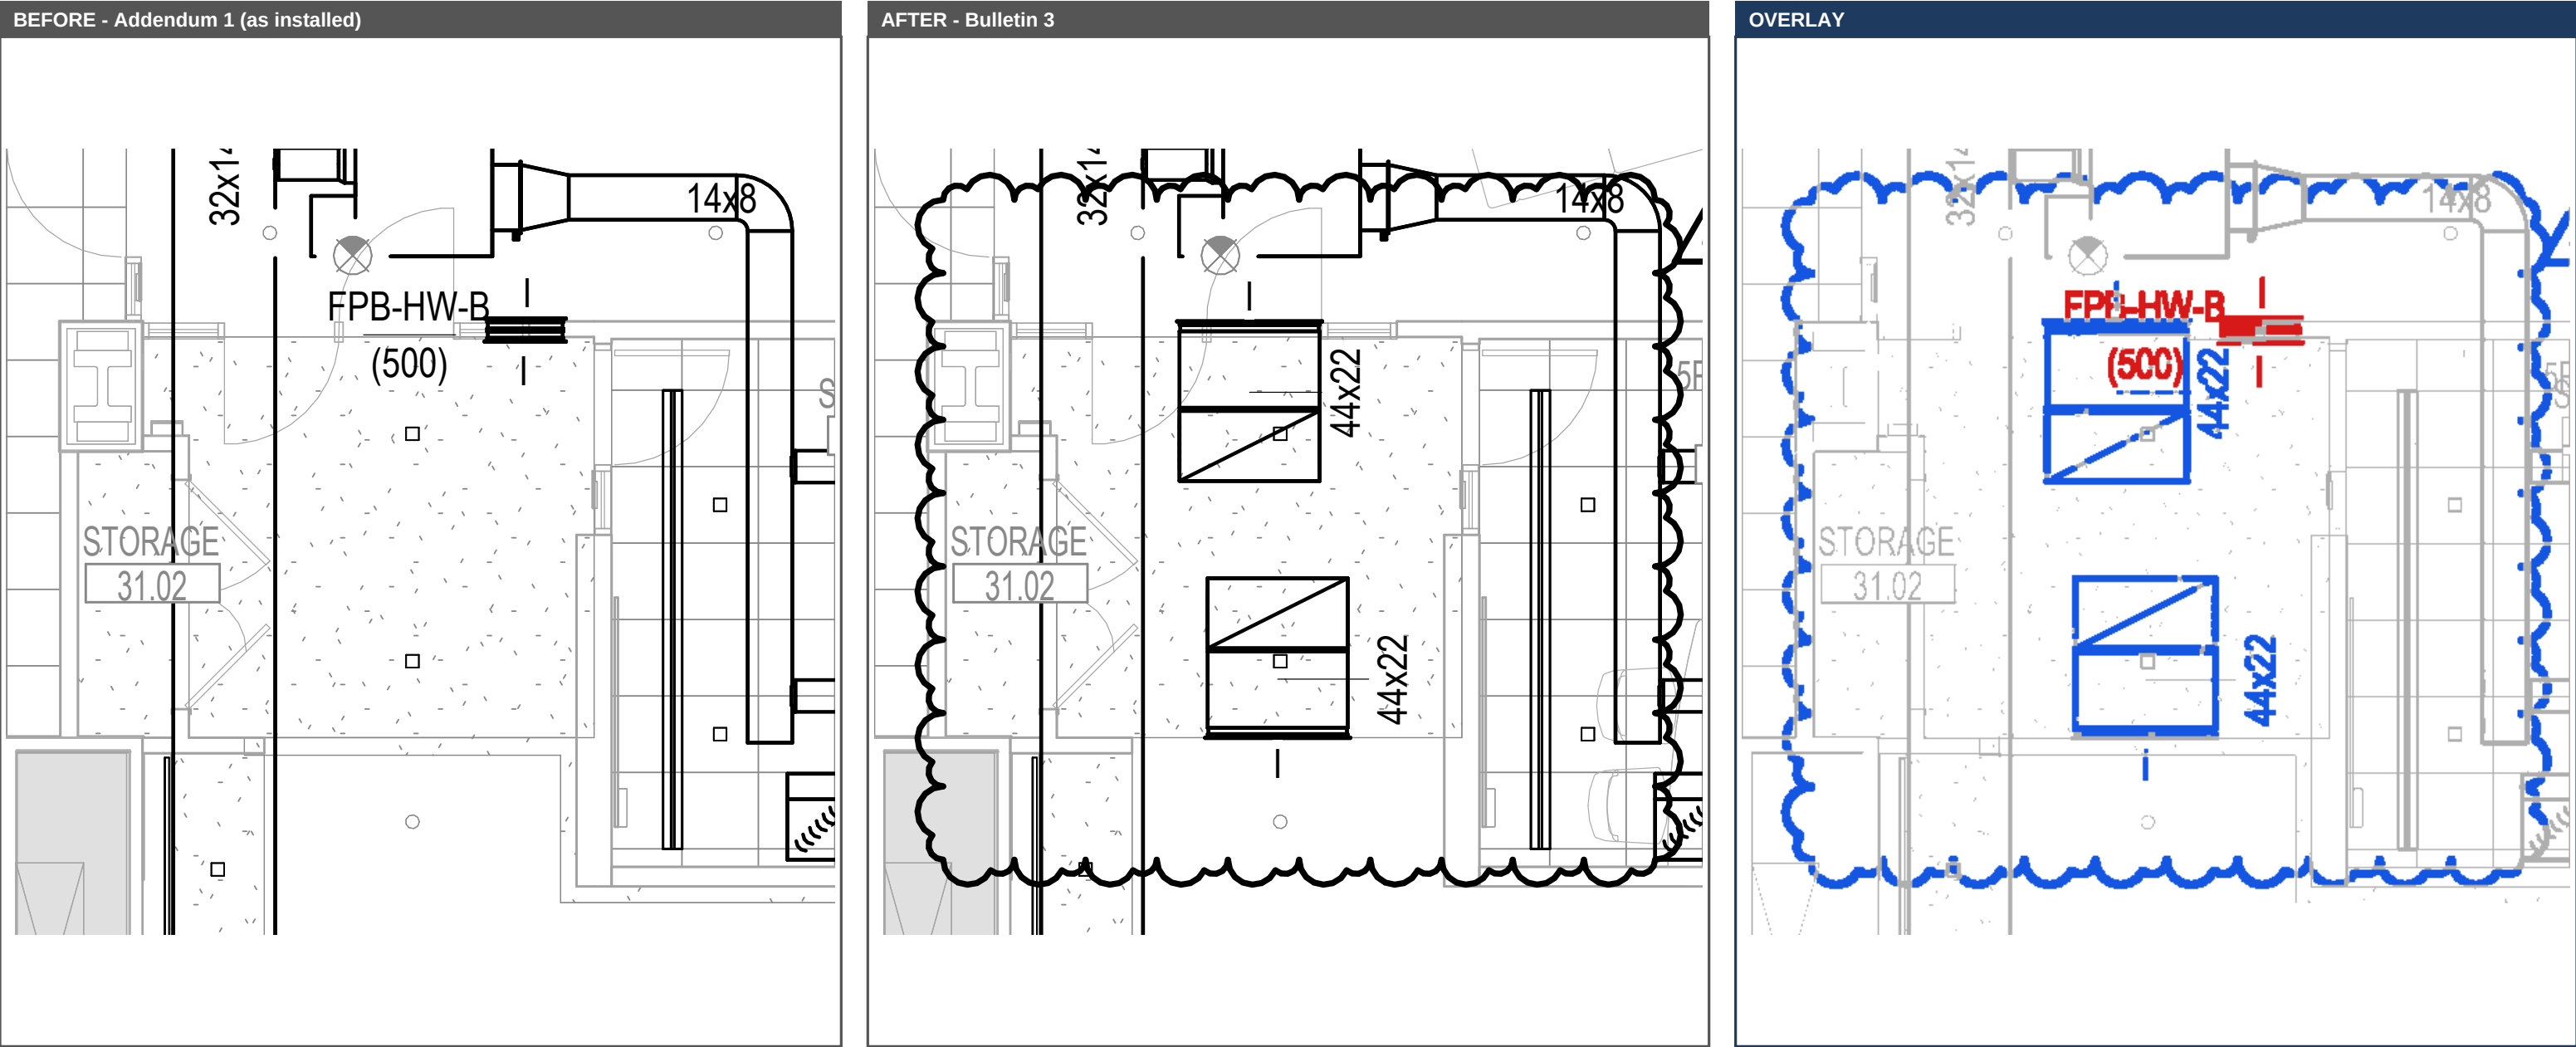


- Unchanged
- Addendum 1 only - installed, removed
- Bulletin 3 only - new work

Before (Addendum 1, installed): No transfer ducts; volume damper at FPB-HW-B (500) branch.

After (Bulletin 3): (2) new 44x22 transfer ducts.

Work required: Remove affected branch fitting; fabricate and install (2) 44x22 lined transfer ducts.

Cost item	Qty	Unit	Rate	Amount
Disconnect / removal of installed ductwork, haul away (labor)	4	MH	\$125	\$500
Fabricated ductwork, fittings, insulation, accessories (material)	1	LS		\$1,700
Relocation / installation of ductwork (labor)	20	MH	\$125	\$2,500
Area 31-3 total				\$4,700

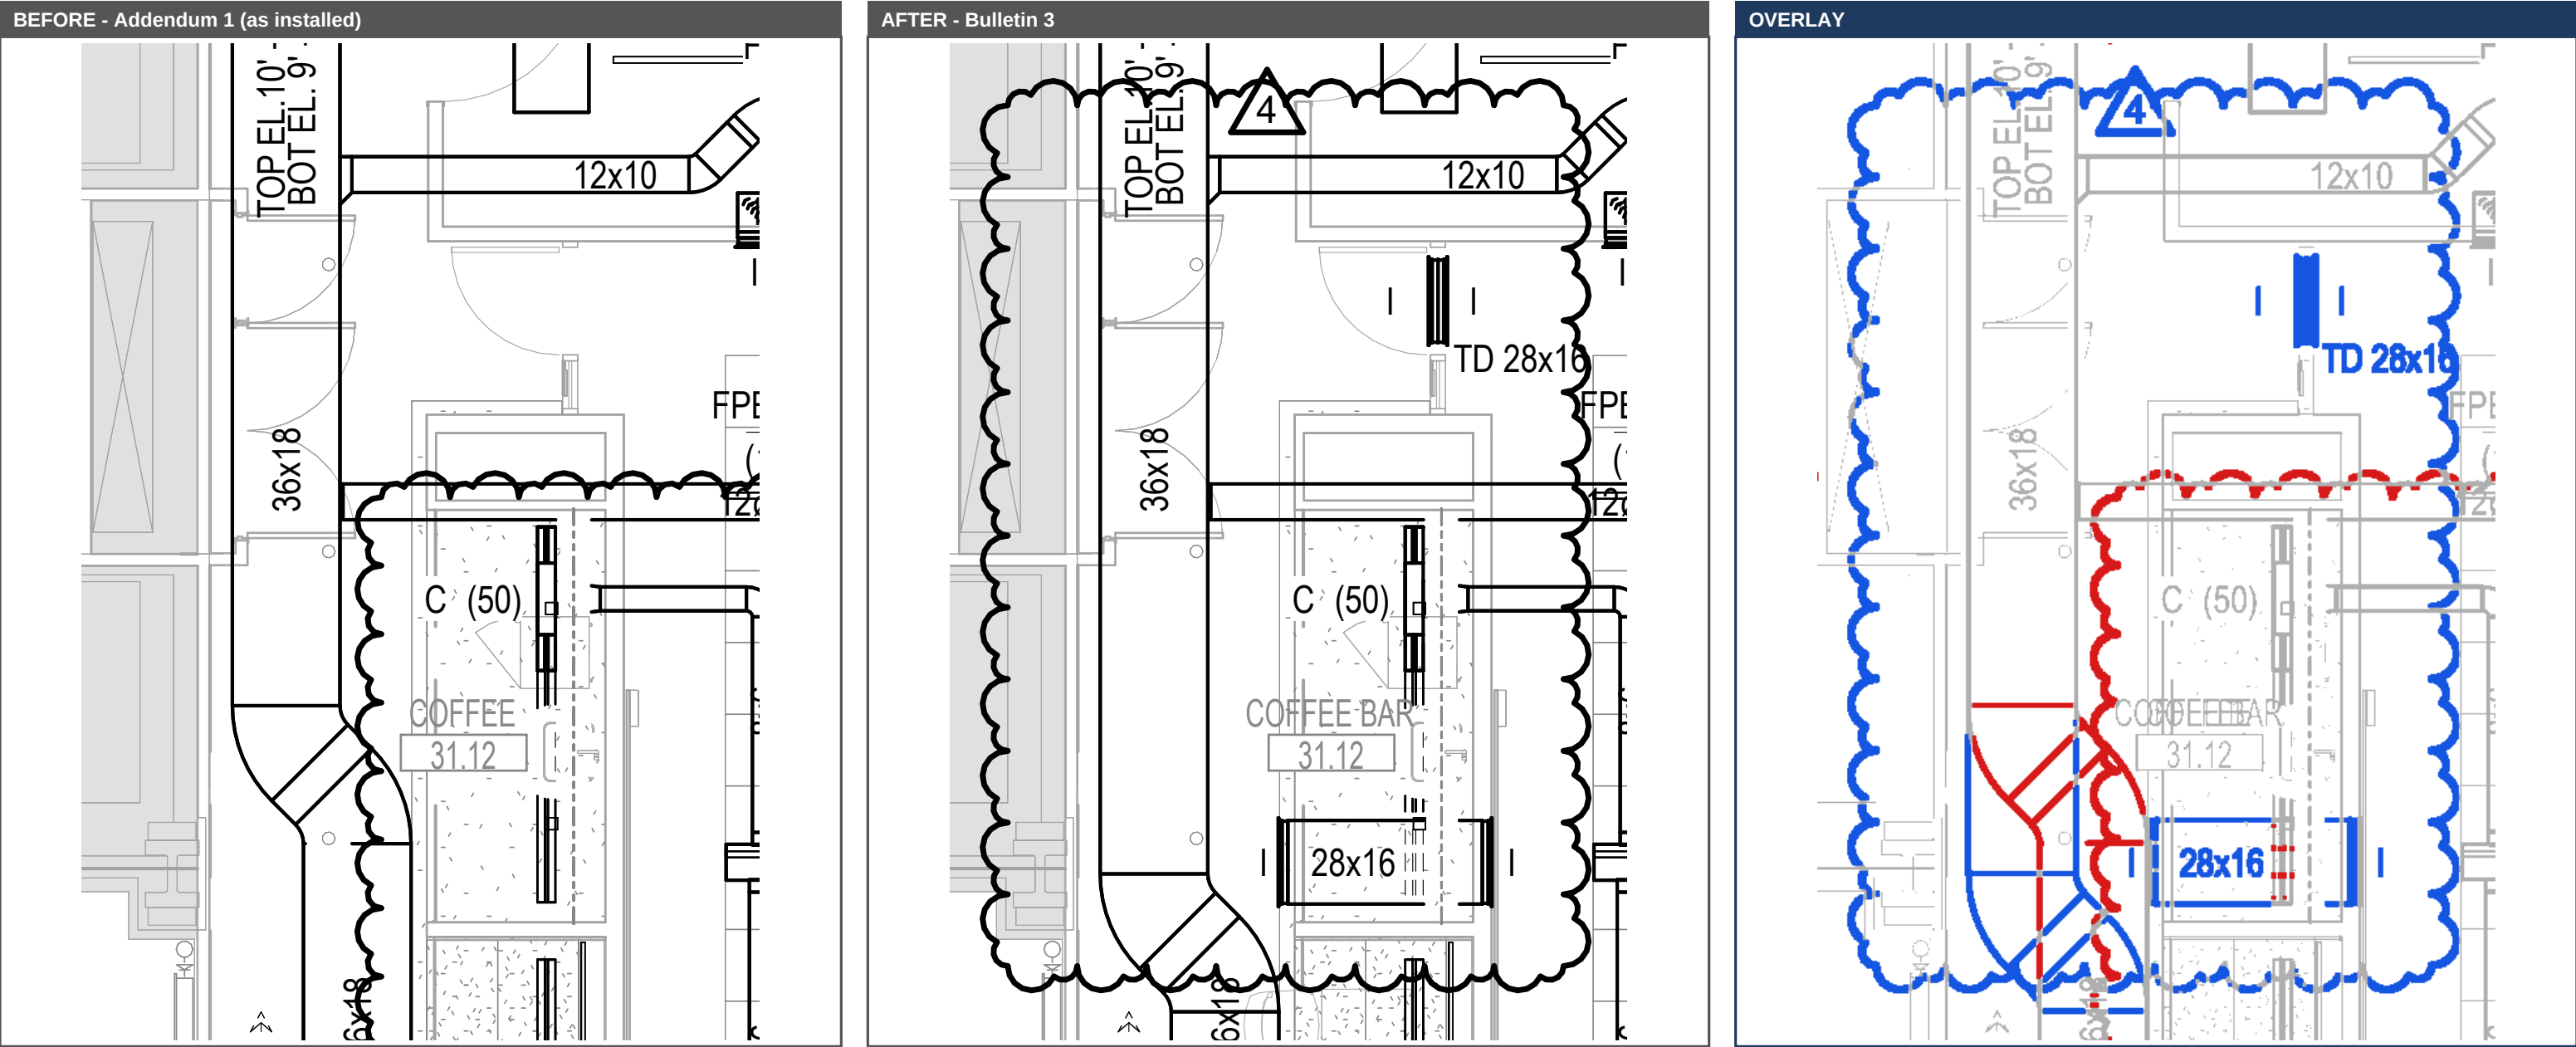

Before (Addendum 1, installed): 36x18 main with elbow at Coffee Bar 31.12; no transfer ducts.

After (Bulletin 3): (2) new TD 28x16; 36x18 main elbow reconfigured.

Work required: Disconnect and remove 36x18 elbow; fabricate and install new fitting and (2) TD 28x16.


Cost item	Qty	Unit	Rate	Amount
Disconnect / removal of installed ductwork, haul away (labor)	6	MH	\$125	\$750
Fabricated ductwork, fittings, insulation, accessories (material)	1	LS		\$1,700
Relocation / installation of ductwork (labor)	22	MH	\$125	\$2,750
Area 31-4 total				\$5,200

Area 31-5 - Transfer duct TD 32x16, southwest

31th floor, M-531.00 | Before = Addendum 1 After = Bulletin 3 (rev 4, 08/10/2026)

NORTHERN WOLVES AC

Snowflake Fitout - 7 Times Square, Floors 29-31 | COP-SF-05 Bulletin 3 Revision

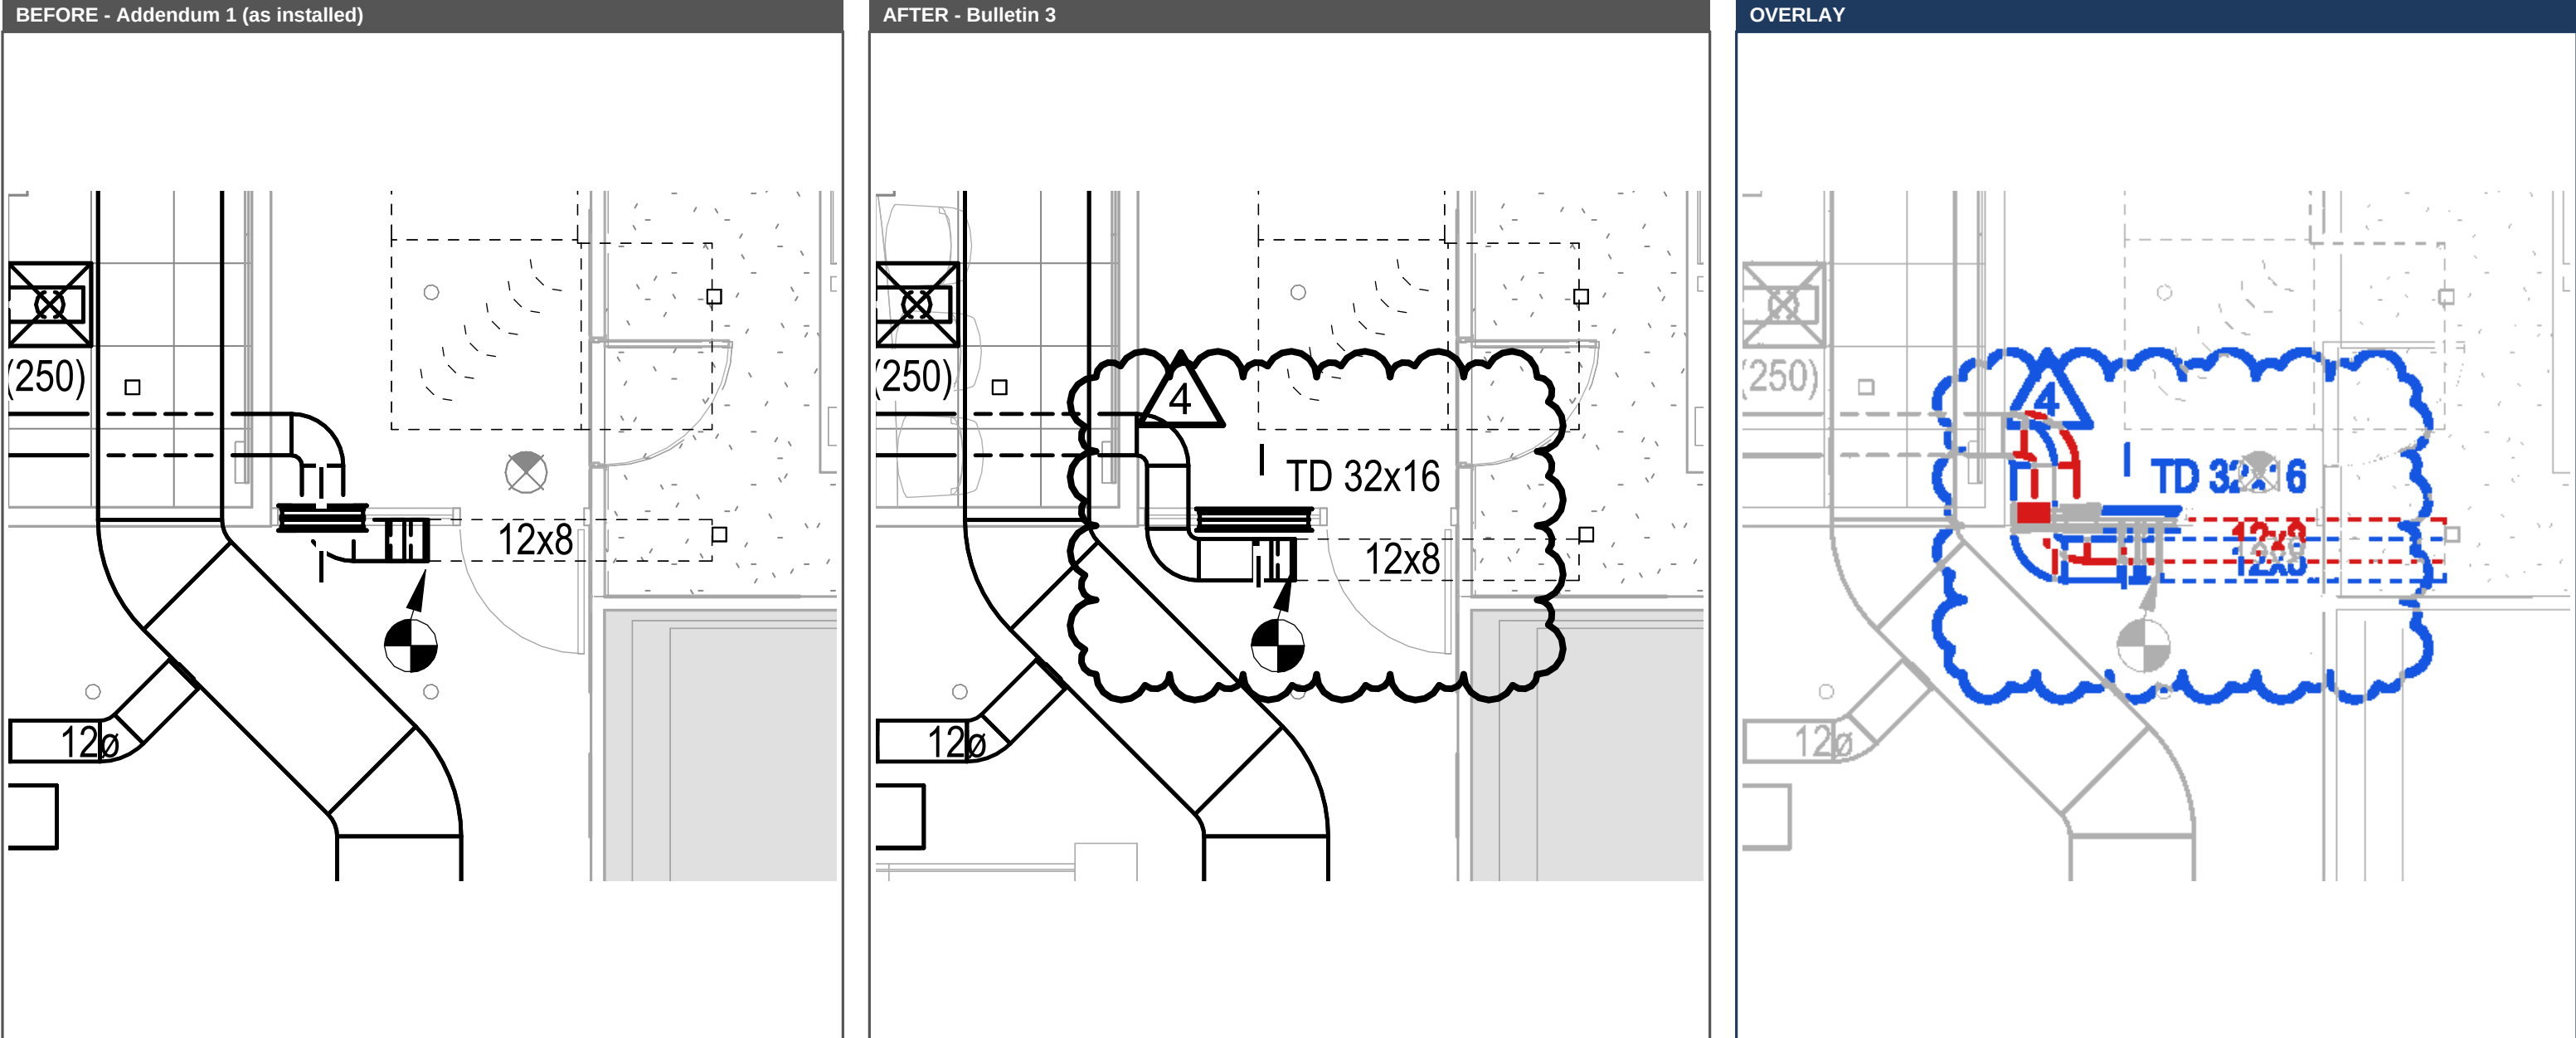

■ Unchanged
■ Addendum 1 only - installed, removed
■ Bulletin 3 only - new work

Before (Addendum 1, installed): Transfer duct and duct elbow as installed per Addendum 1, next to the 12x8 branch.

After (Bulletin 3): Transfer duct revised to TD 32x16; elbow deleted.


Work required: Remove installed transfer duct and elbow; fabricate and install TD 32x16.

Cost item	Qty	Unit	Rate	Amount
Disconnect / removal of installed ductwork, haul away (labor)	2	MH	\$125	\$250
Fabricated ductwork, fittings, insulation, accessories (material)	1	LS		\$650
Relocation / installation of ductwork (labor)	16	MH	\$125	\$2,000
Area 31-5 total				\$2,900

NORTHERN WOLVES AC

Snowflake Fitout - 7 Times Square, Floors 29-31 | COP-SF-05 Bulletin 3 Revision

AFTER - Bulletin 3

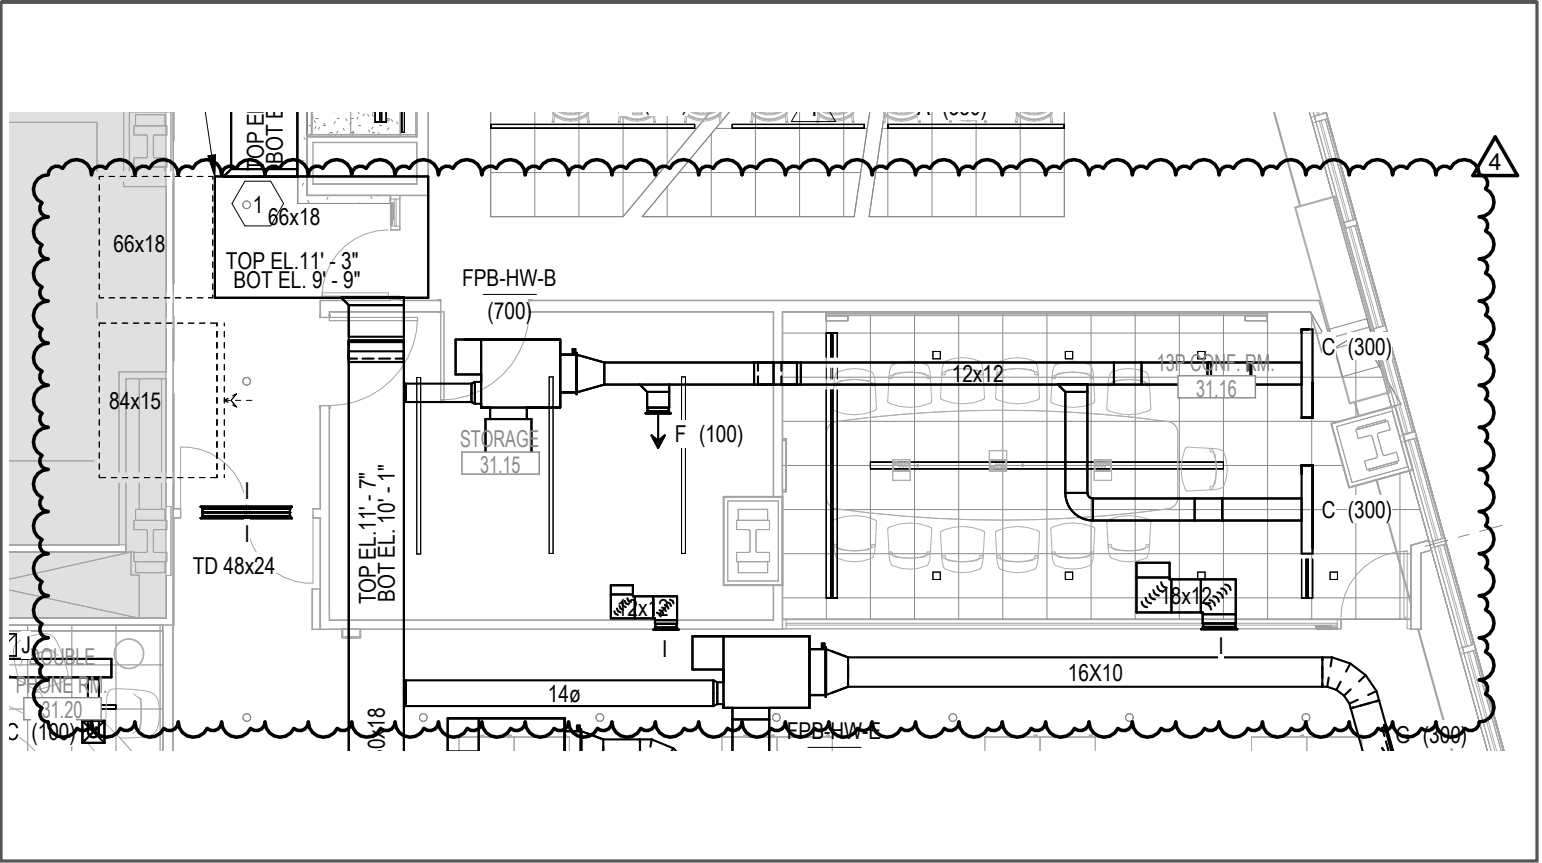

■ Unchanged
■ Addendum 1 only - installed, removed
■ Bulletin 3 only - new work

Before (Addendum 1, installed): 12x12 and 18x12 grilles at previous locations; no transfer duct at Storage 31.15.

After (Bulletin 3): New TD 48x24; 12x12 and 18x12 grilles relocated.

Work required: Remove grilles and their duct connections; fabricate and install TD 48x24, relocate 12x12 and 18x12 grilles with duct connections at new locations.

Cost item	Qty	Unit	Rate	Amount
Disconnect / removal of installed ductwork, haul away (labor)	3	MH	\$125	\$375
Fabricated ductwork, fittings, insulation, accessories (material)	1	LS		\$1,150
Relocation / installation of ductwork (labor)	12	MH	\$125	\$1,500
Area 31-6 total				\$3,025

