



NORTHERN WOLVES
AIR CONDITIONING

Request for Pricing / Date: 10/6/2026 / Rev 1

Northern Wolves AC
55 9th St, 55-A2
Brooklyn, NY
11215, US
(347) 463-9248

To
Equipment vendors

Requested By:
Alikhan Ilyas
(347) 463-9248
alikh@northernwolvesac.com

Project: **Sunrise Rye Brook - 900 King St, Rye Brook, NY 10573**

Mechanical drawings: GMP set dated 07.15.2026 (value engineering revisions below)

Request for revised pricing - value engineering

The heating design is being revised from a hot water boiler plant to electric heat. Please provide revised pricing for the items below: new items (section 1 and 2), credits for items deleted from your previous quote (section 3) and alternate deducts (section 4). Quote per line in the attached xlsx, with lead times. Electric heat at 208 V, kW rated at 208 V (not 240 V units derated): VAV electric reheat coils up to 5 kW at 208 V / 1 ph, above 5 kW at 208 V / 3 ph (voltage listed per box); cabinet and unit heaters at 208 V / 3 ph (note any item only available 208 V / 1 ph). Controls are standalone (no BMS): factory-mounted standalone controllers with wall thermostats / sensors.

1. VAV terminal units (1st floor common areas)

1A. Single-duct VAV with factory electric reheat coil, SCR control, airflow switch, disconnect, standalone pressure-independent controller and wall thermostat (26)

Tag	Room served	Inlet	Max CFM	Min CFM	Elec. heat	Volts / ph
VAV-1	Movement Studio 1045	12"	1200	825	8 kW	208/3
VAV-2	Fitness 1044	14"	1450	1350	13 kW	208/3
VAV-3	Multi-Purpose Room 1043	14"	2250	1150	11 kW	208/3
VAV-4	Theater 1042	8"	700	375	4 kW	208/1
VAV-7	Spa / Salon 1041A	10"	700	250	2.5 kW	208/1
VAV-9	Gen. Manager Office 1035	8"	350	150	1.5 kW	208/1
VAV-10	Locker rooms	6"	425	250	3 kW	208/1
VAV-11	Art 1032	10"	550	500	5 kW	208/1
VAV-15	AVC 1034B	6"	200	200	2.5 kW	208/1
VAV-16	Sales Office 1034C	6"	300	250	3 kW	208/1
VAV-17	Family Meeting Room 1002	8"	450	450	4.5 kW	208/1
VAV-18A	Treatment Rm 1041C	TBD	TBD	TBD	3 kW	208/1
VAV-20	Library 1007	8"	350	150	1.5 kW	208/1
VAV-21	Store 1008	8"	300	150	1.5 kW	208/1
VAV-22	Activity Room 1009	12"	900	250	2.5 kW	208/1
VAV-26	Private Dining 1016	6"	400	200	2.5 kW	208/1
VAV-30	Private Dining 130 / Dry Storage	6"	350	200	2.5 kW	208/1
VAV-38	Family Room 120	8"	450	300	3.5 kW	208/1
VAV-39	Work Room / Sales / Exec. Director	6"	400	250	3 kW	208/1
VAV-41	Salon 132A	8"	400	150	1.5 kW	208/1
VAV-42	Theater 135	12"	600	200	2.5 kW	208/1
VAV-43	Activity 136	14"	1000	400	4 kW	208/1
VAV-44	Fitness 141	16"	1100	500	5 kW	208/1
VAV-45	Fitness / Wellness Office	8"	450	350	3.5 kW	208/1

Tag	Room served	Inlet	Max CFM	Min CFM	Elec. heat	Volts / ph
VAV-46	Wellness Office	6"	400	200	2.5 kW	208/1
VAV-47	Exam / AVC Office	6"	450	300	3 kW	208/1
Total					100 kW	

Heating airflow at the scheduled minimum CFM; confirm minimum airflow for the electric coil. VAV-18A: second VAV-18 tag on M2010 (Treatment Rm 1041C), size per vendor at 3 kW.

1B. Single-duct VAV, cooling only (no reheat coil), standalone controller and wall thermostat (4)

Tag	Room served	Inlet	Max CFM	Min CFM
VAV-8	IT Office 1036 / AV Closet	4"	200	100
VAV-14	Security 1033 / Package 1003B	10"	600	600
VAV-31	Storage 1031 / Trash 1030 / Receiving	14"	1200	400
VAV-32	Chef Office 1027	6"	150	50

1C. VAV boxes cancelled - credit (18)

Tag	Room served	Inlet	Max CFM	Min CFM
VAV-5	Corridor / gallery	8"	400	400
VAV-6	Corridor	8"	400	400
VAV-12	Lounge 1004A	14"	1300	1300
VAV-13	Lounge / Bistro 1004A-B	10"	600	600
VAV-18	Reception 1003A	8"	500	500
VAV-19	Coffee Shop 1006	6"	200	50
VAV-24	Bistro 1004B	10"	550	200
VAV-23	Restrooms 1012-1013 / Mailroom	6"	300	100
VAV-25	Casual Dining 1015	14"	3000	1100
VAV-27	Formal Dining 1017	14"	1850	425
VAV-28	Restrooms / kitchen corridor	10"	800	525
VAV-29	Main Kitchen 1019	16"	1800	600
VAV-33	AL Dining 128	16"	2500	1000
VAV-34	Bistro 127	14"	1200	450
VAV-35	Bistro / dining 127	6"	200	200
VAV-36	Parlor 131	8"	350	150
VAV-37	Reception 126	8"	250	150
VAV-40	Corridor 100C	6"	200	100

2. Electric heaters

2A. Electric cabinet unit heaters, wall / ceiling as scheduled, with integral thermostat, disconnect and fan (10)

Tag	Location	Heat	Fan CFM (as scheduled)
CH-1	Movement Studio entry	5.3 kW	450
CH-3	Pool deck / stair entry	5.3 kW	450
CH-4	Exterior door at gallery	5.3 kW	450
CH-5	Fitness entry	5.3 kW	450
CH-12	Multi-Purpose Room entry	5.3 kW	450
CH-6	Vestibule 1001	5.3 kW	450
CH-7	Formal Dining entry	5.3 kW	450
CH-9	Trash 1030 / Storage	10.4 kW	1,050
CH-10	Casual Dining entry	5.3 kW	450
CH-11	Casual Dining entry	5.3 kW	450
Total		58.1 kW	

2B. Electric horizontal unit heaters, ceiling hung, with integral thermostat and disconnect (9)

#	Location (basement)	Heat
1	Residents' Storage B107	3 kW

#	Location (basement)	Heat
2	Trash Collection B106 (exhaust make-up)	5 kW
3	Kitchen Storage B113	5 kW
4	Corridor B100	3 kW
5	Residents' Storage B115	3 kW
6	Team Member Lounge B119A	3 kW
7	Mechanical B118	5 kW
8	Trash room, AL south (400 CFM exhaust make-up)	5 kW
9	Storage room, AL south	3 kW
Total		35 kW

3. Deleted from scope - please provide credit against your previous quote


Item	Qty	Unit
Boilers B-1, B-2, B-3 (1,999 MBH input, fire tube)	3	ea
Boiler pumps BP-1, BP-2	2	ea
Primary pumps PP-1, PP-2	2	ea
Glycol / snow melt pumps P-1 to P-4	4	ea
Heat exchanger HX-3 (826 MBH, 30% PG)	1	ea
Hydraulic separator HS-1, expansion tanks ET-1 / ET-2, air separator AS-1	1	lot
Chemical pot feeder and glycol fill package	1	lot
Hot water fan coil units FCU-A (basement)	20	ea
Radiators RAD-1, RAD-2	2	ea
Hot water cabinet heaters CH-1, CH-3 to CH-12	11	ea
Hot water reheat coils on VAV boxes	47	ea
VAV boxes cancelled (list in section 1C)	18	ea

4. Alternate deducts - price separately

Alt	Item	Qty	Unit
ALT-1	Deduct: combination fire / smoke dampers at apartment DOAS branches, 6x4 to 8x6, with actuators (floors 1 to 4)	283	ea
ALT-2	Deduct: apartment bath exhaust fans TX-A (75 CFM, ceiling, 120 V)	283	ea

Please include: unit and extended prices, freight to Rye Brook NY, lead time, submittal data, and any exclusions. Taxes listed separately.

Attached: marked-up drawings M2010, M2011, M2013 (VAV terminals, cabinet heaters) and M2000, M2002 (basement unit heaters). Each item is marked with its tag and heat kW.

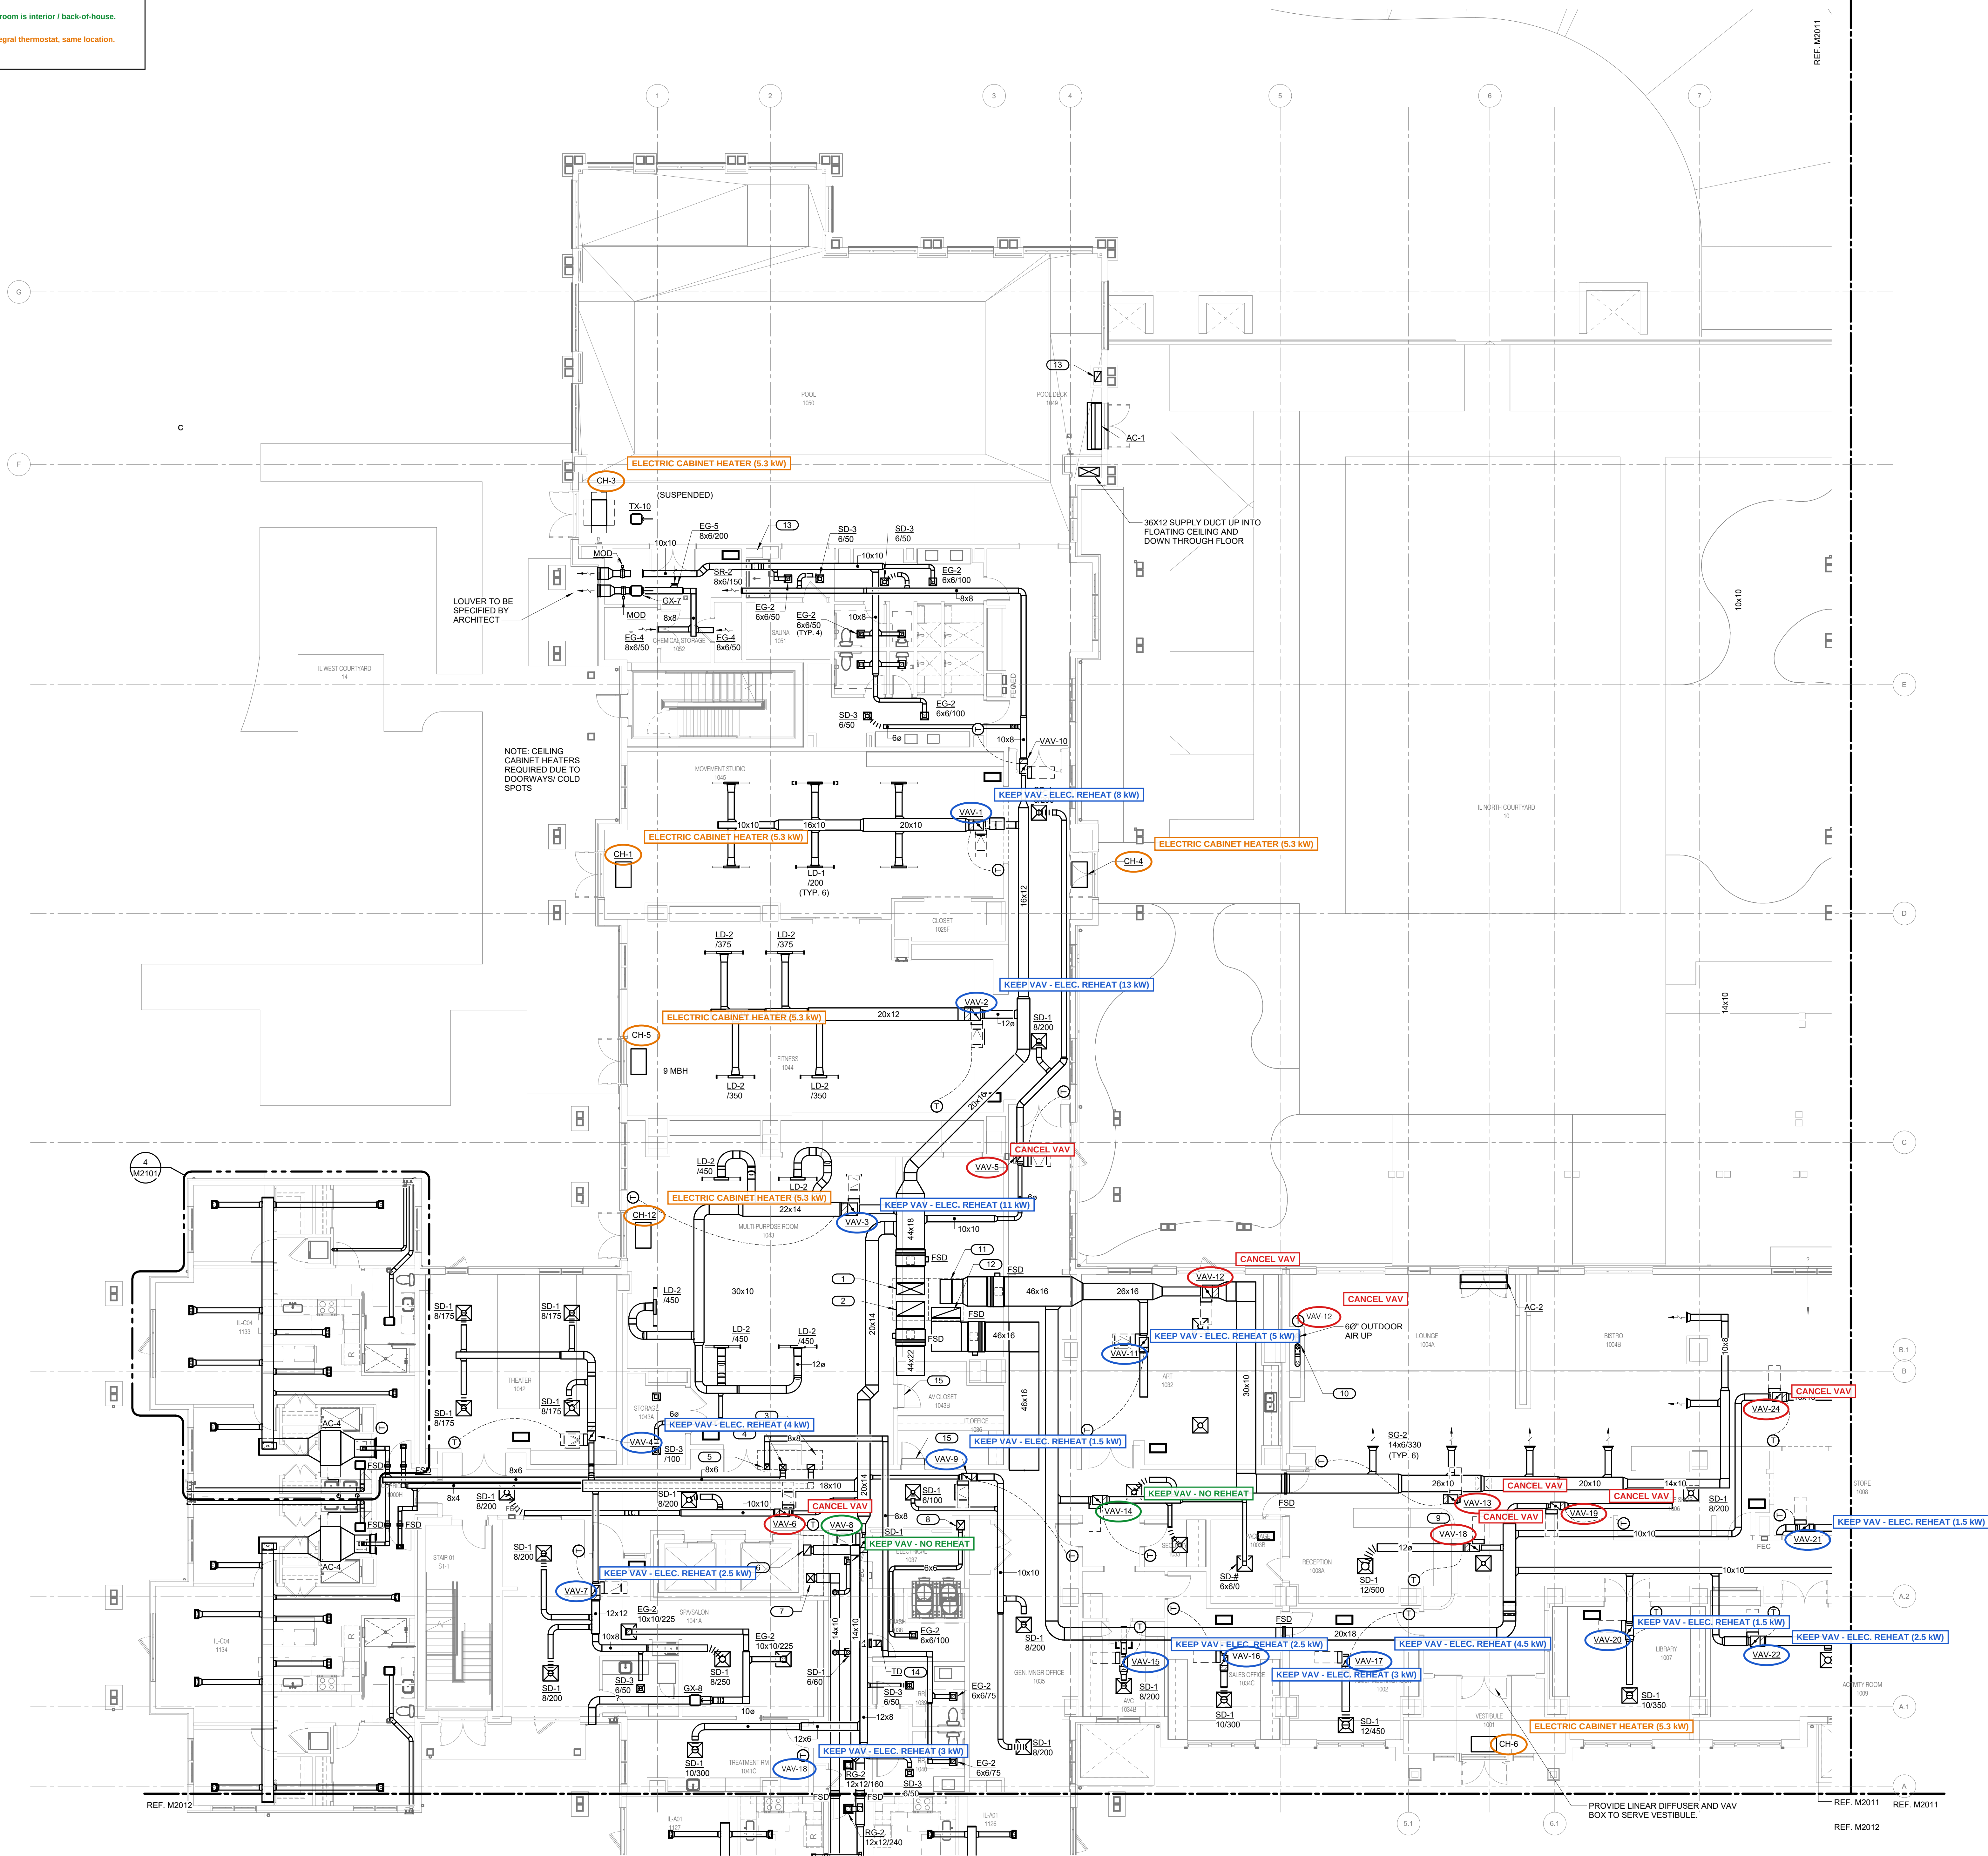

KEYNOTES:

- 44x24 SUPPLY AIR DUCT UP THROUGH CHASE TO RTU-1.
- 44x24 RETURN AIR DUCT UP THROUGH CHASE TO RTU-1.
- 12x6 RETURN AIR DUCT UP THROUGH CHASE TO DOAS-1.
- 10x10 SUPPLY AIR DUCT UP THROUGH CHASE TO DOAS-1.
- 8x8 TOILET EXHAUST AIR DUCT UP THROUGH CHASE TO TX-1 ON ROOF.
- 18x12 RETURN AIR DUCT UP THROUGH CHASE TO DOAS-3.
- 14x12 SUPPLY AIR DUCT UP THROUGH CHASE TO DOAS-3.
- 10" EXHAUST AIR SERVING TRASH ROOM UP THROUGH CHASE TO ROOF.
- VAV UNITS TO REQUIRE ACCESS PANEL IN CEILING. COORDINATE ACCESS PANEL LOCATION WITH FINAL RCP. (TYP. ALL.)
- 80" 10/100" CO-FIREPLACE CHIMNEY UP.
- 38x18 SUPPLY DUCT UP THROUGH CHASE TO RTU-2.
- 48x16 RETURN DUCT UP THROUGH CHASE TO RTU-2.
- 12x10 LOW RETURN DUCT UP AND DOWN IN BUMP OUT.
- PROVIDE 8"x6" TRANSFER AIR DUCT THROUGH WALL WITH FIRE/SMOKE DAMPER AS REQUIRED.
- PROVIDE 1-TON WALL MOUNTED MINI-SPLIT. ROUTE REFRIGERANT TO CONDENSING UNIT ON ROOF.

HKS

ARCHITECT
HKS ARCHITECTS, P.C.
30 WEST 26th STREET, 12th FLOOR
NEW YORK, NY 10010

STRUCTURAL

MEG
1411 BROADWAY, SUITE 600
NEW YORK, NY 10018

MEP ENGINEER

MEG
177 CROSWAYS PARK DRIVE
WOODBURY, NY 11797

LV ENGINEER

TAZERCO
7653 HICKORY FLAT HWY, SUITE 200
WOODSTOCK, GA 30188

LANDSCAPE ARCHITECT

MEFP
120 BROADWAY, 20TH FLOOR
NEW YORK, NY 10021

POOL DESIGNER

COUNSLMANHUNSAKER & ASSOCIATES, INC.
12851 MANCHESTER ROAD, SUITE 120
ST. LOUIS, MO 63131

FOOD SERVICE & LAUNDRY

CLARK
2551 HORSESHOE RD.
LANCASTER, PA 17601


SUNRISE
SENIOR LIVING
RYE BROOK

DOB BSCAN / DOB STAMP & SIGNATURES

SEAL & SIGNATURE

CON NO.: 111AAA

KEY PLAN

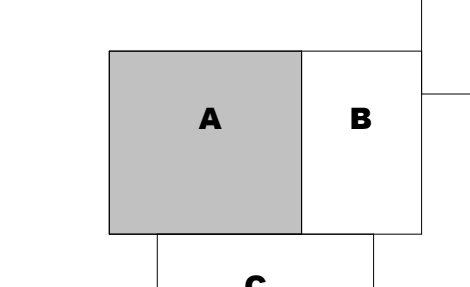


REVISION		
NO.	DESCRIPTION	DATE
1	DD Progress Print	08/28/25
2	DESIGN DEVELOPMENT	11/25/25
3	EXTERIOR BUILDING PERMIT	12/23/25
4	100% DESIGN DEVELOPMENT	01/30/26
5	ISSUED FOR PERMIT	06/05/26

IMEG
177 CROSWAYS PARK DRIVE
WOODBURY, NY 11797
P: 516-927-6900

IMEG RESERVES PROPRIETARY RIGHTS, INCLUDING COPYRIGHTS, TO THE DRAWINGS AND THE DATA SHOWN THEREON. NO REPRODUCTION AND/OR DATA ARE THE EXCLUSIVE PROPERTY OF IMEG AND SHALL NOT BE USED OR REPRODUCED FOR ANY OTHER PROJECT WITHOUT THE EXPRESS WRITTEN APPROVAL AND PARTICIPATION OF IMEG. ©2026 IMEG CONSULTANTS CORP.

REF. SCALE IN INCHES PROJECT #2004064-01

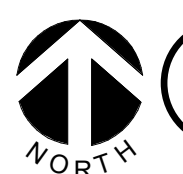**INDEPENDENT LIVING FIRST FLOOR PLAN - MECHANICAL IL AREA A**

1/8" = 1'-0"

HKS PROJECT NUMBER

25004064.00

DATE

07/15/26

ISSUE

ISSUED FOR GMP

SHEET NO.


INDEPENDENT LIVING**FIRST FLOOR PLAN -****MECHANICAL IL AREA****M2010**

DOB FILE # DOB PAGE #




- KEYNOTES:**
- 1 FIRE RATED CHIMNEY ENCLOSURE REQUIRED FOR ALL ROOF CHASES
 - 2 OUTLINE OF DUCT SHIRT ABOVE
 - 3 32x12 SUPPLY AIR DUCT UP AND DOWN
 - 4 36x12 EXHAUST AIR DUCT DOWN CHASE TO DOGS-4 PROVIDE FSD WHERE DUCT LEAVES CHASE
 - 5 36x12 RTU-4 SUPPLY AIR IN SHIRT
 - 6 36x12 SUPPLY DUCT 25 FEET DOWN IN SHIRT
 - 8 12x12 DISHWASHER EXHAUST UP IN SHIRT
 - 9 36x12 EXHAUST CHIMNEY HOOD SUPPLY VAIR UP IN SHIRT W/ FSD
 - 10 12x10 PIZZA OVEN EXHAUST UP IN SHIRT
 - 11 36x12 EXHAUST AIR DUCT DOWN CHASE TO RTU-4
 - 12 36x12 EXHAUST AIR DUCT UP AND DOWN IN CHASE
 - 13 EXACT PLACEMENT OF DISHWASHER SHALL BE DETERMINED BY THE OWNER
 - 14 18x10 SUPPLY AIR DUCT UP AND DOWN THROUGH CHASE TO DOGS-4 PROVIDE FSD WHERE DUCT LEAVES CHASE
 - 15 18x12 SUPPLY AIR DUCT UP AND DOWN THROUGH CHASE TO DOGS-4 PROVIDE FSD WHERE DUCT LEAVES CHASE
 - 16 12x14 TRANSIT EXHAUST UP IN SHIRT
 - 17 36x12 EXHAUST AIR DUCT DOWN THROUGH WALL WITH FIRE/SMOKE DAMPER AS REQUIRED

FOOD SERVICE & LAUNDRY
CLARK
2551 HORSESHOE RD.
LANCASTER, PA 17601


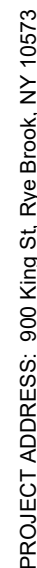


SEAL & SIGNATURE _____

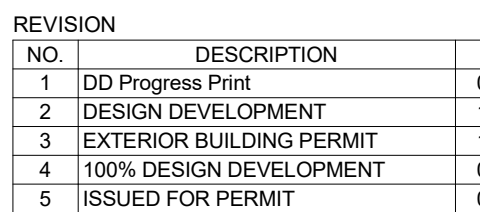

SHEET TITLE
**INDEPENDENT LIVING
FIRST FLOOR PLAN -
MECHANICAL IL ARE**
SHEET NO.

M2011

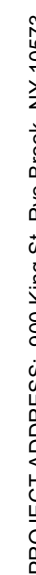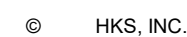
$$1/8^{\circ} = 1'0''$$


SEAL & SIGNATURE _____

CON NO.: 111AM



MECH

