



NORTHERN WOLVES
AIR CONDITIONING

Ref. Quote: 3112 / Date: 10/6/2026 / Rev 1

Customer
Callahan Construction Managers

Project: **Sunrise Rye Brook - 900 King St, Rye Brook, NY 10573**

Value Engineering Mark-ups - VAV zoning, cabinet heaters, basement fan coils

The following sheets of the GMP mechanical set are marked up with our proposals. Same rooftop units as designed (gas heat). VAV boxes in open areas and circulation are cancelled and the areas are served directly from the rooftop units; VAV boxes stay in enclosed rooms, with electric reheat and simple standalone thermostats where reheat is needed, and with no reheat in interior / back-of-house rooms. Hot water cabinet heaters and basement fan coils are replaced by electric heaters. Rooms that need cooling or ventilation are listed in RFI-01 (last page) and are not priced. Pool, spa and sauna are by others.

Mark	Meaning
CANCEL VAV	Cancel VAV box (open area / circulation). Branch duct stays with manual volume damper, balanced to design max CFM; area served directly by the RTU (RTU space sensor here). Gas heat from the RTU.
KEEP VAV - ELEC. REHEAT	Keep VAV box. Electric reheat coil with SCR in lieu of hot water coil; simple standalone thermostat. No hot water piping or control valve.
KEEP VAV - NO REHEAT	Keep VAV box, cooling only. No reheat required: RTU is gas heat and the room is interior / back-of-house. Standalone thermostat.
ELECTRIC CABINET HEATER	Replace hot water cabinet heater with electric cabinet heater with integral thermostat, same location. Delete hot water piping. Power by EC.
DELETE FCU - ELEC. UNIT HEATER	Delete hot water / glycol FCU. Electric unit heater with integral thermostat. DOAS branch duct extended directly to the room diffuser; return grille deleted.
DELETE FCU - SEE RFI-01	Delete heating-only FCU. Room needs cooling / ventilation, not heat: see RFI-01 (not priced).
NO CHANGE	No change (pool / sauna area by others, or not part of this VE).

VAV boxes (47 on the drawings)

Cancel 18 / keep with electric reheat 25 / keep without reheat 4 / no change 1 (one tag, VAV-18, appears twice on M2010). Electric reheat kW = scheduled hot water reheat MBH / 3.412, rounded up to 0.5 kW (approx., final sizing by IMEG): total about 97 kW connected, versus about 185 kW if all 47 boxes were electric.

Sheet	VAV	Room / area served	Note	Proposal	Elec. heat
M2010	VAV-1	Movement Studio 1045		KEEP VAV - ELEC. REHEAT	8 kW
M2010	VAV-2	Fitness 1044		KEEP VAV - ELEC. REHEAT	13 kW
M2010	VAV-3	Multi-Purpose Room 1043		KEEP VAV - ELEC. REHEAT	11 kW
M2010	VAV-4	Theater 1042		KEEP VAV - ELEC. REHEAT	4 kW
M2010	VAV-5	Corridor / gallery		CANCEL VAV	-
M2010	VAV-6	Corridor		CANCEL VAV	-
M2010	VAV-7	Spa / Salon 1041A		KEEP VAV - ELEC. REHEAT	2.5 kW
M2010	VAV-8	IT Office 1036 / AV Closet		KEEP VAV - NO REHEAT	-
M2010	VAV-9	Gen. Manager Office 1035		KEEP VAV - ELEC. REHEAT	1.5 kW
M2010	VAV-10	Locker rooms / sauna (pool area)	Pool / sauna by others - not marked	NO CHANGE	-
M2010	VAV-11	Art 1032		KEEP VAV - ELEC. REHEAT	5 kW
M2010	VAV-12	Lounge 1004A		CANCEL VAV	-
M2010	VAV-13	Lounge / Bistro 1004A-B		CANCEL VAV	-
M2010	VAV-14	Security 1033 / Package 1003B		KEEP VAV - NO REHEAT	-
M2010	VAV-15	AVC 1034B		KEEP VAV - ELEC. REHEAT	2.5 kW
M2010	VAV-16	Sales Office 1034C		KEEP VAV - ELEC. REHEAT	3 kW
M2010	VAV-17	Family Meeting Room 1002		KEEP VAV - ELEC. REHEAT	4.5 kW
M2010	VAV-18	Reception 1003A		CANCEL VAV	-
M2010	VAV-18	Treatment Rm 1041C	Tag duplicated on drawing - clarify	KEEP VAV - ELEC. REHEAT	3 kW
M2010	VAV-19	Coffee Shop 1006		CANCEL VAV	-



NORTHERN WOLVES
AIR CONDITIONING

Ref. Quote: 3112 / Date: 10/6/2026 / Rev 1

Customer
Callahan Construction Managers

Sheet	VAV	Room / area served	Note	Proposal	Elec. heat
M2010	VAV-20	Library 1007		KEEP VAV - ELEC. REHEAT	1.5 kW
M2010	VAV-21	Store 1008		KEEP VAV - ELEC. REHEAT	1.5 kW
M2010	VAV-22	Activity Room 1009		KEEP VAV - ELEC. REHEAT	2.5 kW
M2010	VAV-24	Bistro 1004B		CANCEL VAV	-
M2011	VAV-23	Restrooms 1012-1013 / Mailroom		CANCEL VAV	-
M2011	VAV-25	Casual Dining 1015		CANCEL VAV	-
M2011	VAV-26	Private Dining 1016		KEEP VAV - ELEC. REHEAT	2.5 kW
M2011	VAV-27	Formal Dining 1017		CANCEL VAV	-
M2011	VAV-28	Restrooms / kitchen corridor		CANCEL VAV	-
M2011	VAV-29	Main Kitchen 1019		CANCEL VAV	-
M2011	VAV-30	Private Dining 130 / Dry Storage		KEEP VAV - ELEC. REHEAT	2.5 kW
M2011	VAV-31	Storage 1031 / Trash 1030 / Receiving		KEEP VAV - NO REHEAT	-
M2011	VAV-32	Chef Office 1027		KEEP VAV - NO REHEAT	-
M2011	VAV-33	AL Dining 128		CANCEL VAV	-
M2013	VAV-34	Bistro 127		CANCEL VAV	-
M2013	VAV-35	Bistro / dining 127		CANCEL VAV	-
M2013	VAV-36	Parlor 131		CANCEL VAV	-
M2013	VAV-37	Reception 126		CANCEL VAV	-
M2013	VAV-38	Family Room 120		KEEP VAV - ELEC. REHEAT	3.5 kW
M2013	VAV-39	Work Room / Sales / Exec. Director		KEEP VAV - ELEC. REHEAT	3 kW
M2013	VAV-40	Corridor 100C		CANCEL VAV	-
M2013	VAV-41	Salon 132A		KEEP VAV - ELEC. REHEAT	1.5 kW
M2013	VAV-42	Theater 135		KEEP VAV - ELEC. REHEAT	2.5 kW
M2013	VAV-43	Activity 136		KEEP VAV - ELEC. REHEAT	4 kW
M2013	VAV-44	Fitness 141		KEEP VAV - ELEC. REHEAT	5 kW
M2013	VAV-45	Fitness / Wellness Office		KEEP VAV - ELEC. REHEAT	3.5 kW
M2013	VAV-46	Wellness Office		KEEP VAV - ELEC. REHEAT	2.5 kW
M2013	VAV-47	Exam / AVC Office		KEEP VAV - ELEC. REHEAT	3 kW
		Total electric reheat			97 kW

Cabinet heaters (VE-04)

All hot water cabinet heaters on the plans become electric with integral thermostats. CH-8 is in the schedule but not shown on the plans; CH-2 is not used. Please confirm.

Sheet	Tag	Location	Proposal	Elec. heat
M2010	CH-1	Movement Studio entry	ELECTRIC CABINET HEATER	5.3 kW
M2010	CH-3	Pool deck / stair entry	ELECTRIC CABINET HEATER	5.3 kW
M2010	CH-4	Exterior door at gallery	ELECTRIC CABINET HEATER	5.3 kW
M2010	CH-5	Fitness entry	ELECTRIC CABINET HEATER	5.3 kW
M2010	CH-12	Multi-Purpose Room entry	ELECTRIC CABINET HEATER	5.3 kW
M2010	CH-6	Vestibule 1001	ELECTRIC CABINET HEATER	5.3 kW
M2011	CH-7	Formal Dining entry	ELECTRIC CABINET HEATER	5.3 kW
M2011	CH-9	Trash 1030 / Storage	ELECTRIC CABINET HEATER	10.4 kW
M2011	CH-10	Casual Dining entry	ELECTRIC CABINET HEATER	5.3 kW
M2011	CH-11	Casual Dining entry	ELECTRIC CABINET HEATER	5.3 kW
		Total (scheduled MBH / 3.412)		58.1 kW



NORTHERN WOLVES
AIR CONDITIONING


Ref. Quote: 3112 / Date: 10/6/2026 / Rev 1

Customer
Callahan Construction Managers

Basement fan coil units (VE-05)

Sheet	Tag	Room	Proposal	Elec. heat
M2000	FCU	Residents' Storage B107	DELETE FCU - ELEC. UNIT HEATER	3 kW
M2000	FCU-A	Trash Collection B106 (exhaust make-up)	DELETE FCU - ELEC. UNIT HEATER	5 kW
M2002	FCU	Kitchen Storage B113	DELETE FCU - ELEC. UNIT HEATER	5 kW
M2002	FCU	Corridor B100	DELETE FCU - ELEC. UNIT HEATER	3 kW
M2002	FCU	Residents' Storage B115	DELETE FCU - ELEC. UNIT HEATER	3 kW
M2002	FCU	Team Member Lounge B119A	DELETE FCU - ELEC. UNIT HEATER	3 kW
M2002	FCU	Mechanical B118	DELETE FCU - ELEC. UNIT HEATER	5 kW
M2002	FCU	Trash room, AL south (400 CFM exhaust make-up)	DELETE FCU - ELEC. UNIT HEATER	5 kW
M2002	FCU	Storage room, AL south	DELETE FCU - ELEC. UNIT HEATER	3 kW
M2002	FCU	Electrical B123	DELETE FCU - SEE RFI-01	RFI-01
M2002	FCU	Central Laundry B121	DELETE FCU - SEE RFI-01	RFI-01
		Total electric unit heaters		35 kW

FCU schedule data is blank, so unit heater kW is approximate by room use: 3 kW storage / corridor / lounge, 5 kW larger rooms and trash rooms (exhaust make-up air). Final sizing by IMEG. DX-FCUs on M2002 are not changed.

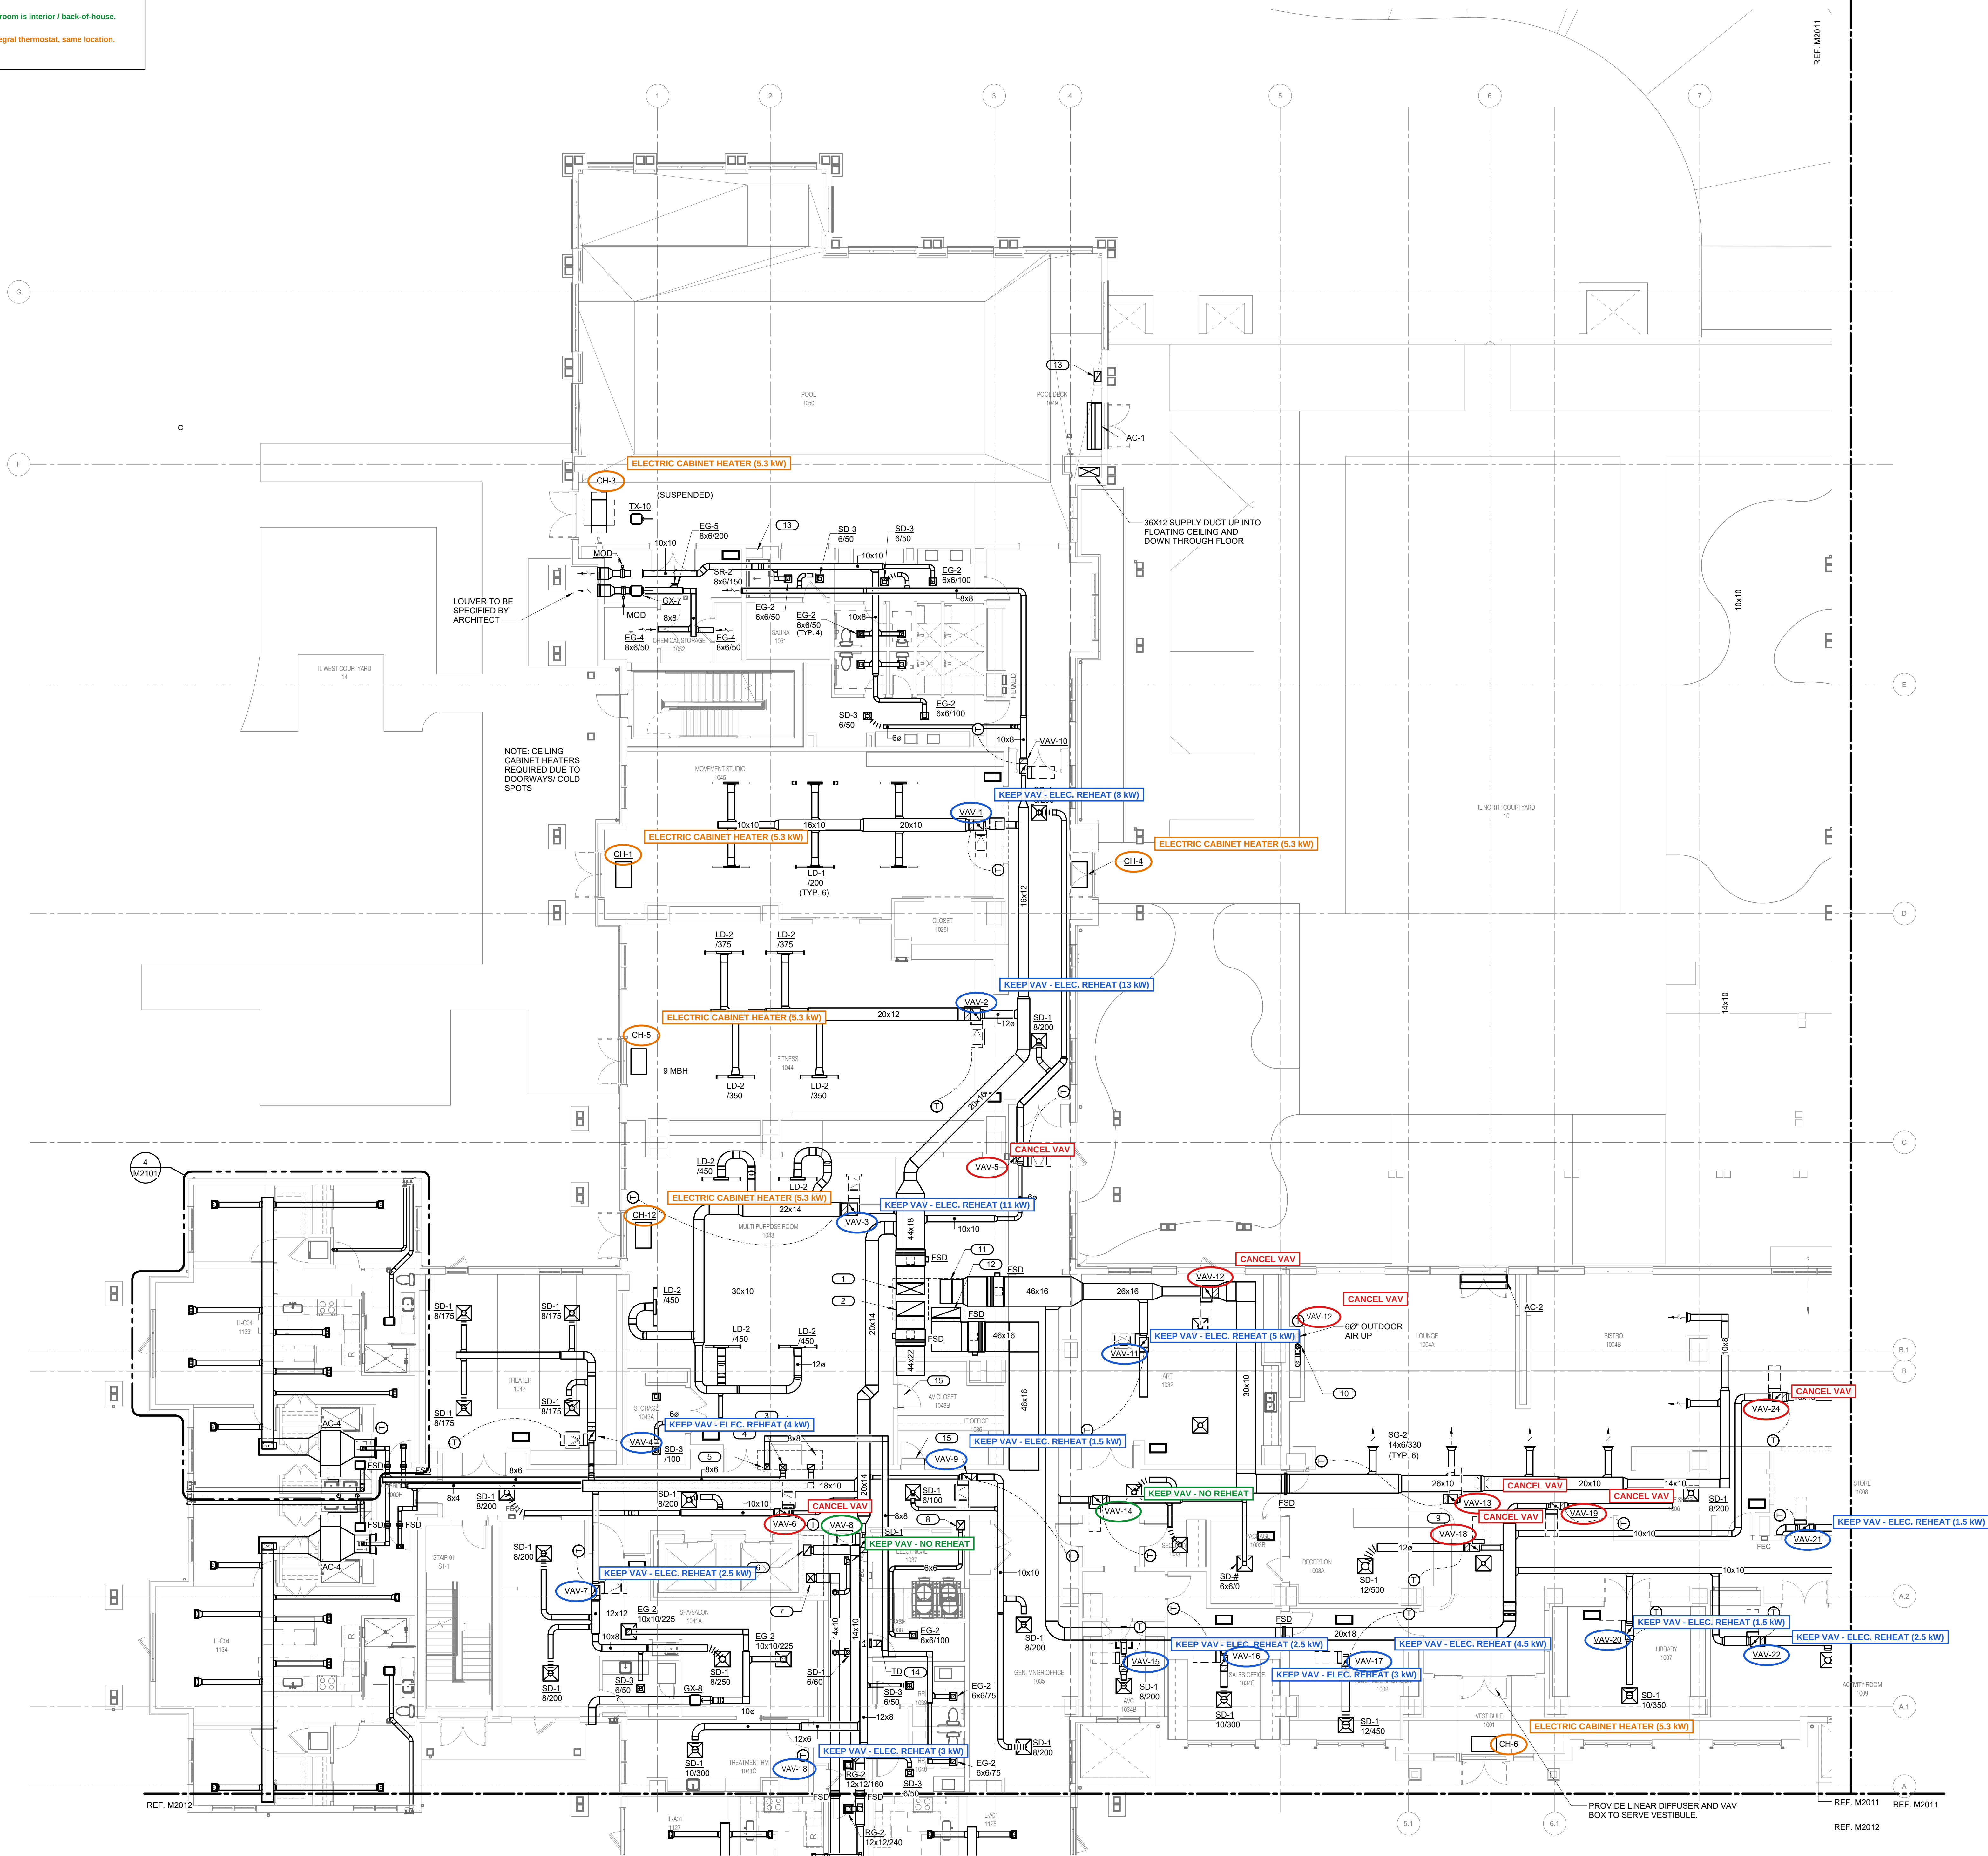

KEYNOTES:

- 44x24 SUPPLY AIR DUCT UP THROUGH CHASE TO RTU-1.
- 44x24 RETURN AIR DUCT UP THROUGH CHASE TO RTU-1.
- 12x6 RETURN AIR DUCT UP THROUGH CHASE TO DOAS-1.
- 10x10 SUPPLY AIR DUCT UP THROUGH CHASE TO DOAS-1.
- 8x8 TOILET EXHAUST AIR DUCT UP THROUGH CHASE TO TX-1 ON ROOF.
- 18x12 RETURN AIR DUCT UP THROUGH CHASE TO DOAS-3.
- 14x12 SUPPLY AIR DUCT UP THROUGH CHASE TO DOAS-3.
- 10" EXHAUST AIR SERVING TRASH ROOM UP THROUGH CHASE TO ROOF.
- VAV UNITS TO REQUIRE ACCESS PANEL IN CEILING. COORDINATE ACCESS PANEL LOCATION WITH FINAL RCP. (TYP. ALL)
- 80" 10/100" CO-FIREPLACE CHIMNEY UP.
- 38x18 SUPPLY DUCT UP THROUGH CHASE TO RTU-2.
- 48x16 RETURN DUCT UP THROUGH CHASE TO RTU-2.
- 12x10 LOW RETURN DUCT UP AND DOWN IN BUMP OUT.
- PROVIDE 8"x6" TRANSFER AIR DUCT THROUGH WALL WITH FIRE/SMOKE DAMPER AS REQUIRED.
- PROVIDE 1-TON WALL MOUNTED MINI-SPLIT. ROUTE REFRIGERANT TO CONDENSING UNIT ON ROOF.

HKS

ARCHITECT
HKS ARCHITECTS, P.C.
30 WEST 26th STREET, 12th FLOOR
NEW YORK, NY 10010

STRUCTURAL
IMEG
1411 BROADWAY, SUITE 600
NEW YORK, NY 10018

MEP ENGINEER
IMEG
177 CROSWAYS PARK DRIVE
WOODBURY, NY 11797

LV ENGINEER
TATEROY
7653 HICKORY FLAT HWY, SUITE 200
WOODSTOCK, GA 30188

LANDSCAPE ARCHITECT
MFPF
120 BROADWAY, 20TH FLOOR
NEW YORK, NY 10021

POOL DESIGNER
COUNSLMANHUNSAKER & ASSOCIATES, INC.
12851 MANCHESTER ROAD, SUITE 120
ST. LOUIS, MO 63131

FOOD SERVICE & LAUNDRY
CLARK
2551 HORSESHOE RD.
LANCASTER, PA 17601


SUNRISE
SENIOR LIVING
RYE BROOK

DOB BSCAN / DOB STAMP & SIGNATURES

SEAL & SIGNATURE

CON NO.: 111AAA

KEY PLAN

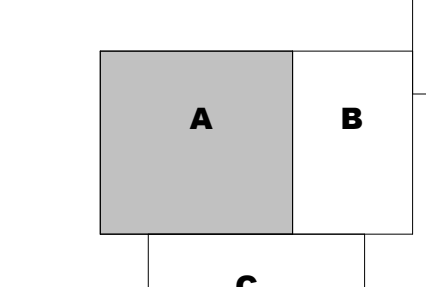

REVISION	
NO.	DESCRIPTION
1	DD Progress Print
2	DESIGN DEVELOPMENT
3	EXTERIOR BUILDING PERMIT
4	100% DESIGN DEVELOPMENT
5	ISSUED FOR PERMIT

IMEG

177 CROSWAYS PARK DRIVE
WOODBURY, NY 11797
P: 516-527-6900

IMEG RESERVES PROPRIETARY RIGHTS, INCLUDING COPYRIGHTS, TO THE DESIGN AND THE DATA SHOWN HEREON. NO REPRODUCTION AND/OR DATA ARE THE EXCLUSIVE PROPERTY OF IMEG AND SHALL NOT BE USED OR REPRODUCED FOR ANY OTHER PROJECT WITHOUT THE EXPRESS WRITTEN APPROVAL AND PARTICIPATION OF IMEG. ©2026 IMEG CONSULTANTS CORP.

REF. SCALE IN INCHES PROJECT #2004064.00

HKS PROJECT NUMBER
25004064.00

DATE
07/15/26

ISSUE
ISSUED FOR GMP

SHEET TITLE
**INDEPENDENT LIVING
FIRST FLOOR PLAN -
MECHANICAL IL AREA**

A/E/T NO.
M2010

DOB FILE # DOB PAGE #



1 INDEPENDENT LIVING FIRST FLOOR PLAN - MECHANICAL IL AREA A

1/8" = 1'-0"

NORTHERN WOLVES AC - VALUE ENGINEERING MARK-UP Rev 1 10/6/2026


Sheet M2011 (GMP set 07.15.2026). For discussion - not a design document.

CANCEL VAV (8): Cancel VAV box (open area / circulation). Branch duct stays with manual volume damper, balanced to design max CFM; area served directly by the RTU (RTU space sensor here). Gas heat from the RTU.

KEEP VAV - ELEC. REHEAT (2): Keep VAV box. Electric reheat coil with SCR in lieu of hot water coil; simple standalone thermostat. No hot water piping or control valve.

KEEP VAV - NO REHEAT (2): Keep VAV box, cooling only. No reheat required; RTU is gas heat and the room is interior / back-of-house. Standalone thermostat.

ELECTRIC CABINET HEATER (4): Replace hot water cabinet heater with electric cabinet heater with integral thermostat, same location. Delete hot water piping. Power by EC.

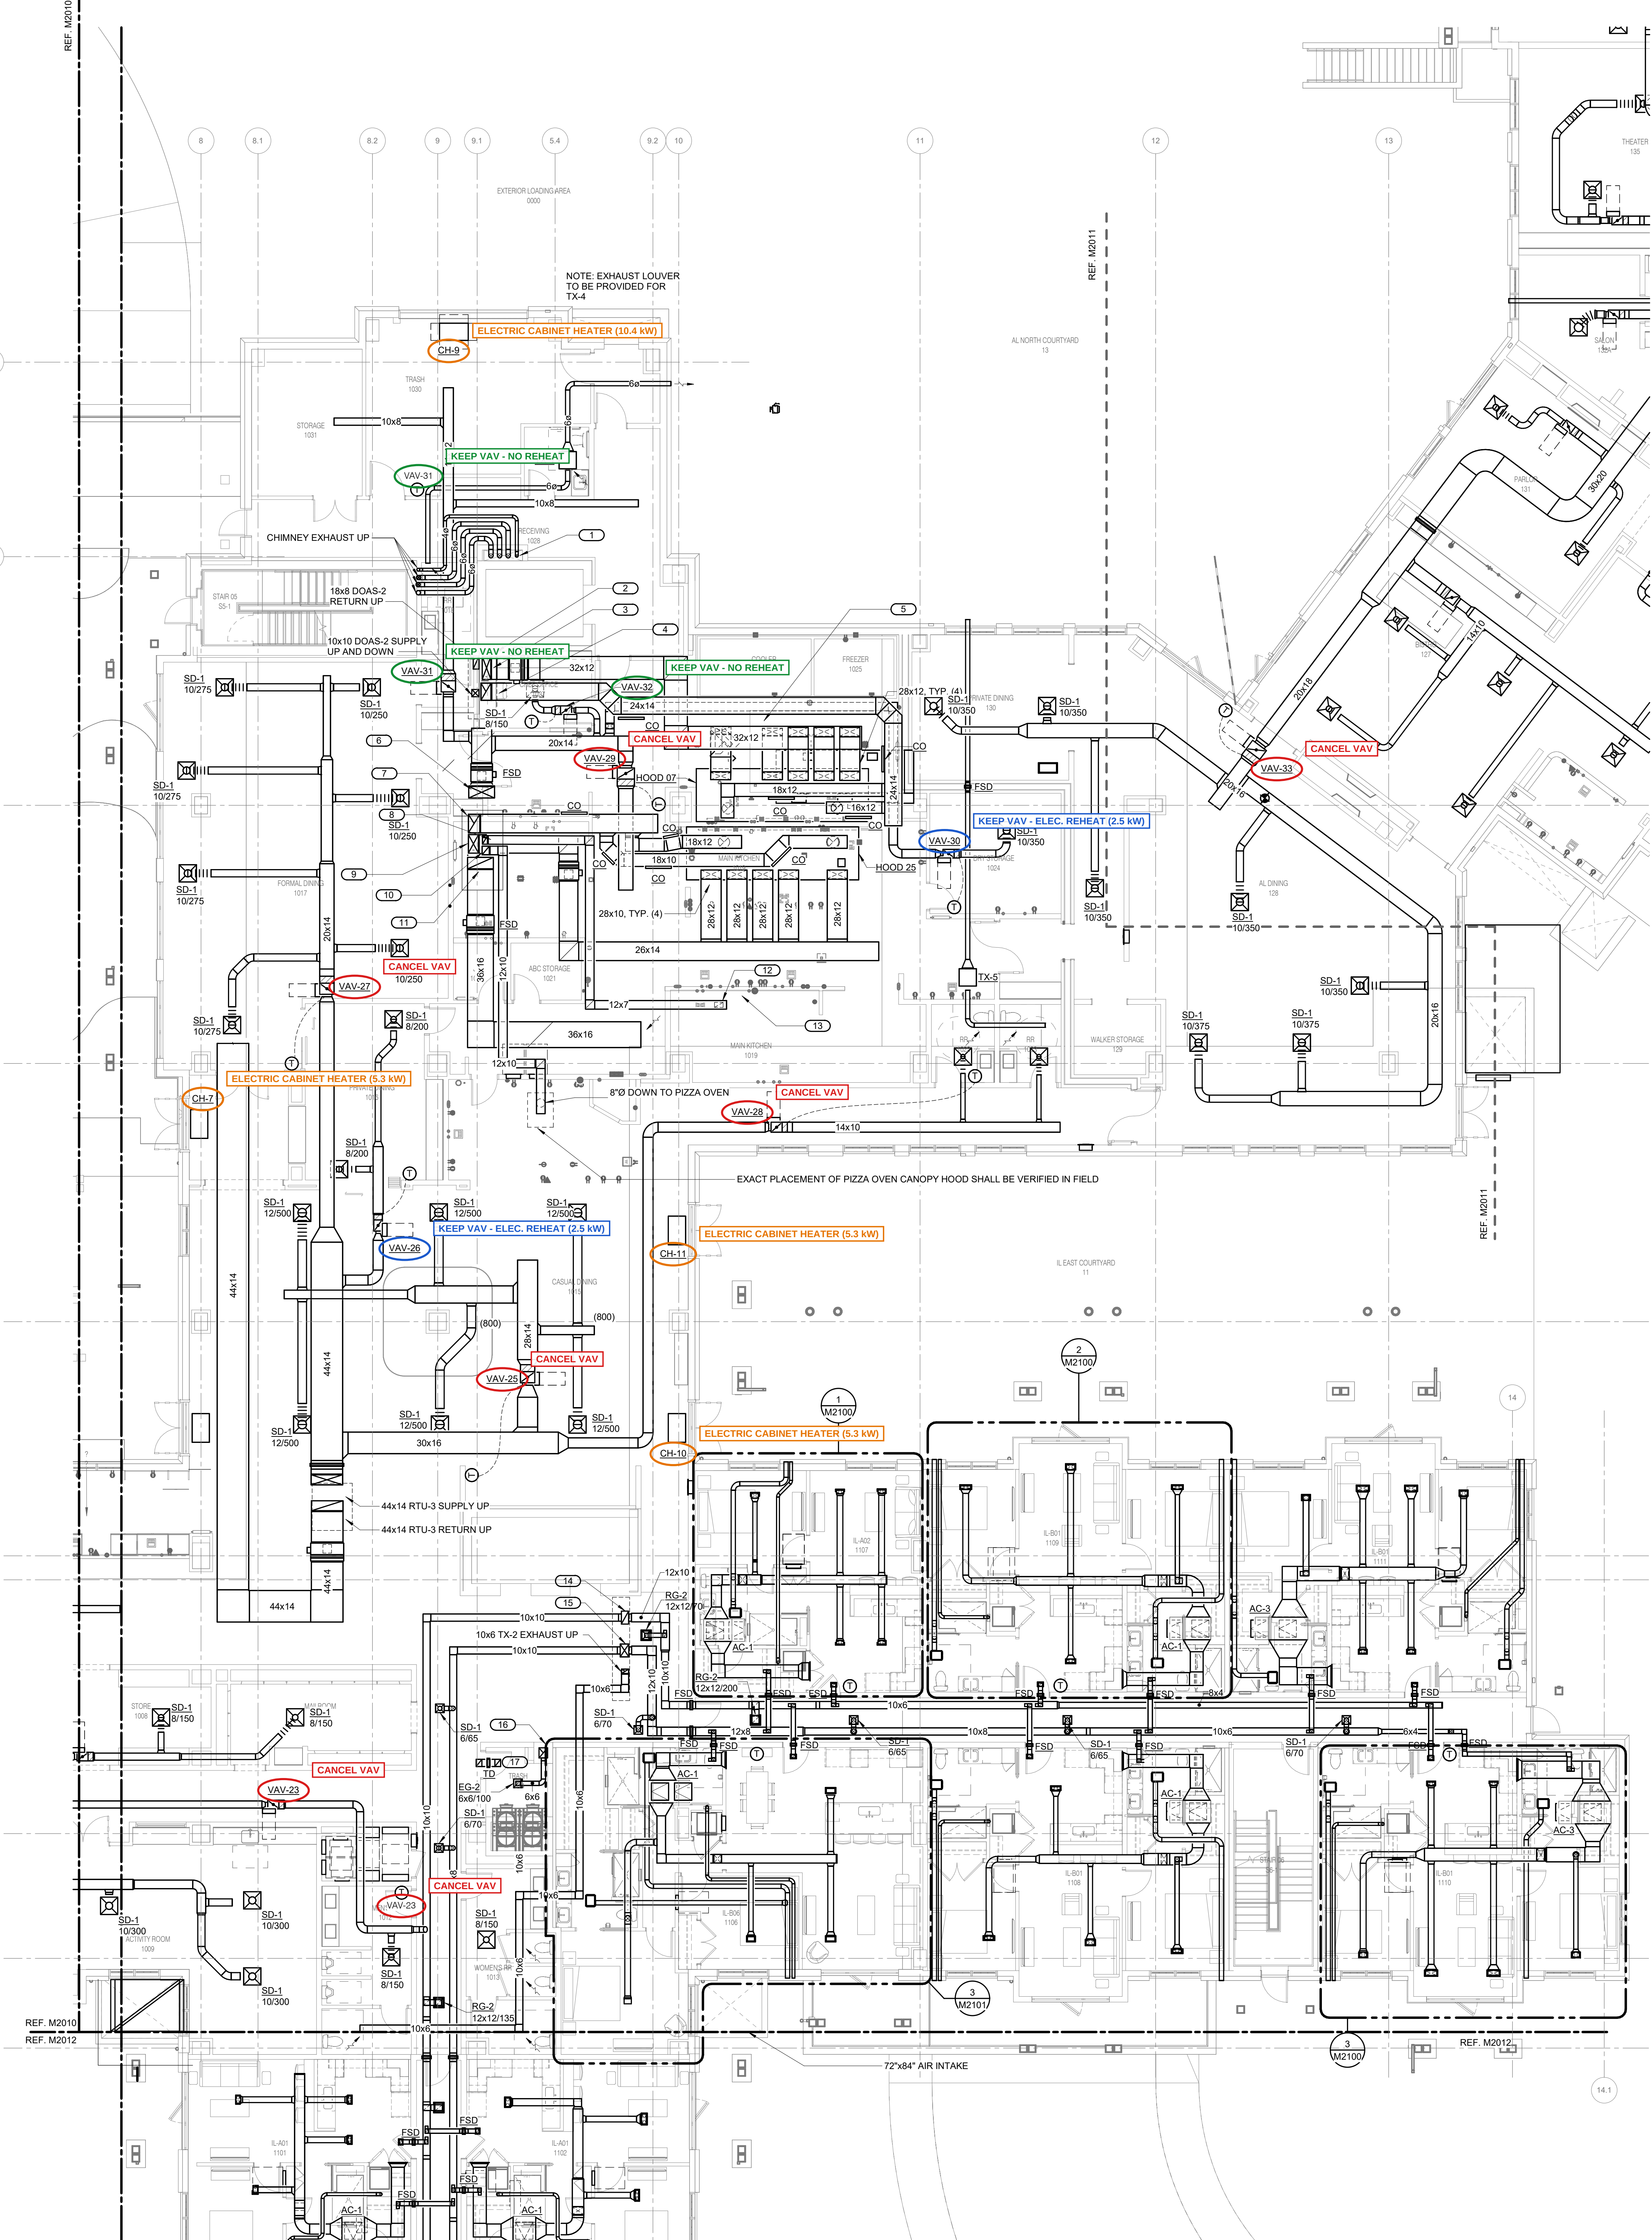

- SHEET NOTES:**
- KITCHEN HOOD GREASE EXHAUST DUCTS REQUIRE CLEAN OUT ACCESS DOORS AT EVERY CHANGE IN DIRECTION. THERE SHALL BE NO PIPING, CONDUIT, OR APPLIANCES BELOW WHERE ACCESS DOORS ARE PLACED.
 - ALL KITCHEN HOOD GREASE EXHAUST DUCTWORK SHALL BE WRAPPED WITH (2) LAYERS OF MORGAN FAST WRAP. REFER TO DETAILS AND SPECIFICATIONS.
 - ALL TYPE I GREASE EXHAUST DUCTWORK IN CEILING AND IN DUCT SHAFT SHALL BE WRAPPED WITH (2) LAYERS OF MORGAN FAST WRAP. FOLLOW MANUFACTURER'S INSTALLATION RECOMMENDATIONS ON GREASE DUCT INSTALLATION UP TO UNDERSIDE OF ROOF. FOLLOW MANUFACTURER'S INSTRUCTIONS FOR ACCESS DOORS IN VERTICAL DUCT SHAFTS. GO TO COORDINATE FIRE RATED ACCESS DOORS IN CORRIDOR LOCATIONS.

- KEYNOTES:**
- FIRE RATED CHIMNEY ENCLOSURE REQUIRED FROM BASEMENT CEILING TO ROOF.
 - OUTLINE OF DUCT SHAFT ABOVE.
 - 32x12 SUPPLY AIR DUCT UP AND DOWN (SERVING KITCHEN HOOD) THROUGH CHASE TO DOAS-6. PROVIDE FSD WHERE DUCT LEAVES CHASE.
 - 24x14 GREASE DUCT UP AND DOWN (SERVING KITCHEN HOOD 07) IN CHASE.
 - 18" CLEAR FOR CO ACCESS FOR A PERSON ON LADDER BELOW.
 - 36x16 RTU-4 SUPPLY UP IN SHAFT.
 - 36x16 KITCHEN HOOD 25 GREASE DUCT UP IN SHAFT.
 - 12x7 DISHWASHER EXHAUST UP IN SHAFT.
 - 28x14 DOAS-7 KITCHEN HOOD 25 SUPPLY AIR UP IN SHAFT W/ FSD.
 - 12x10 PIZZA OVEN EXHAUST UP IN SHAFT.
 - 36x16 RETURN AIR DUCT UP AND DOWN THROUGH CHASE TO RTU-4.
 - 12x6 DISH WASHER EXHAUST AIR DUCT UP AND DOWN IN CHASE.
 - EXACT PLACEMENT OF DISHWASHER SHALL BE VERIFIED.
 - 18x10 SUPPLY AIR DUCT UP AND DOWN THROUGH CHASE TO DOAS-4. PROVIDE FSD WHERE DUCT LEAVES CHASE.
 - 18x12 SUPPLY AIR DUCT UP AND DOWN THROUGH CHASE TO DOAS-4. PROVIDE FSD WHERE DUCT LEAVES CHASE.
 - 12x14 TRASH EXHAUST UP IN SHAFT.
 - PROVIDE 8"x6" TRANSFER AIR DUCT THROUGH WALL WITH FIRE/SMOKE DAMPER AS REQUIRED.

HKS

ARCHITECT
HKS ARCHITECTS, P.C.
30 WEST 29th STREET, 12th FLOOR
NEW YORK, NY 10010

STRUCTURAL
IMEG
1411 BROADWAY, SUITE 600
NEW YORK, NY 10018

MEP ENGINEER
IMEG
177 CROSWAYS PARK DRIVE
WOODBURY, NY 11797

LV ENGINEER
TATEROY
765 HICKORY FLAT HWY, SUITE 200
WOODSTOCK, GA 30188

LANDSCAPE ARCHITECT
MFPF
120 BROADWAY, 20TH FLOOR
NEW YORK, NY 10021

POOL DESIGNER
COUNSLMAN-HUNSAKER & ASSOCIATES, INC.
12651 MANCHESTER ROAD, SUITE 120
ST. LOUIS, MO 63131


FOOD SERVICE & LAUNDRY
CLARK
2551 HORSEHOE RD.
LANCASTER, PA 17601

SUNRISE SENIOR LIVING
RYE BROOK

DOB.BSCAN | DOB STAMP & SIGNATURES

SEAL & SIGNATURE

CON NO.: 111AAA
KEY PLAN

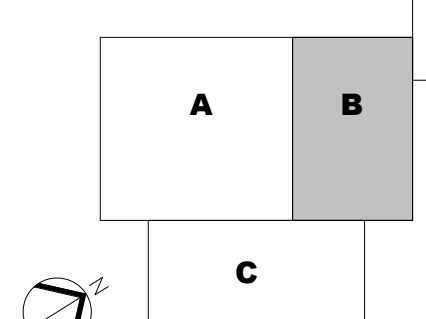

REVISION	
NO.	DESCRIPTION
1	DD Progress Print
2	DESIGN DEVELOPMENT
3	EXTERIOR BUILDING PERMIT
4	100% DESIGN DEVELOPMENT
5	ISSUED FOR PERMIT


HKS PROJECT NUMBER
25004064.00

DATE
07/15/26

ISSUE
ISSUED FOR GMP

SHEET TITLE
INDEPENDENT LIVING
FIRST FLOOR PLAN -
MECHANICAL IL AREA

SHEET NO.
M2011

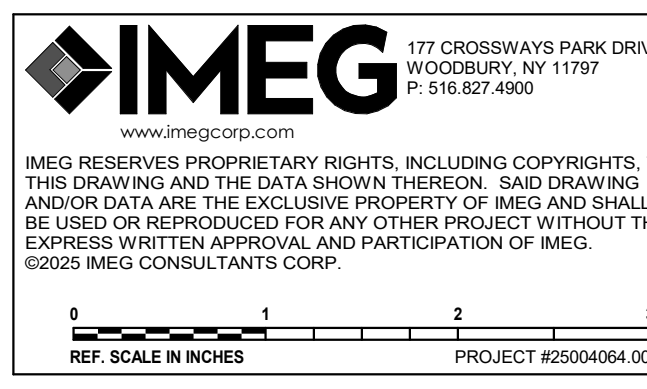

1 INDEPENDENT LIVING FIRST FLOOR PLAN - MECHANICAL IL AREA B

PRINT DATE: 7/15/2026 12:30:27 PM TEMPLATE VERSION: 23.0.4

SEAL & SIGNATURE _____

KEY PLAN _____




REVISION		
NO.	DESCRIPTION	DATE
1	DD Progress Point	08/28/25
2	DESIGN DEVELOPMENT	11/25/25
3	EXTERIOR BUILDING PERMIT	12/23/25
4	100% DESIGN DEVELOPMENT	01/30/26
5	ISSUED FOR PERMIT	08/05/26

ISSUED F


MECHANISMS

B FILE #: _____ DOB PAGE #: _____

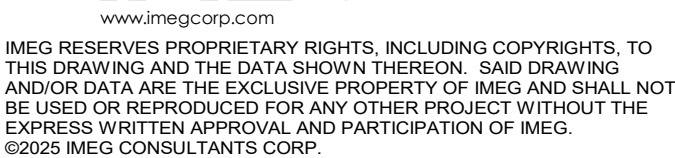
$$1/8'' = 1'-0''$$


0 1 2 3
REF. SCALE IN INCHES PROJECT #25004(64.00)


© HKS INC.

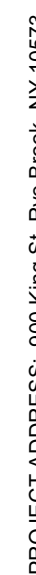
$$1/8^{\circ} = 1'0''$$


DOB BSCAN | DOB STAMP & SIGNATURES

SEAL & SIGNATURE

CON NO.: 111AM
KEY PLAN_____

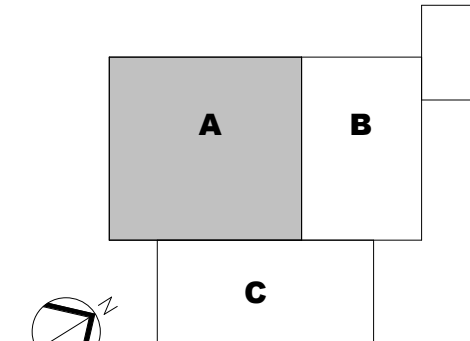


REVISION		
NO.	DESCRIPTION	DATE
1	DD Progress Print	09/26/25
2	DESIGN DEVELOPMENT	11/25/25
3	EXTERIOR BUILDING PERMIT	12/23/25
4	100% DESIGN DEVELOPMENT	01/30/26
5	ISSUED FOR PERMIT	06/05/26

SHEET TITLE
**INDEPENDENT LIVING
BASEMENT PLAN -
MECHANICAL**

SHEET NO.

M2000

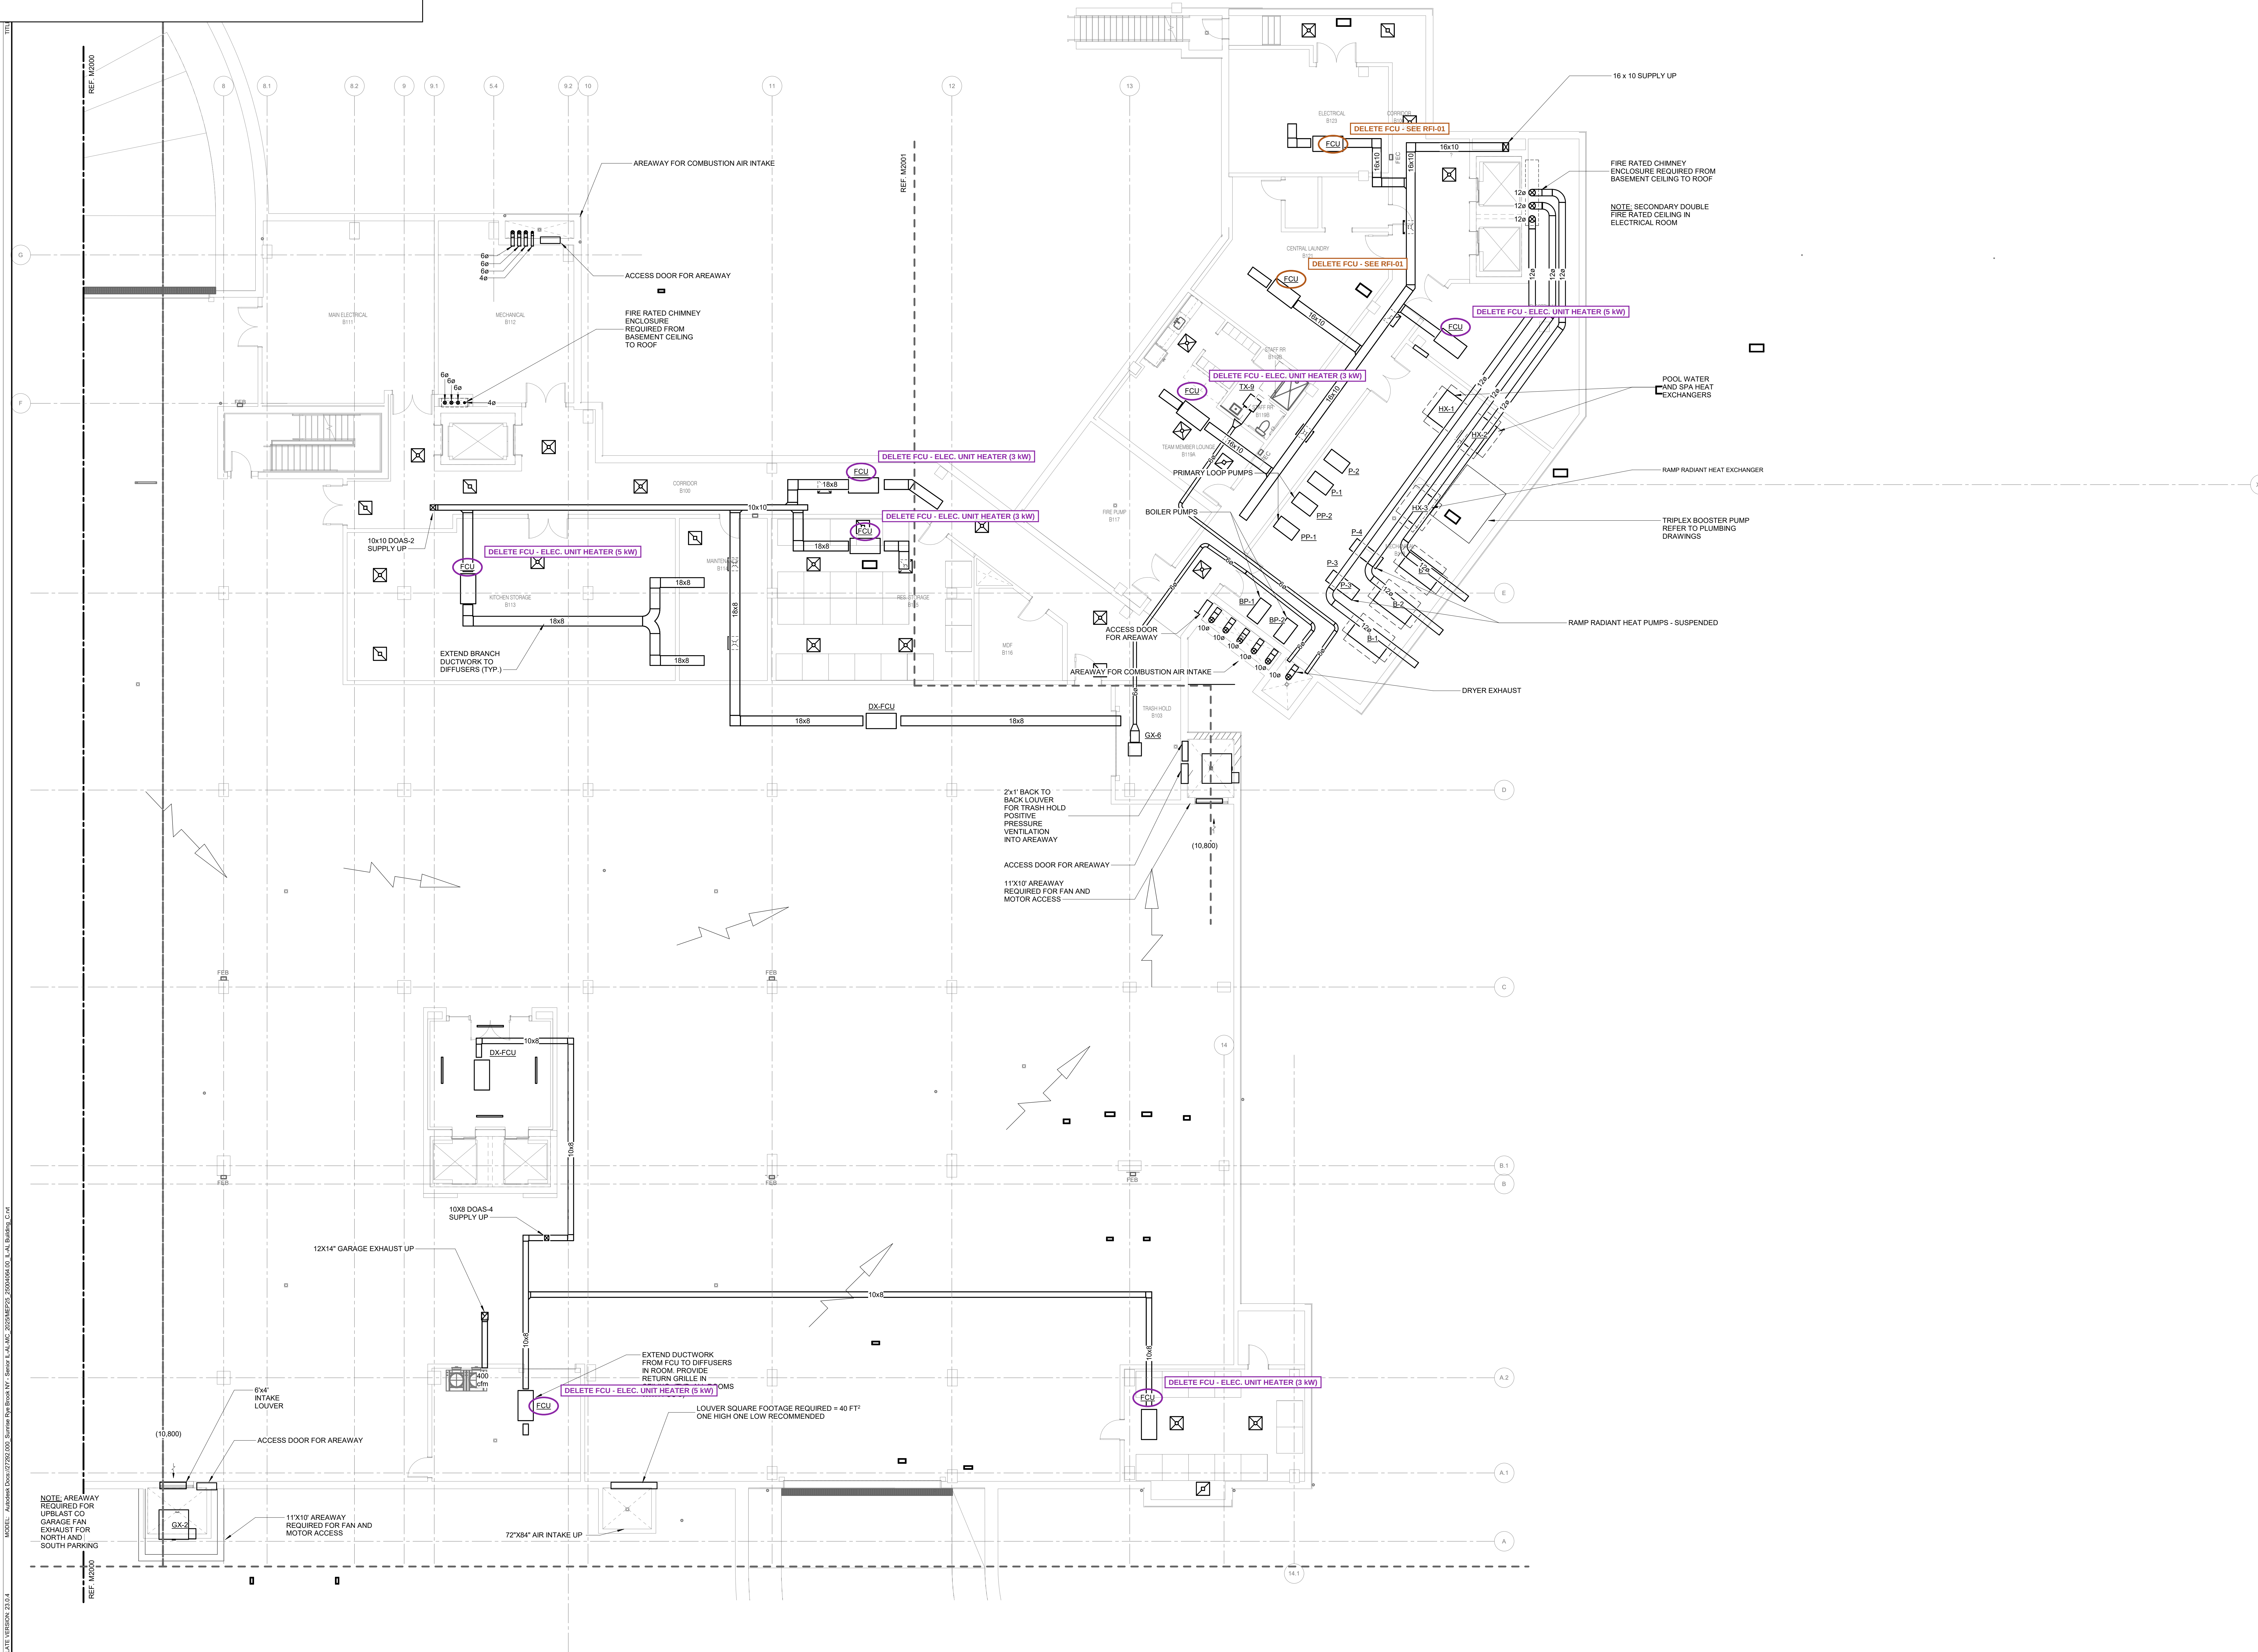

NOTE: AREAWAY REQUIRED FOR UPBLAST CO. GARAGE FAN EXHAUST FOR NORTH AND SOUTH PARKING

11'X10' AREAWAY REQUIRED FOR FAN AND MOTOR ACCESS

72'X24' AIR INTAKE UP

LOUVER SQUARE FOOTAGE REQUIRED = 40 FT² ONE HIGH ONE LOW RECOMMENDED

EXTEND DUCTWORK FROM FCU TO DIFFUSERS IN ROOM. PROVIDE RETURN GRILLE IN ROOMS

10'X8 DOAS-4 SUPPLY UP

12'X14' GARAGE EXHAUST UP

6'X4' INTAKE LOUVER

ACCESS DOOR FOR AREAWAY

10'X8 DOAS-2 SUPPLY UP

EXTEND BRANCH DUCTWORK TO DIFFUSERS (TYP.)

KITCHEN STORAGE B113

MECHANICAL B112

MAN. ELECTRICAL B111

CORRIDOR B109

MEP B115

TEAM MEMBER LOUNGE B116A

TRASH HOLD B113

BOILER PUMPS

PRIMARY LOOP PUMPS

TRASH HOLD B113

2'X1' BACK TO BACK LOUVER FOR TRASH HOLD POSITIVE PRESSURE VENTILATION INTO AREAWAY

ACCESS DOOR FOR AREAWAY

11'X10' AREAWAY REQUIRED FOR FAN AND MOTOR ACCESS

AREAWAY FOR COMBUSTION AIR INTAKE

18'X8

18'X8

NORTHERN WOLVES
AIR CONDITIONING

Ref. Quote: 3112 / Date: 10/6/2026 / Rev 1

Customer
Callahan Construction Managers

RFI-01 - Cooling and ventilation of equipment rooms (to IMEG)

To: IMEG (via Callahan Construction Managers). From: Northern Wolves AC. Date: 10/6/2026. Reference: mechanical GMP set dated 07.15.2026, sheets M2000, M2002, M2013, M6000. Not included in our VE proposals or pricing.

#	Room	Question
1	Electrical rooms B111 (Main Electrical), B120, B122 and B123	No cooling or ventilation is scheduled; B123 has a heating-only FCU. Transformer and switchgear heat is year-round. Please confirm the design heat load and provide cooling or thermostatic ventilation (ductless AC or exhaust / transfer fan) as required.
2	MDF B116 and IDF rooms (IDF 123 on 1st floor, IDF B134)	Please confirm the cooling source for the MDF / IDF rooms (24/7 load). A DX-FCU is shown near B115 / B116 on M2002 - confirm it serves the MDF and provide its schedule data.
3	Central Laundry B121	Heating-only FCU shown. Dryer heat and make-up air for the dryers: please confirm make-up air, exhaust and cooling / ventilation requirements for the laundry.
4	Mechanical B112 / B118 (with VE-01 boiler plant deleted)	Please confirm the ventilation requirement for the mechanical rooms once the boilers are deleted.

Response requested: design load and the system to be provided for each room, so it can be priced separately.