

Basis of this breakdown

- Bulletin 3 (M-529 / M-530 / M-531, revision 4, 08/10/2026) was issued after the ductwork in the affected areas had been fabricated and installed per the Addendum 1 drawings. The change therefore includes **disconnecting and removing installed ductwork**, in addition to fabricating and installing the revised work.
- Each floor is shown with the Addendum 1 drawing ("Before") overlaid on the Bulletin 3 drawing ("After"). Every change area is numbered and has its own detail page with the before, after and overlay views and the cost for that area.
- Costs are the COP-SF-05 line items spread over the change areas: disconnect / removal labor, ductwork material (fabricated duct, fittings, insulation, accessories), ductwork relocation / install labor, air outlet material, air outlet labor and shop drawings. Labor is at \$125.00 per man-hour as submitted.
- Floor totals match the per-floor breakdown previously provided. Category totals match the COP-SF-05 line items. Quantities (LF) are approximate, taken from the drawings at 1/8" = 1'-0".
- Red revision clouds in the overlays are Addendum 1 clouds that were dropped from Bulletin 3; moved tags and labels also show in red / blue. Only the ductwork within the numbered areas is priced.

- Unchanged
- Addendum 1 only - installed, removed
- Bulletin 3 only - new work

COP-SF-05 line items (as submitted)

Line item	Amount
Labor for demolition work (40 MH @ \$125)	\$5,000
Fabricated ductwork	\$18,180
Labor for relocation and installation of new ductwork (280 MH @ \$125)	\$35,000
Cost of air outlets	\$3,600
Labor for installation of air outlets (16 MH @ \$125)	\$2,000
Drafting fees (shop drawings for revised design)	\$3,000
Total COP-SF-05	\$66,780

Summary by floor


Floor	Disconnect / removal labor	Ductwork material	Ductwork install labor	Air outlet material	Air outlet labor	Shop drawings	Total
29th floor (M-529.00)	\$2,000	\$9,100	\$17,500	-	-	\$1,000	\$29,600
30th floor (M-530.00)	\$1,500	\$4,700	\$8,750	\$2,700	\$1,500	\$1,000	\$20,150
31th floor (M-531.00)	\$1,500	\$4,380	\$8,750	\$900	\$500	\$1,000	\$17,030
Total	\$5,000	\$18,180	\$35,000	\$3,600	\$2,000	\$3,000	\$66,780
Man-hours	40 MH		280 MH		16 MH		

Change areas

Area	Description	Total
29-1	North supply main - reroute through existing beam cuts	\$11,850
29-2	Supply main resized 56x16 to 42x12	\$11,025
29-3	FPB-HW-E (1400) relocation and discharge reroute	\$5,725
30-1	IT Build Rm 30.23 / F&B Storage 30.14 / west dining	\$8,850
30-2	Lounge 30.02 - new transfer ducts	\$3,550
30-3	Meeting Rms 30.04 / 30.05, Storage 30.09, Vestibule 30.07	\$6,750
31-1	Zoom rooms, northwest - transfer ducts	\$1,205
31-2	Transfer duct TD 32x16, north	\$1,050
31-3	Storage 31.02 - new transfer ducts	\$2,650
31-4	Coffee Bar 31.12 - transfer ducts and main fitting	\$3,850
31-5	Transfer duct TD 32x16, southwest	\$1,050
31-6	Storage 31.15 / Room 31.16, southeast	\$6,225
	Shop drawings (29 / 30 / 31, \$1,000 each)	\$3,000
	Total	\$66,780

NORTHERN WOLVES AC

Snowflake Fitout - 7 Times Square, Floors 29-31 | COP-SF-05 Bulletin 3 Revision



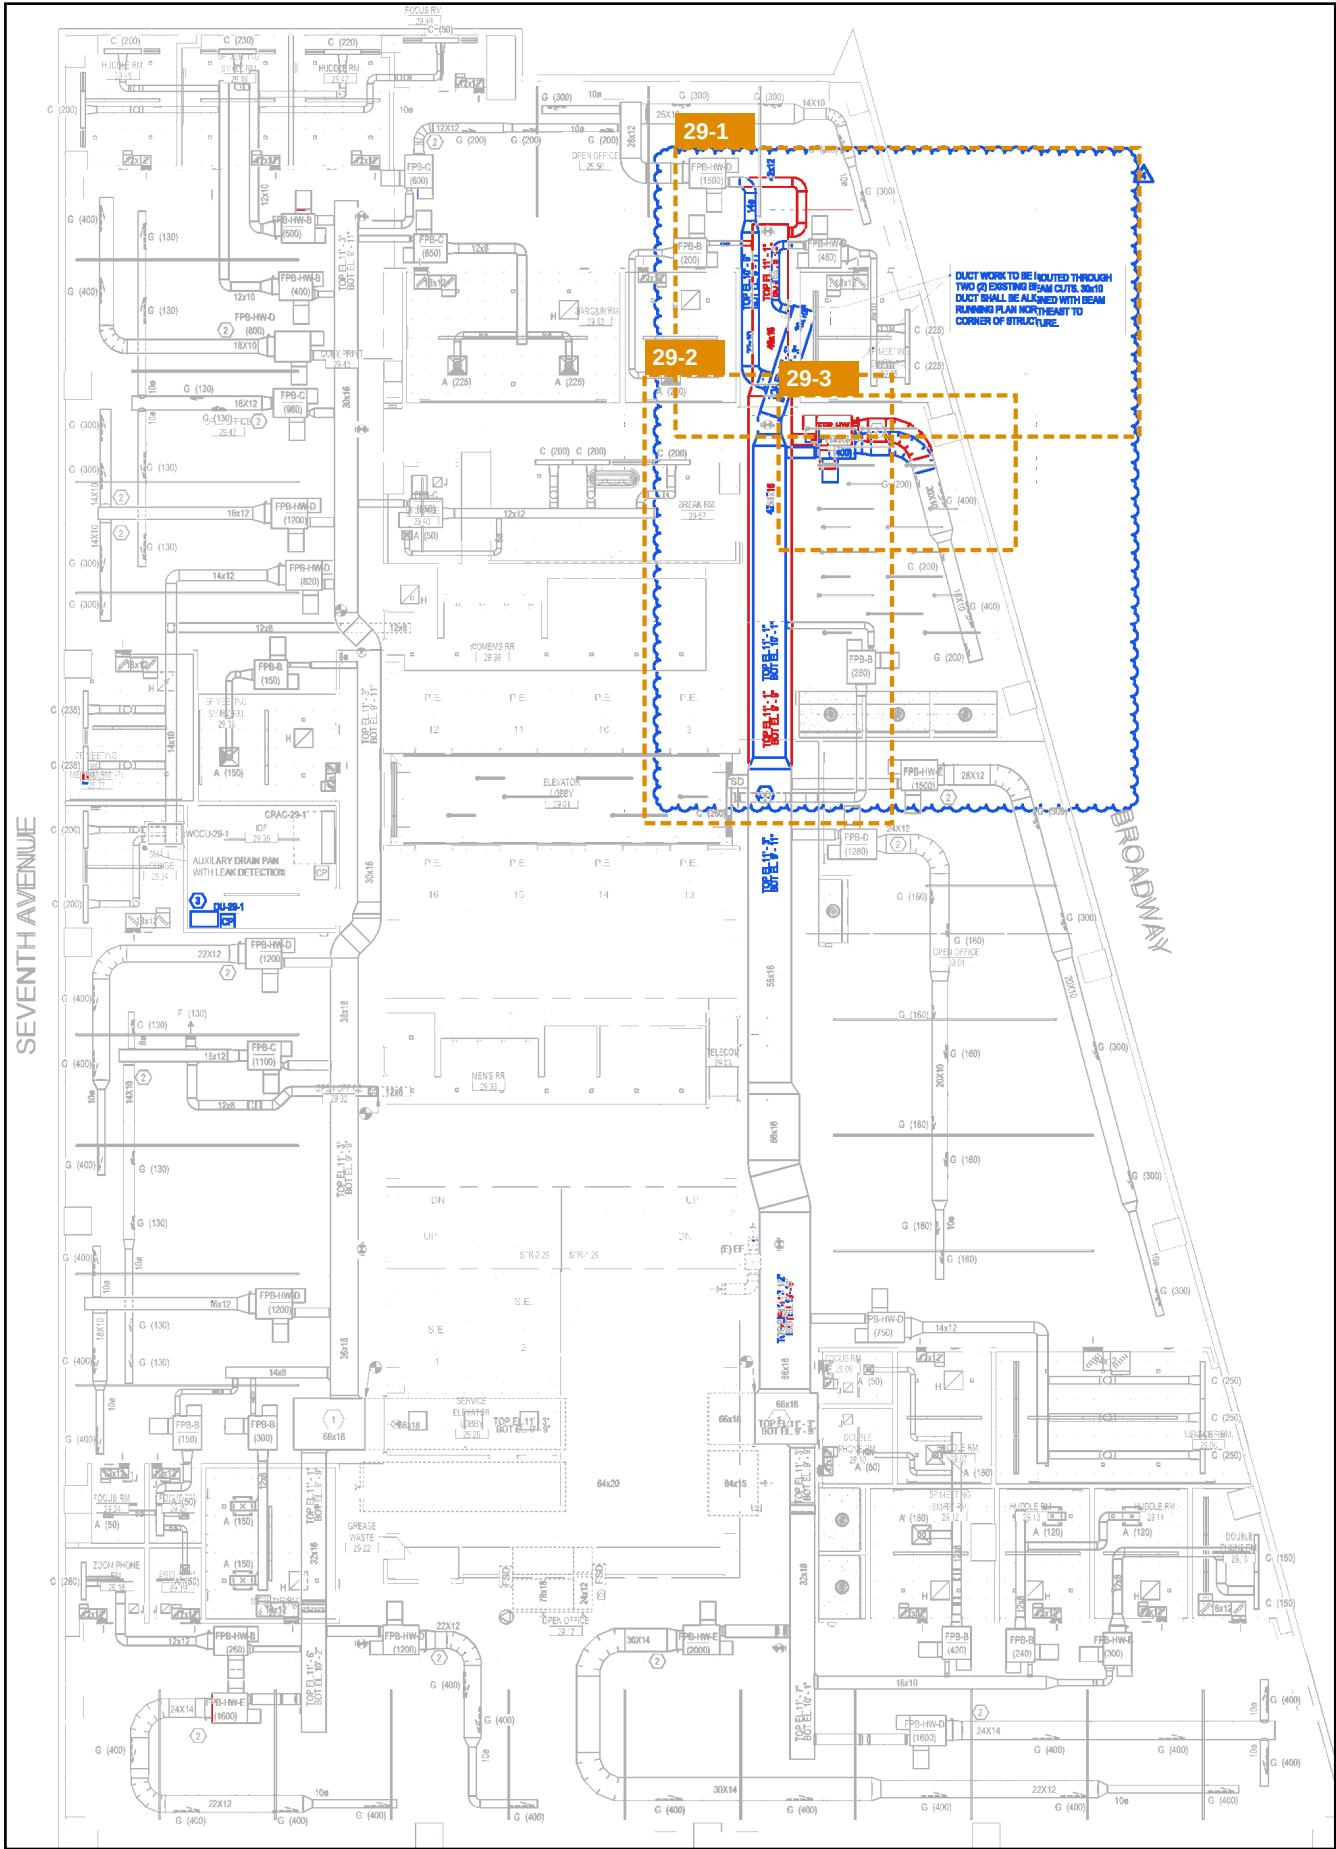


Area	Description	Disconnect	Material	Labor	Total
29-1	North supply main - reroute through existing beam cuts	\$750	\$3,600	\$7,500	\$11,850
29-2	Supply main resized 56x16 to 42x12	\$875	\$3,900	\$6,250	\$11,025
29-3	FPB-HW-E (1400) relocation and discharge reroute	\$375	\$1,600	\$3,750	\$5,725
	Shop drawings for revised design				\$1,000
	29th floor total	\$2,000	\$9,100	\$17,500	\$29,600

Disconnect = disconnect / removal labor of installed Addendum 1 work incl. haul away and clean up. Material = fabricated ductwork, fittings, insulation, accessories and air outlets. Labor = relocation / installation of ductwork, terminal units and air outlets.

Area 29-1 - North supply main - reroute through existing beam cuts

29th floor, M-529.00 | Before = Addendum 1 After = Bulletin 3 (rev 4, 08/10/2026)

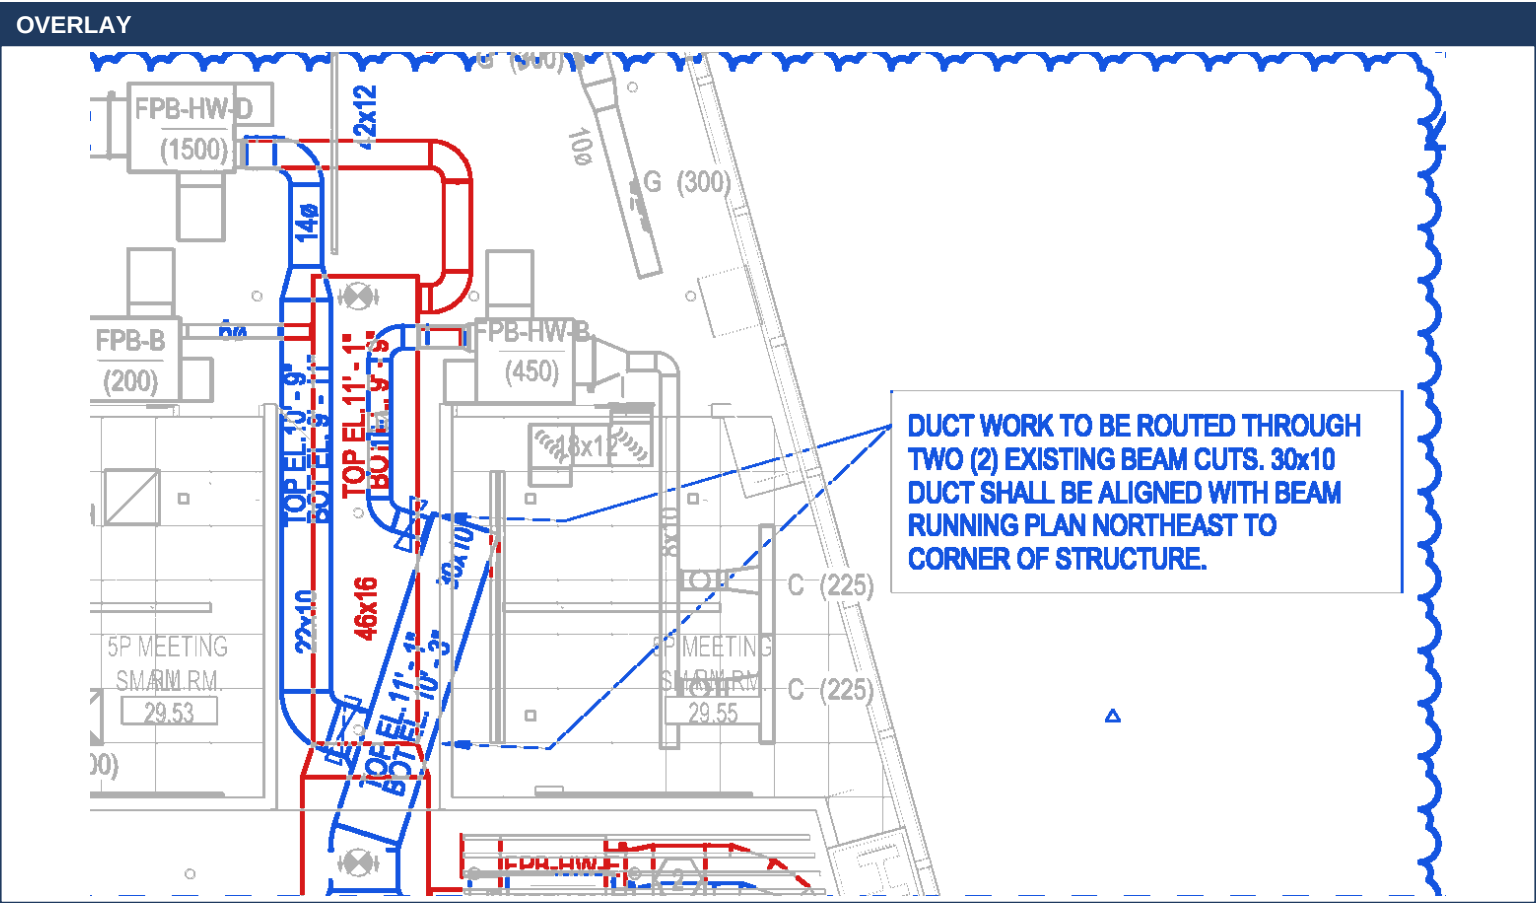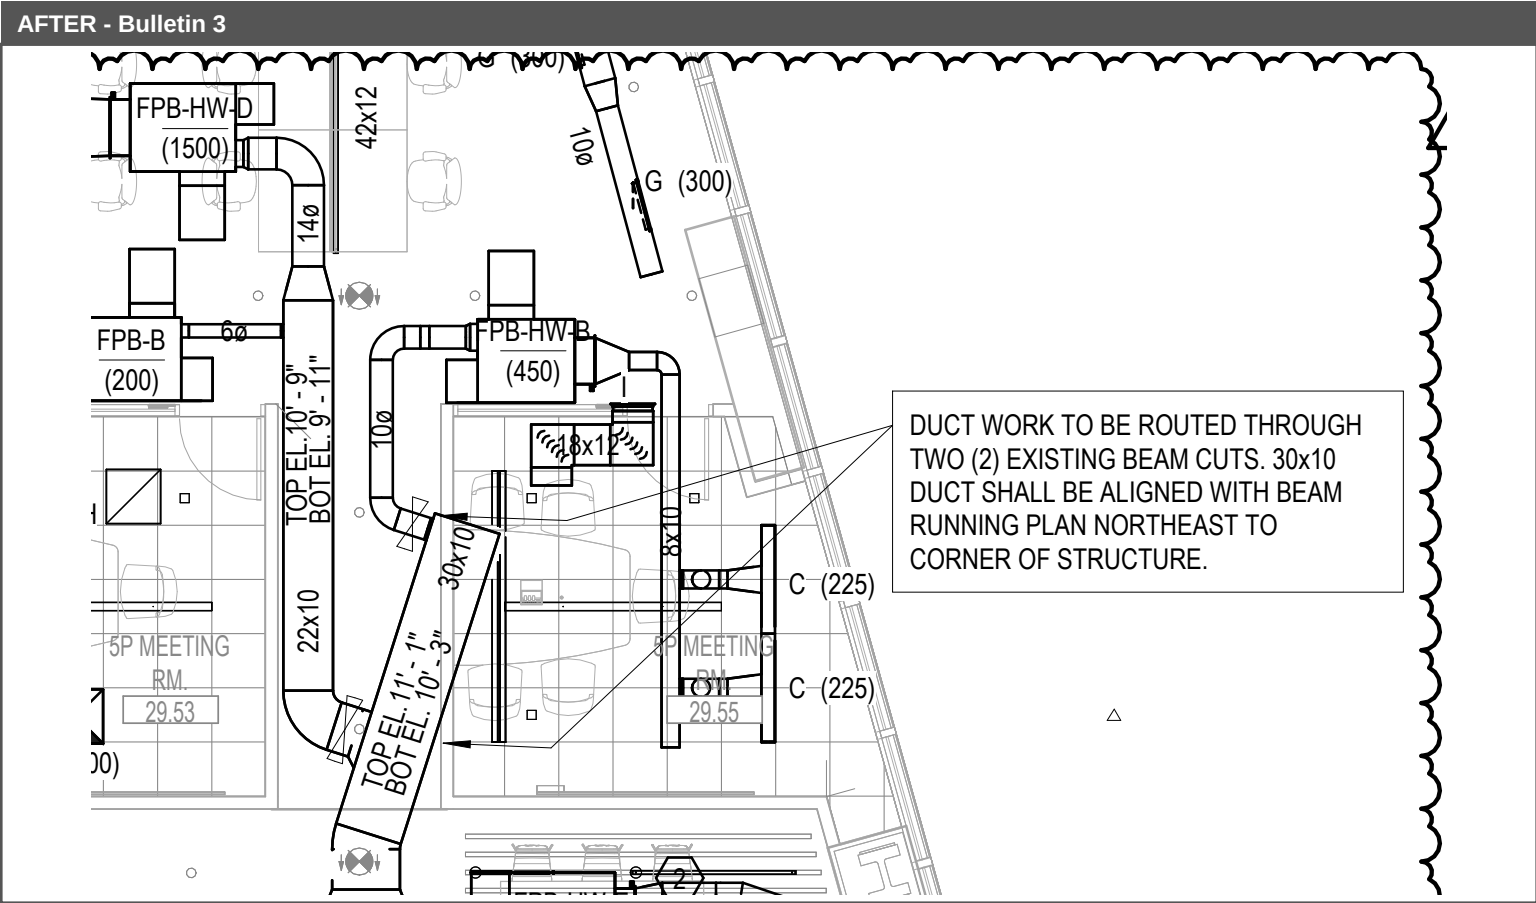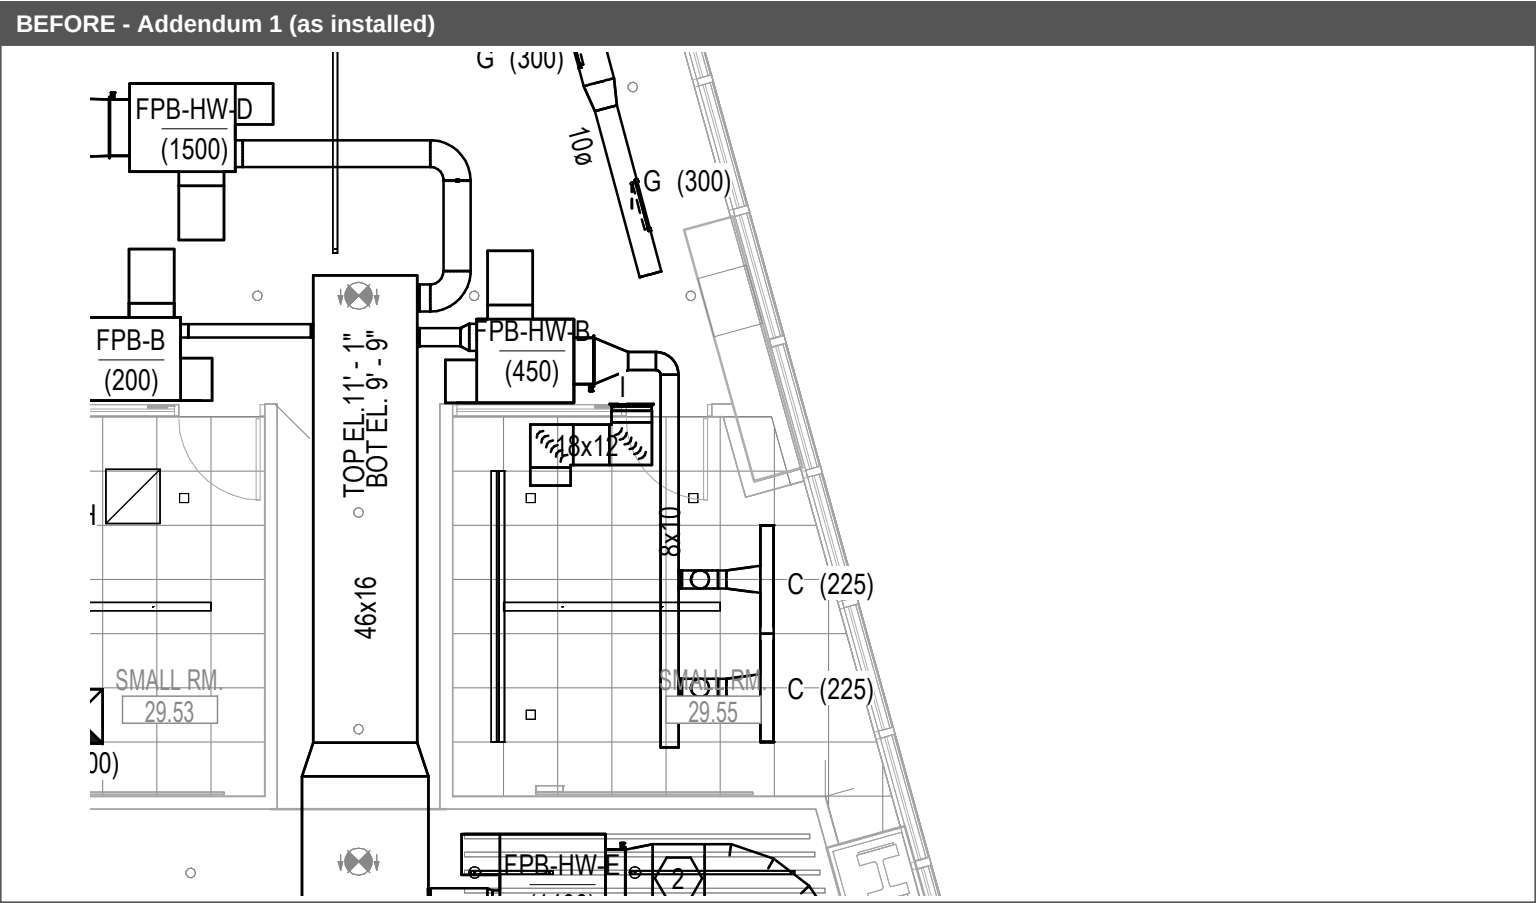


- Unchanged
- Addendum 1 only - installed, removed
- Bulletin 3 only - new work

Before (Addendum 1, installed): 46x16 supply main (approx. 20 LF, bottom el. 9'-9") with branch connections to FPB-HW-D (1500), FPB-HW-B (450) and FPB-B (200).

After (Bulletin 3): Main rerouted as 22x10 and 30x10 through (2) existing beam cuts, 30x10 aligned with the beam running plan northeast. New 14x10 branch to FPB-HW-D, 10x10 to FPB-HW-B and 6x10 to FPB-B.

Work required: Disconnect and remove installed 46x16 section and branch connections. Fabricate and install 22x10 / 30x10 duct and round branches with insulation, reconnect terminal units.

Cost item	Qty	Unit	Rate	Amount
Disconnect / removal of installed ductwork, haul away (labor)	6	MH	\$125	\$750
Fabricated ductwork, fittings, insulation, accessories (material)	1	LS		\$3,600
Relocation / installation of ductwork (labor)	60	MH	\$125	\$7,500
Area 29-1 total				\$11,850

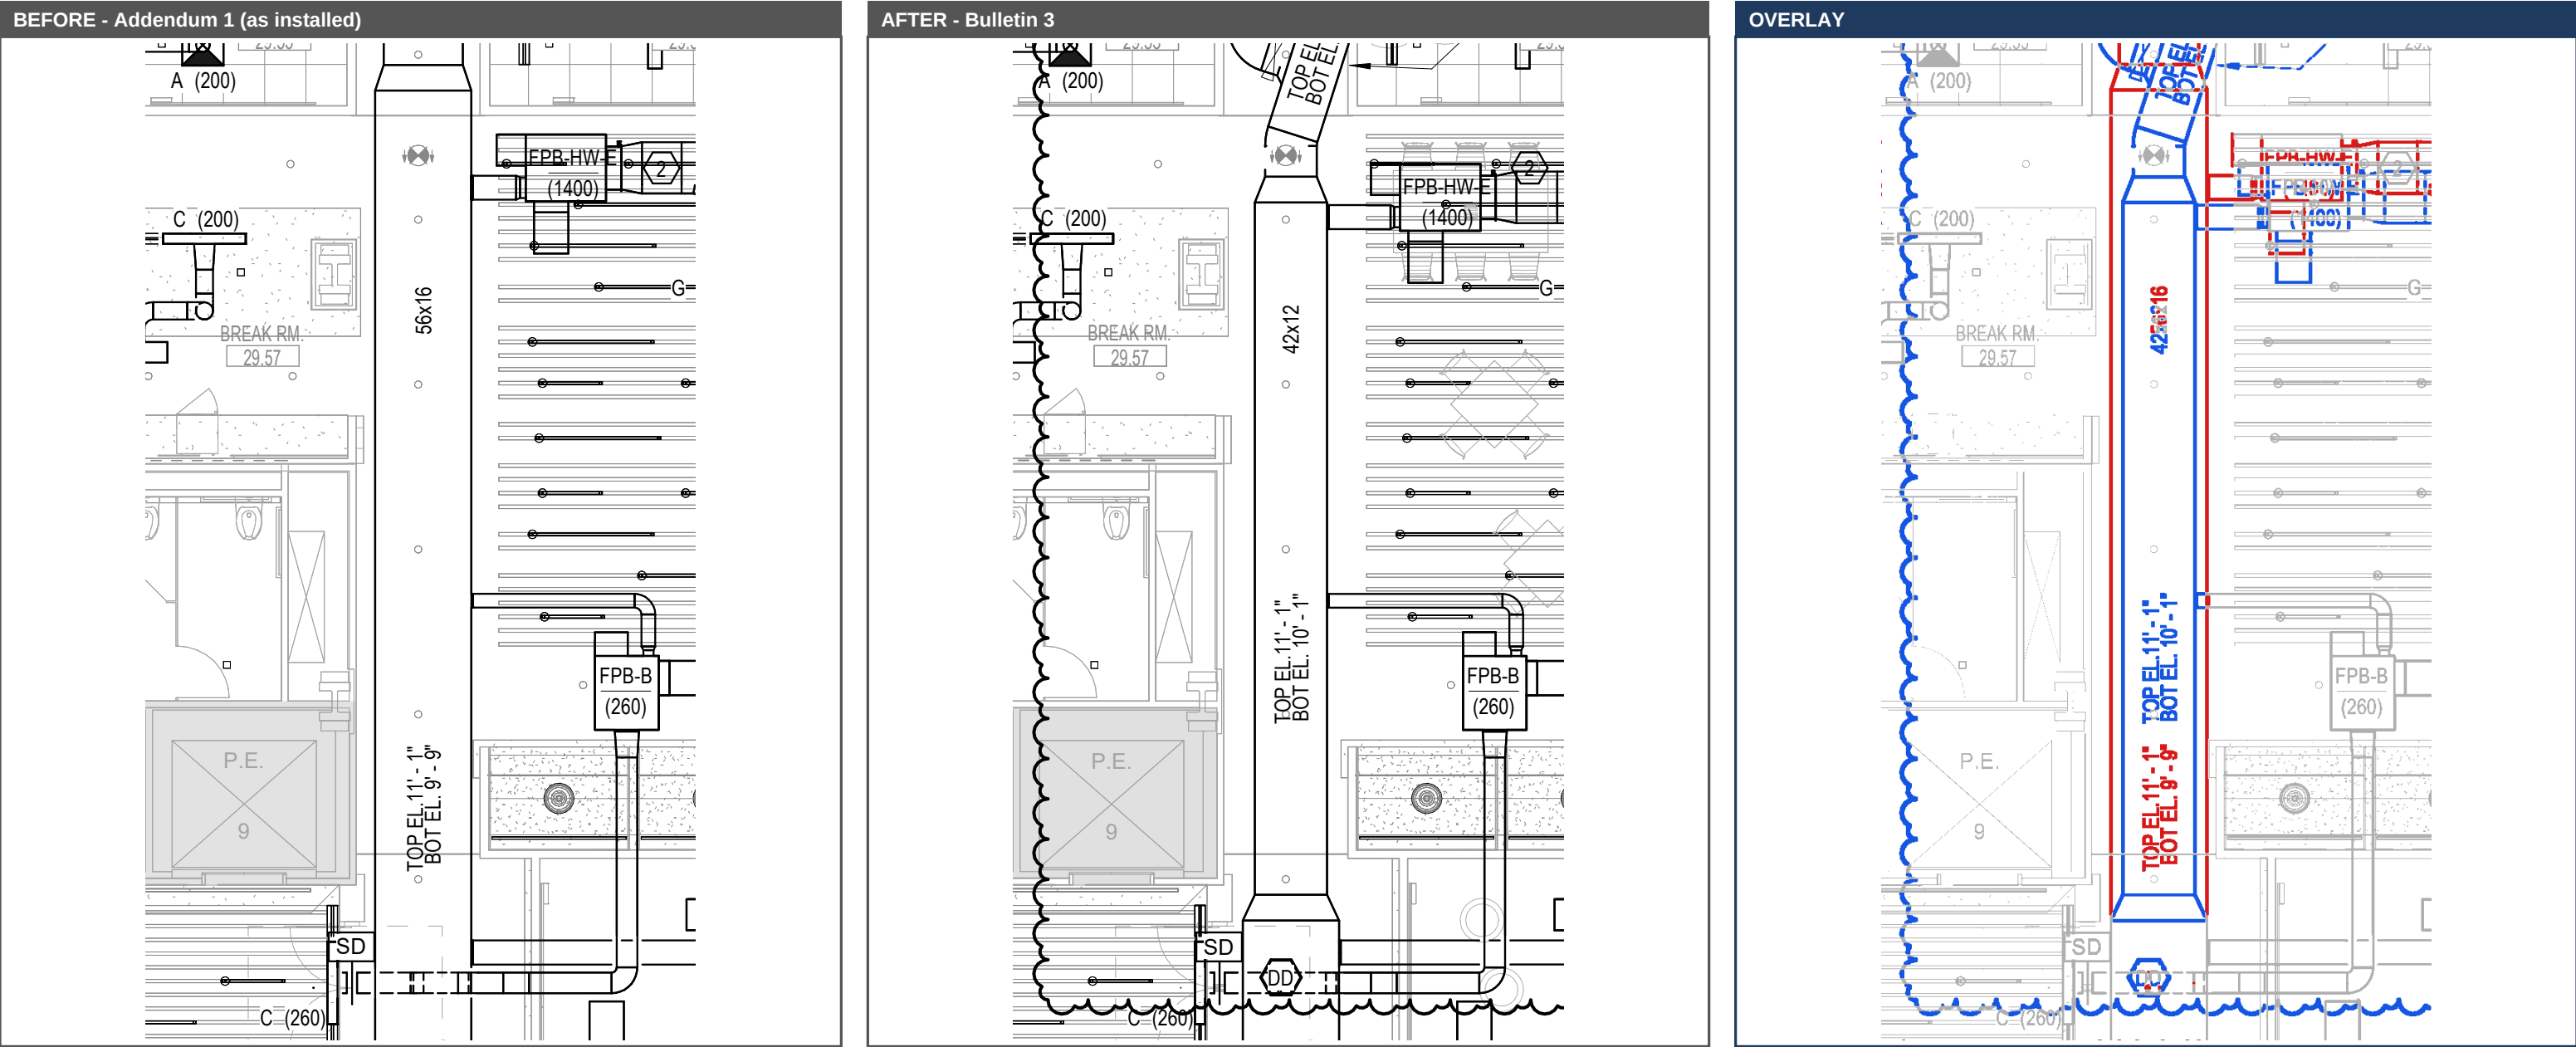

Unchanged

Addendum 1 only - installed, removed




Bulletin 3 only - new work

Before (Addendum 1, installed): 56x16 supply main, approx. 44 LF, top el. 11'-1" / bottom el. 9'-9", Break Rm 29.57 to P.E.

After (Bulletin 3): Main resized to 42x12 on the same route, top el. 11'-1" / bottom el. 10'-1".

Work required: Disconnect and remove installed 56x16 main. Fabricate and install 42x12 main with insulation, reconnect branch takeoffs (FPB-HW-E, FPB-B (260)).

Cost item	Qty	Unit	Rate	Amount
Disconnect / removal of installed ductwork, haul away (labor)	7	MH	\$125	\$875
Fabricated ductwork, fittings, insulation, accessories (material)	1	LS		\$3,900
Relocation / installation of ductwork (labor)	50	MH	\$125	\$6,250
Area 29-2 total				\$11,025

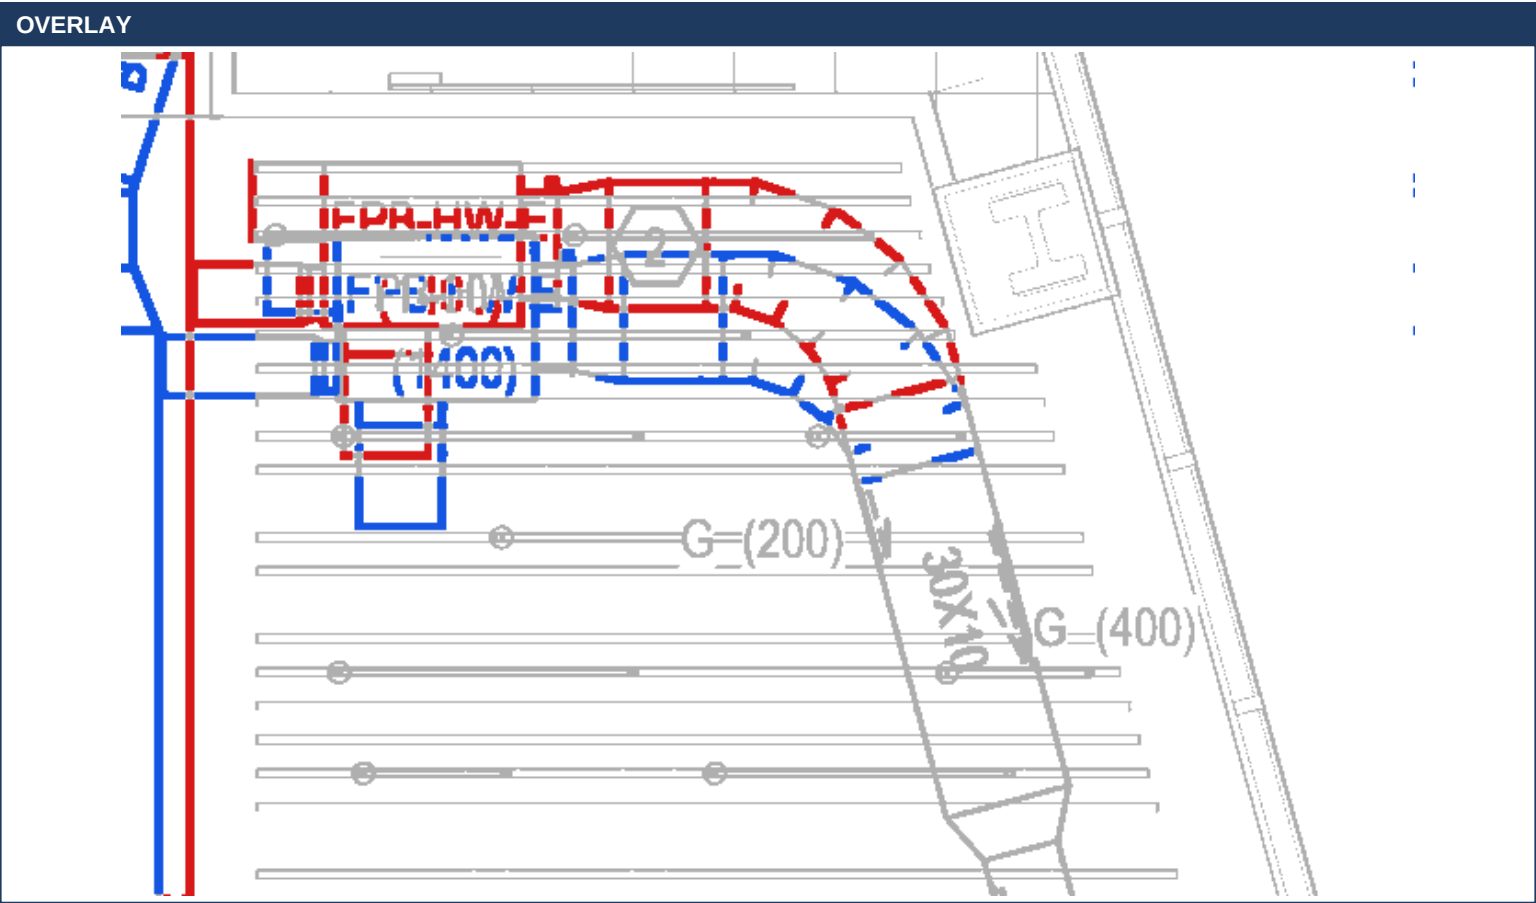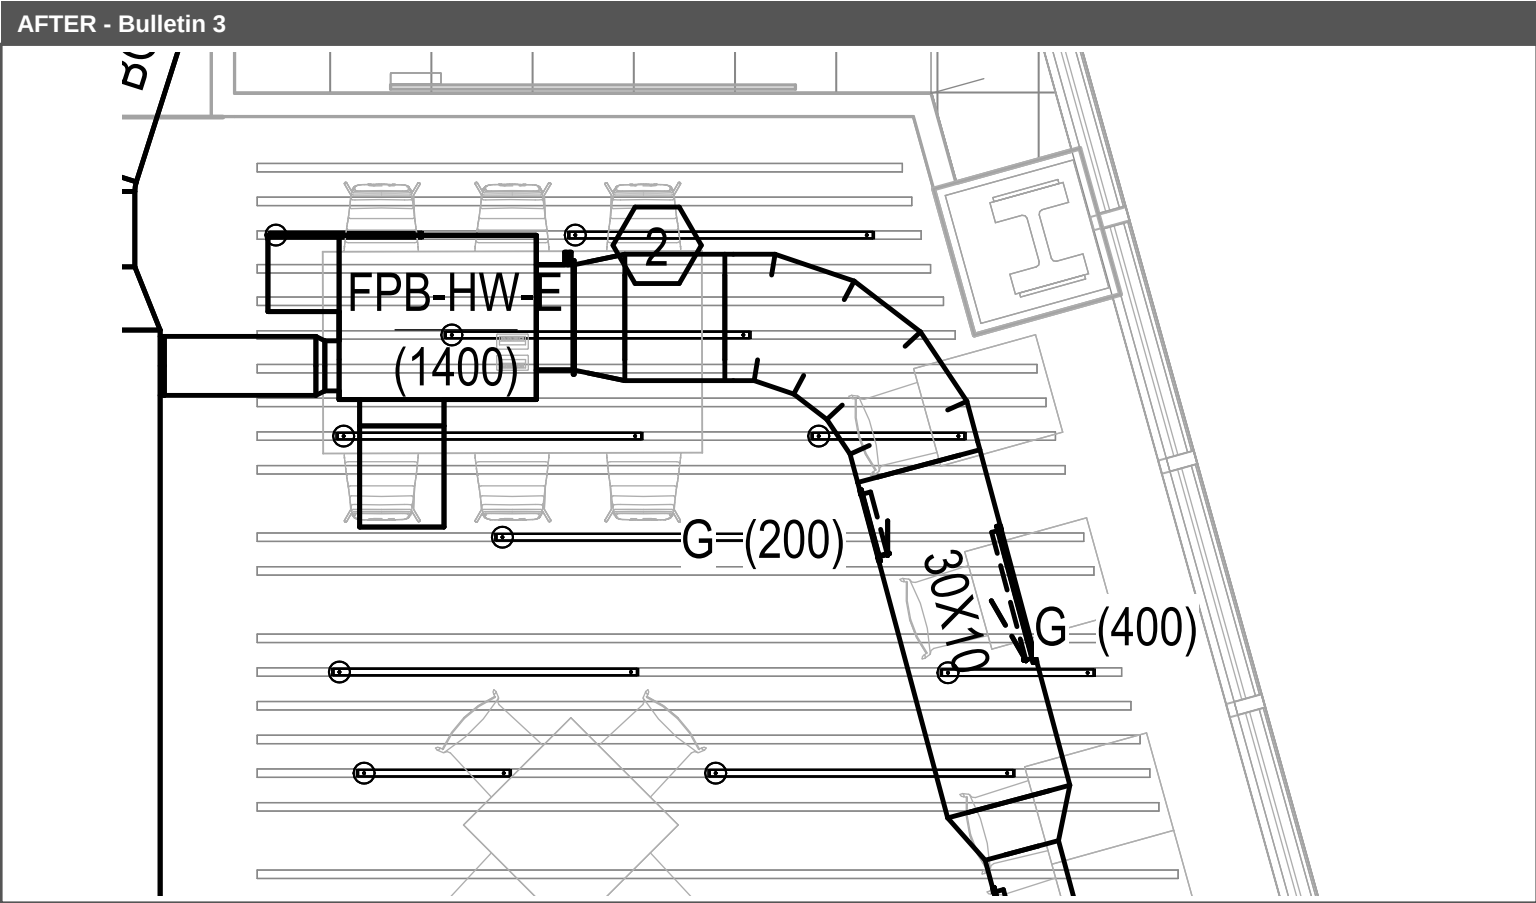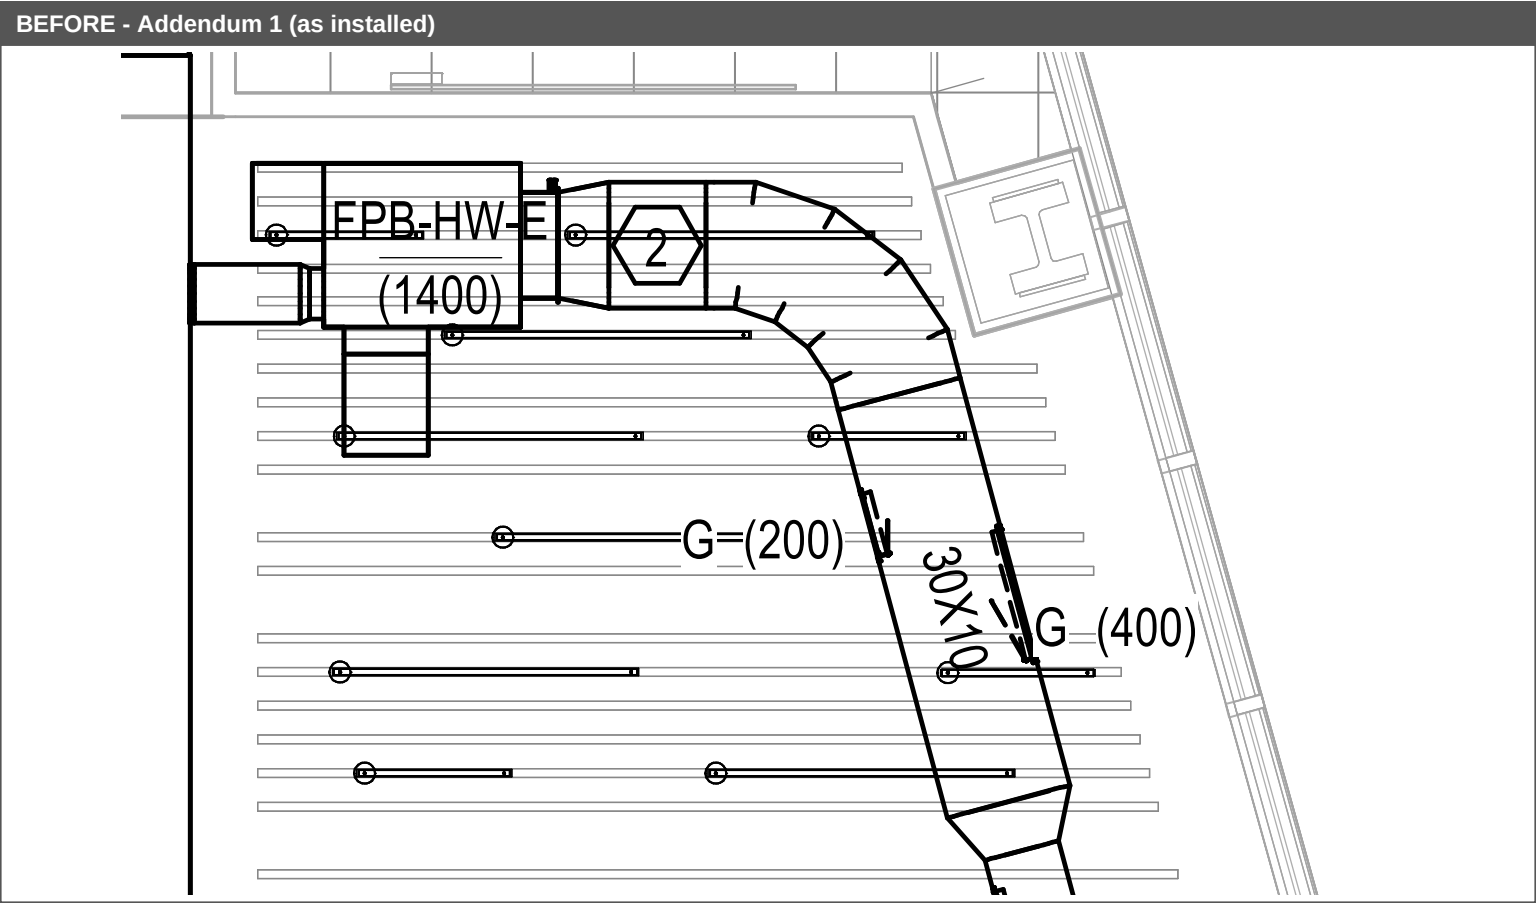


- Unchanged
- Addendum 1 only - installed, removed
- Bulletin 3 only - new work

Before (Addendum 1, installed): FPB-HW-E (1400) with inlet and 30x10 discharge to the G(400) / G(200) linear diffusers along the northeast wall.

After (Bulletin 3): FPB-HW-E relocated; inlet connection and 30x10 discharge elbow rerouted.

Work required: Disconnect inlet and discharge, relocate and rehang FPB-HW-E, fabricate and install new inlet and 30x10 discharge fittings, reconnect.


Cost item	Qty	Unit	Rate	Amount
Disconnect / removal of installed ductwork, haul away (labor)	3	MH	\$125	\$375
Fabricated ductwork, fittings, insulation, accessories (material)	1	LS		\$1,600
Relocation / installation of ductwork (labor)	30	MH	\$125	\$3,750
Area 29-3 total				\$5,725

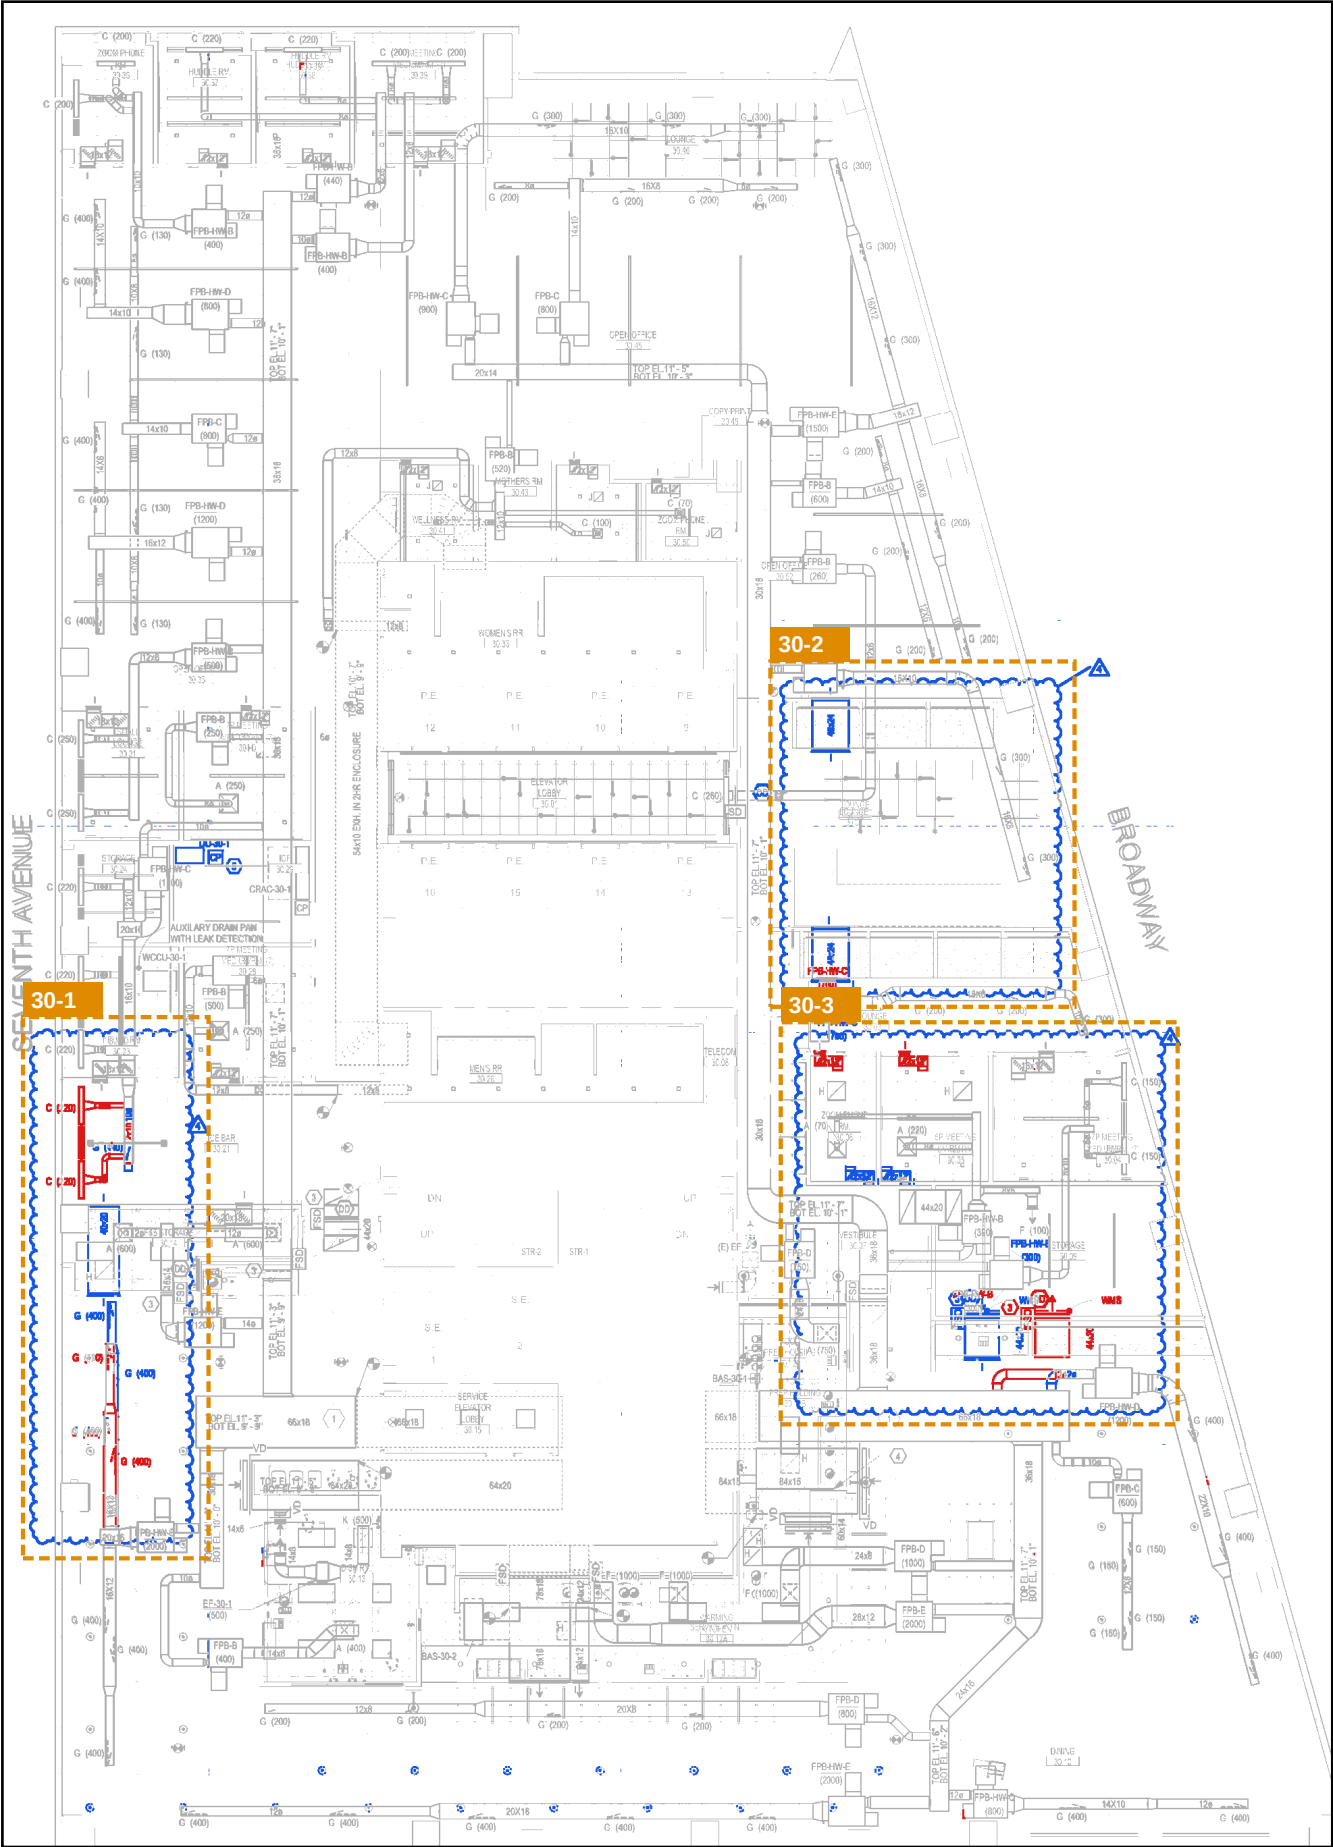

30th floor - cost by area

Area	Description	Disconnect	Material	Labor	Total
30-1	IT Build Rm 30.23 / F&B Storage 30.14 / west dining	\$750	\$3,600	\$4,500	\$8,850
30-2	Lounge 30.02 - new transfer ducts	-	\$1,300	\$2,250	\$3,550
30-3	Meeting Rms 30.04 / 30.05, Storage 30.09, Vestibule 30.07	\$750	\$2,500	\$3,500	\$6,750
	Shop drawings for revised design				\$1,000
30th floor total		\$1,500	\$7,400	\$10,250	\$20,150

Disconnect = disconnect / removal labor of installed Addendum 1 work incl. haul away and clean up. Material = fabricated ductwork, fittings, insulation, accessories and air outlets. Labor = relocation / installation of ductwork, terminal units and air outlets.

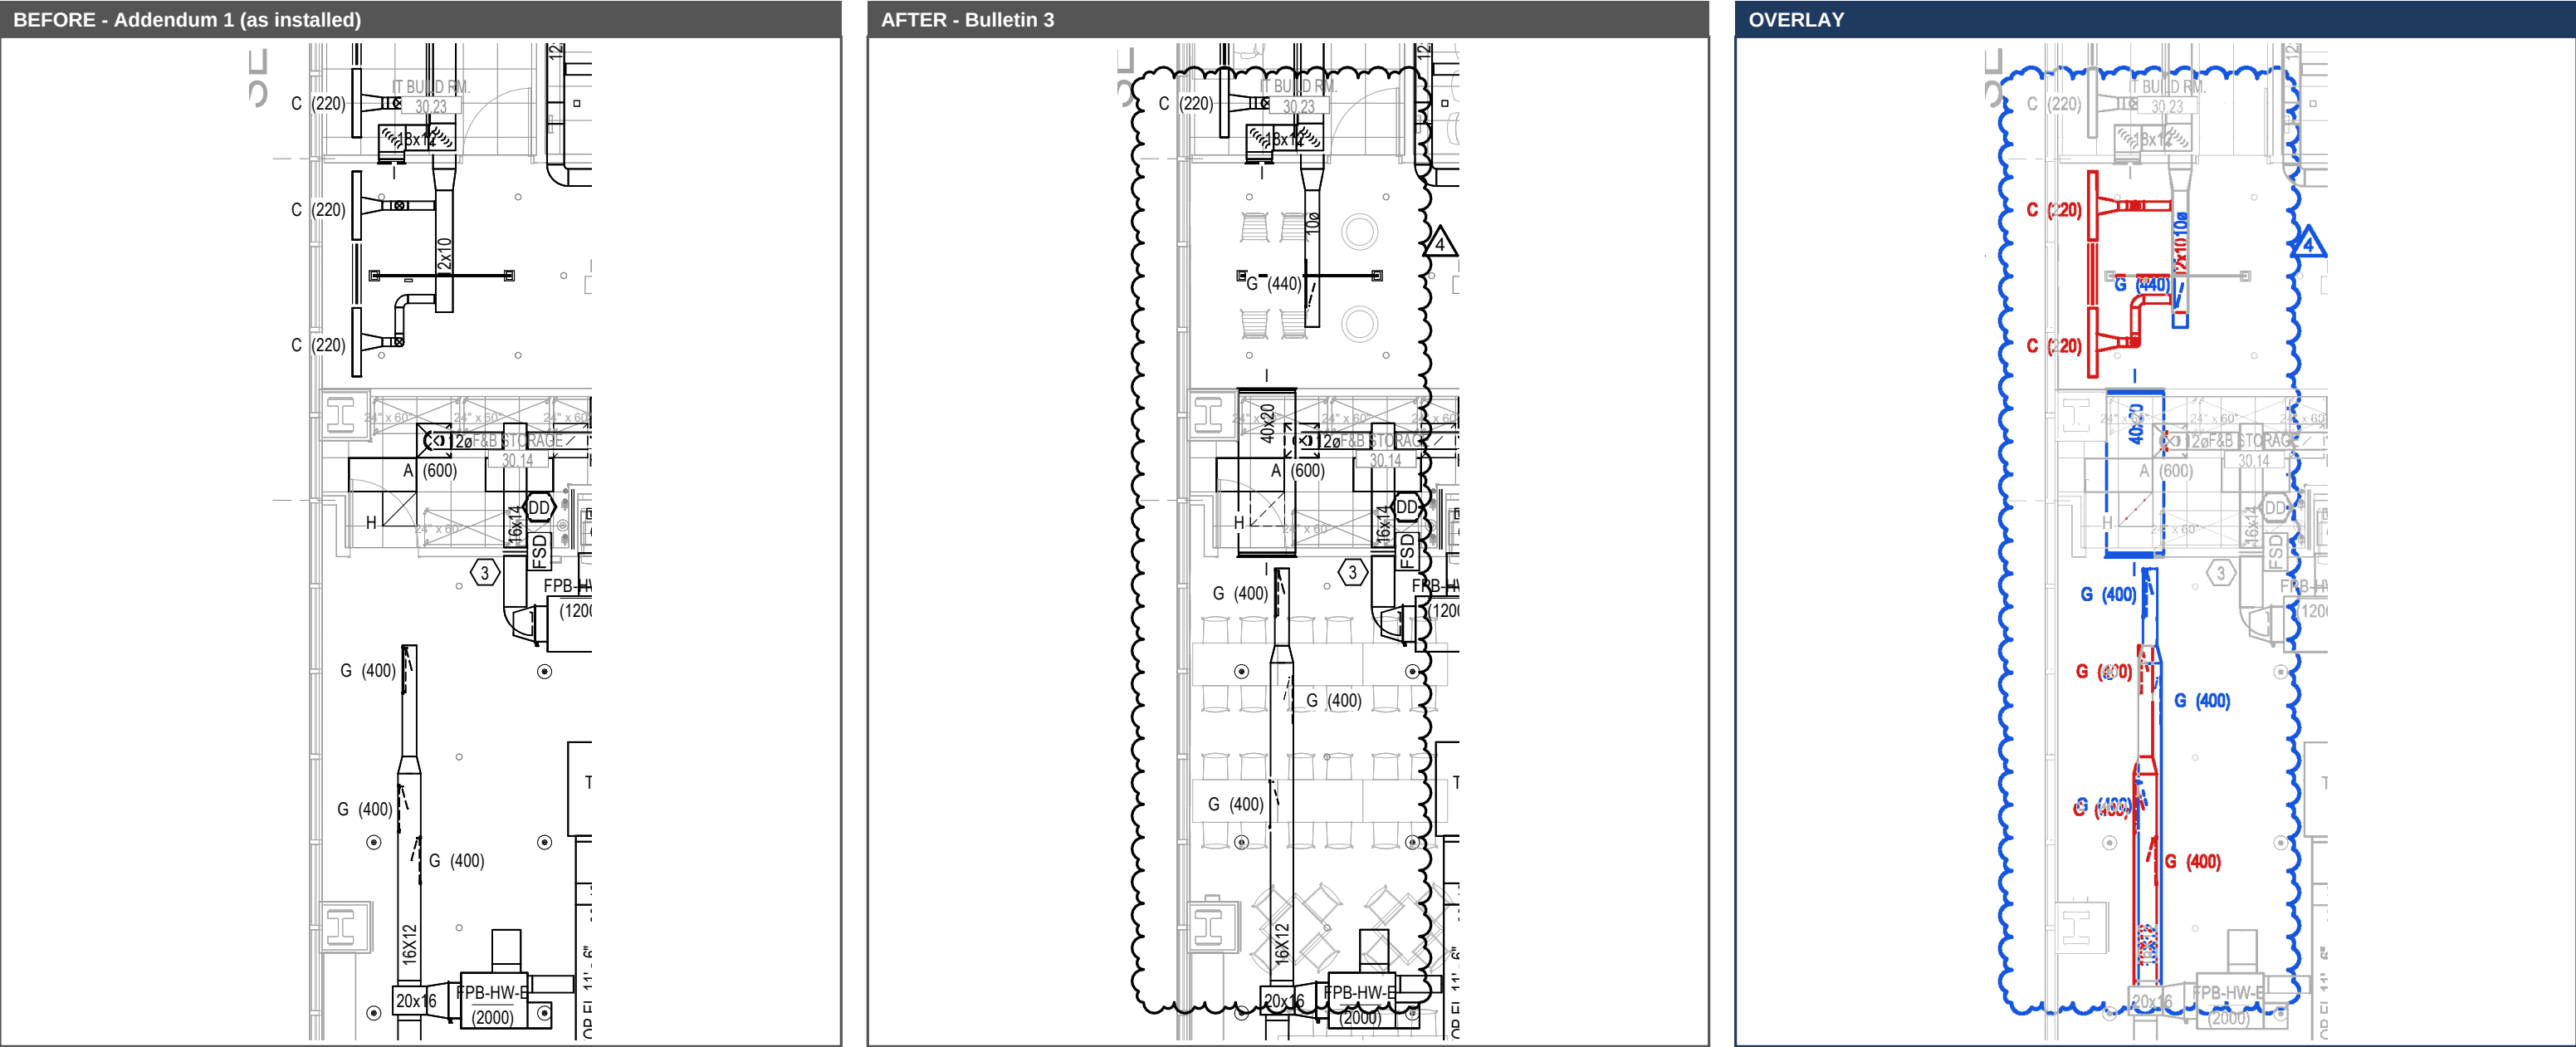

- Unchanged
- Addendum 1 only - installed, removed
- Bulletin 3 only - new work

Before (Addendum 1, installed): 12x10 branch with (2) C(220) ceiling diffusers; G(400) linear diffuser run on 16x12 branch.




After (Bulletin 3): 12x10 branch and (2) C(220) deleted, replaced with 10ø branch to (1) new G(440) linear diffuser. New 40x20 transfer duct at F&B Storage 30.14. G(400) linear diffusers relocated along the 16x12 branch.

Work required: Disconnect and remove 12x10 branch and (2) C(220). Install 10ø branch, 40x20 transfer duct, rework 16x12 branch. F&I G(440) linear diffuser with plenum, relocate G(400) diffusers.

Cost item	Qty	Unit	Rate	Amount
Disconnect / removal of installed ductwork, haul away (labor)	6	MH	\$125	\$750
Fabricated ductwork, fittings, insulation, accessories (material)	1	LS		\$1,600
Relocation / installation of ductwork (labor)	28	MH	\$125	\$3,500
Air outlets (material)	1	LS		\$2,000
Air outlet installation (labor)	8	MH	\$125	\$1,000
Area 30-1 total				\$8,850

Area 30-2 - Lounge 30.02 - new transfer ducts

30th floor, M-530.00 | Before = Addendum 1 After = Bulletin 3 (rev 4, 08/10/2026)

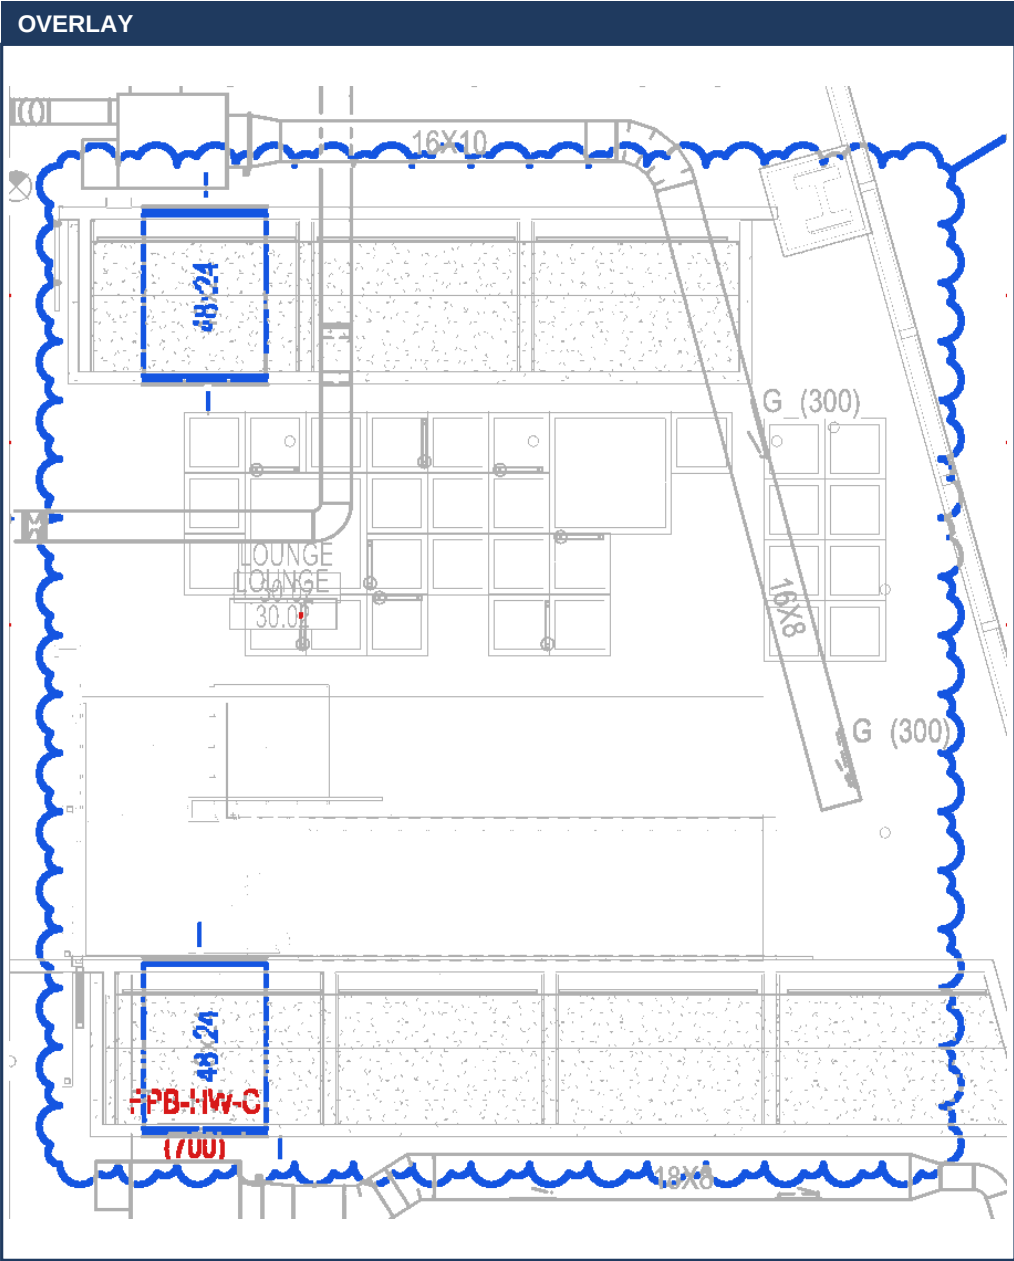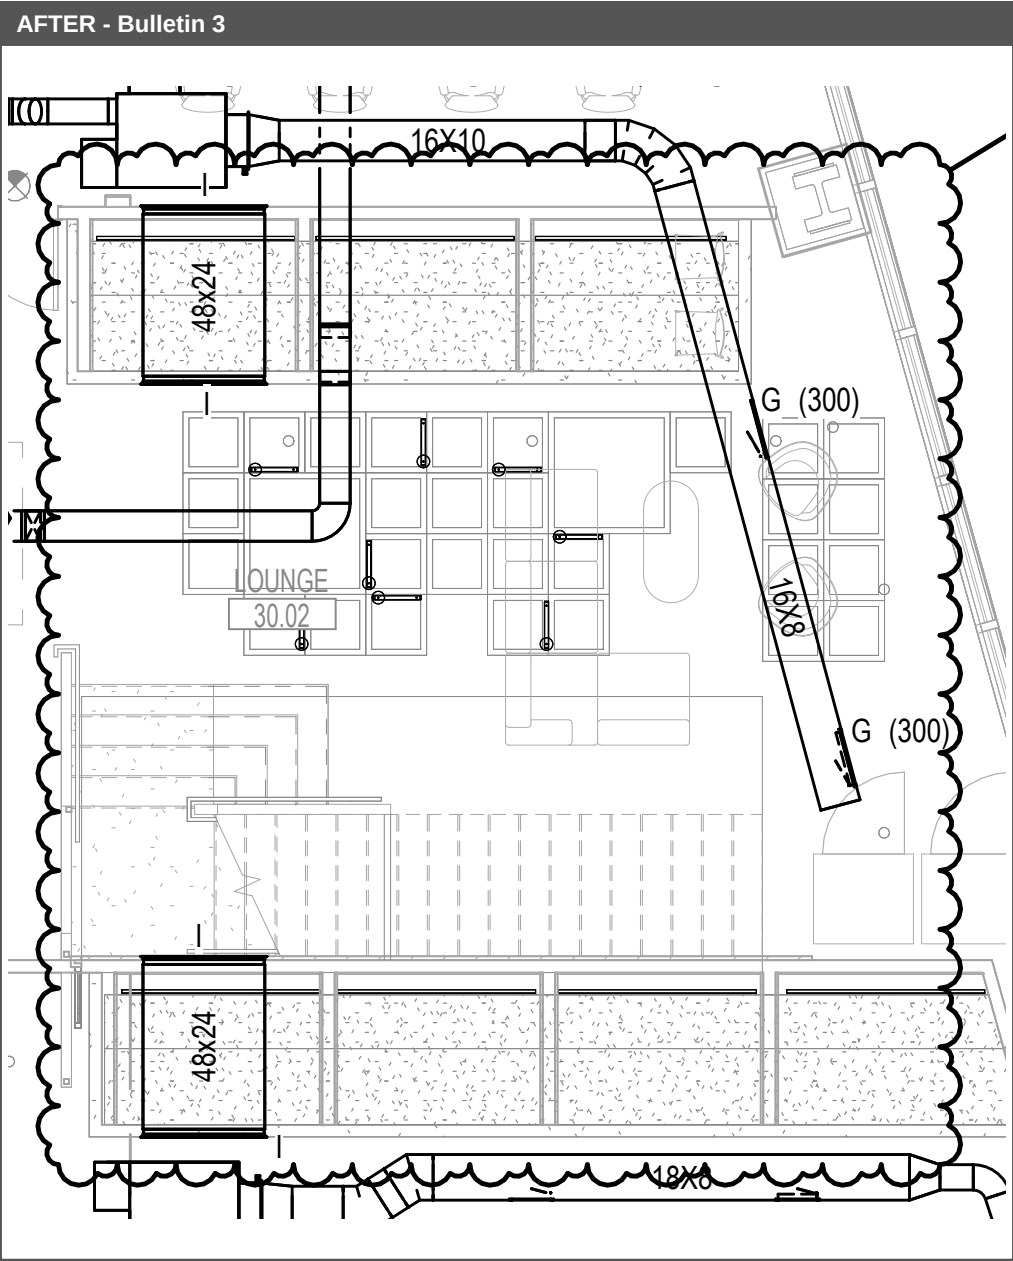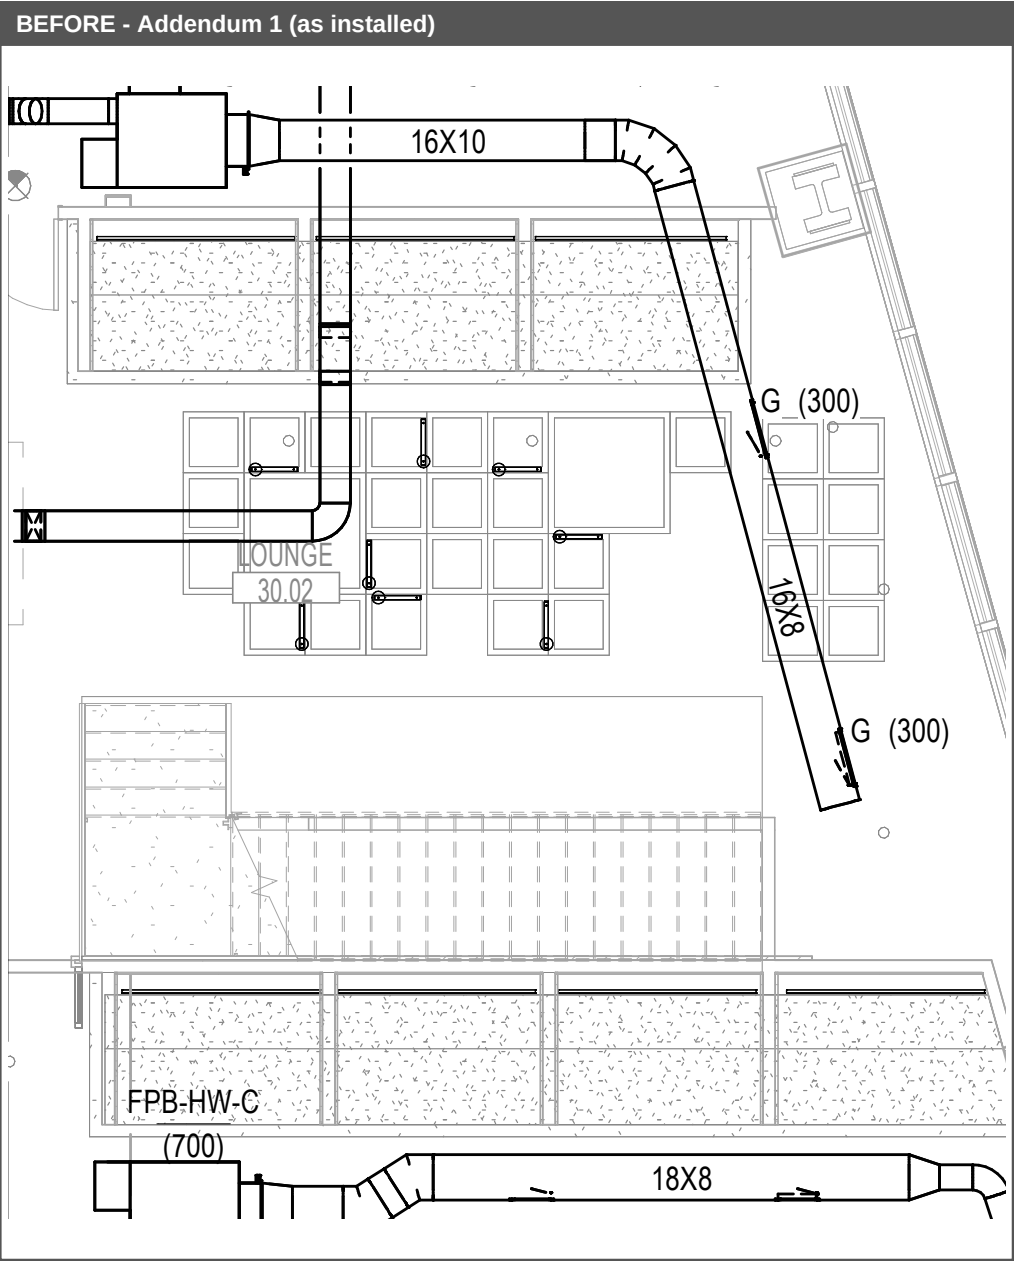


- Unchanged
- Addendum 1 only - installed, removed
- Bulletin 3 only - new work


Before (Addendum 1, installed): No transfer ducts at Lounge 30.02 walls.

After (Bulletin 3): (2) new 48x24 transfer ducts.

Work required: Fabricate and install (2) 48x24 lined transfer ducts.

Cost item	Qty	Unit	Rate	Amount
Fabricated ductwork, fittings, insulation, accessories (material)	1	LS		\$1,300
Relocation / installation of ductwork (labor)	18	MH	\$125	\$2,250
Area 30-2 total				\$3,550



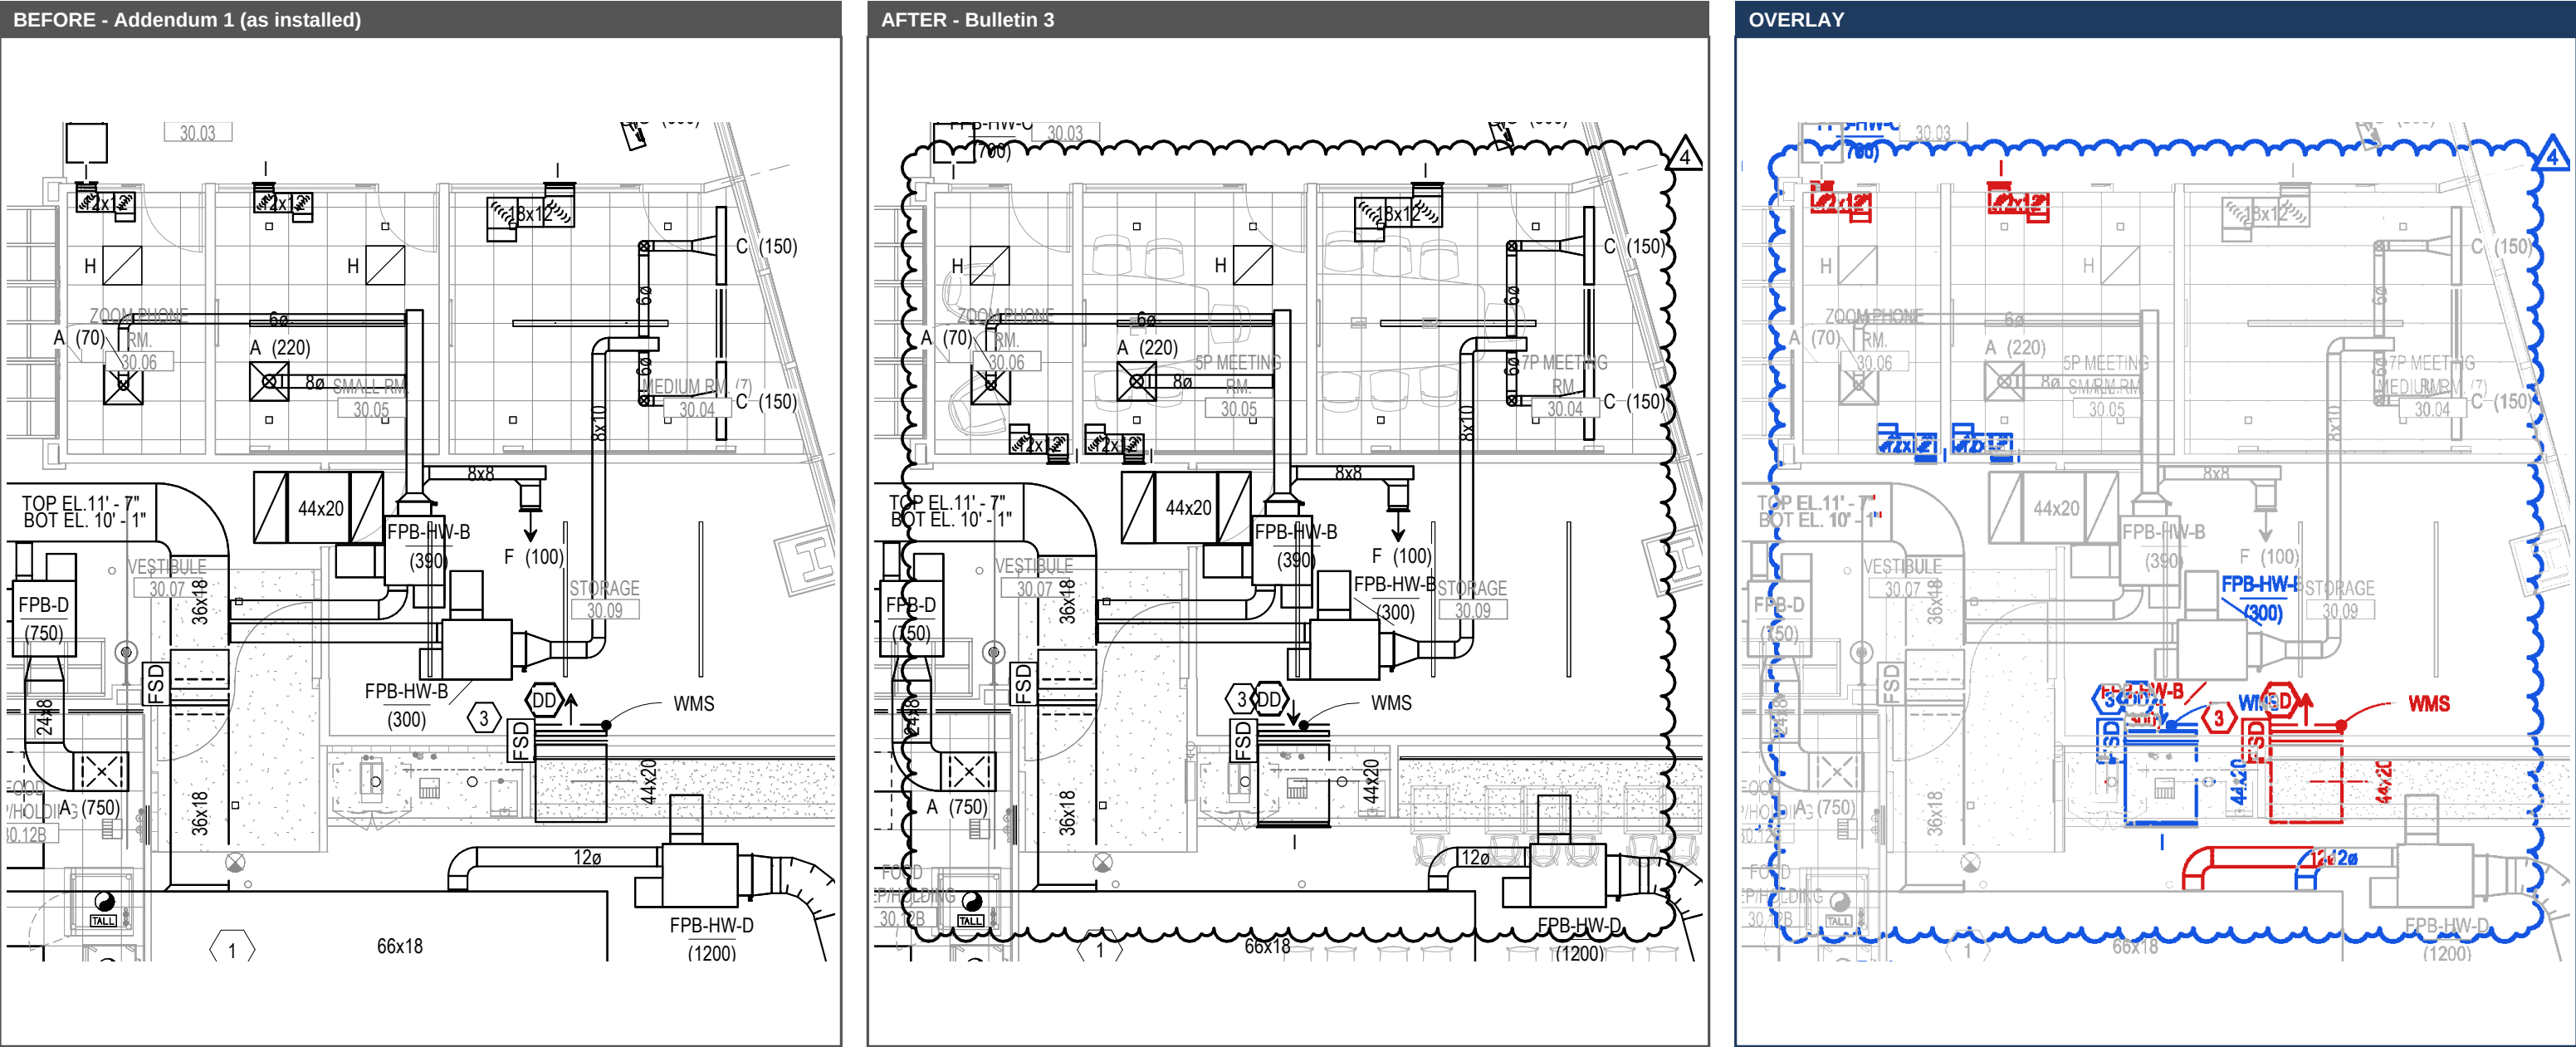


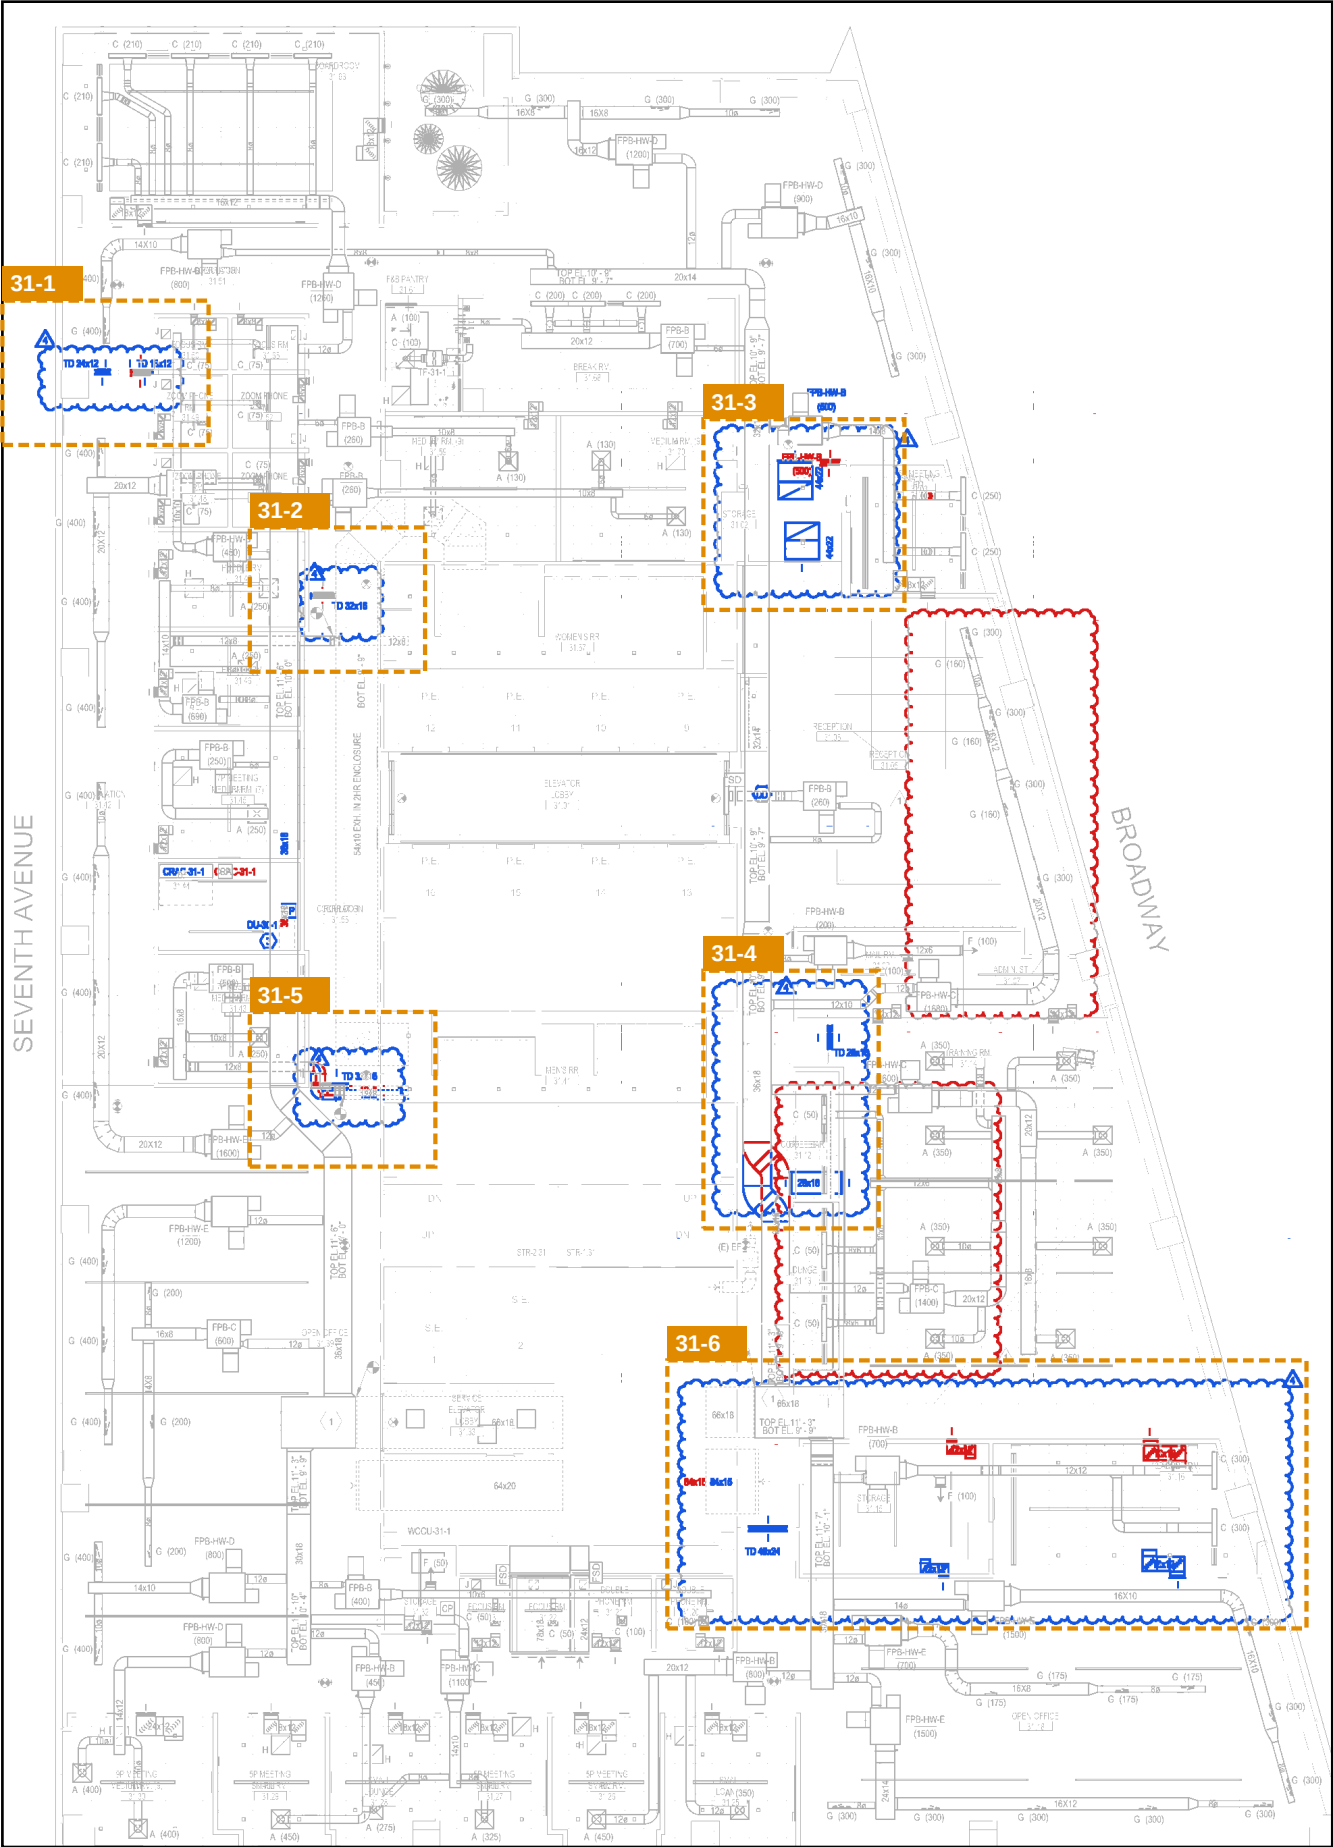

31th floor - cost by area

Area	Description	Disconnect	Material	Labor	Total
31-1	Zoom rooms, northwest - transfer ducts	\$125	\$330	\$750	\$1,205
31-2	Transfer duct TD 32x16, north	\$125	\$300	\$625	\$1,050
31-3	Storage 31.02 - new transfer ducts	\$250	\$900	\$1,500	\$2,650
31-4	Coffee Bar 31.12 - transfer ducts and main fitting	\$500	\$1,100	\$2,250	\$3,850
31-5	Transfer duct TD 32x16, southwest	\$125	\$300	\$625	\$1,050
31-6	Storage 31.15 / Room 31.16, southeast	\$375	\$2,350	\$3,500	\$6,225
	Shop drawings for revised design				\$1,000
	31th floor total	\$1,500	\$5,280	\$9,250	\$17,030

Disconnect = disconnect / removal labor of installed Addendum 1 work incl. haul away and clean up. Material = fabricated ductwork, fittings, insulation, accessories and air outlets. Labor = relocation / installation of ductwork, terminal units and air outlets.

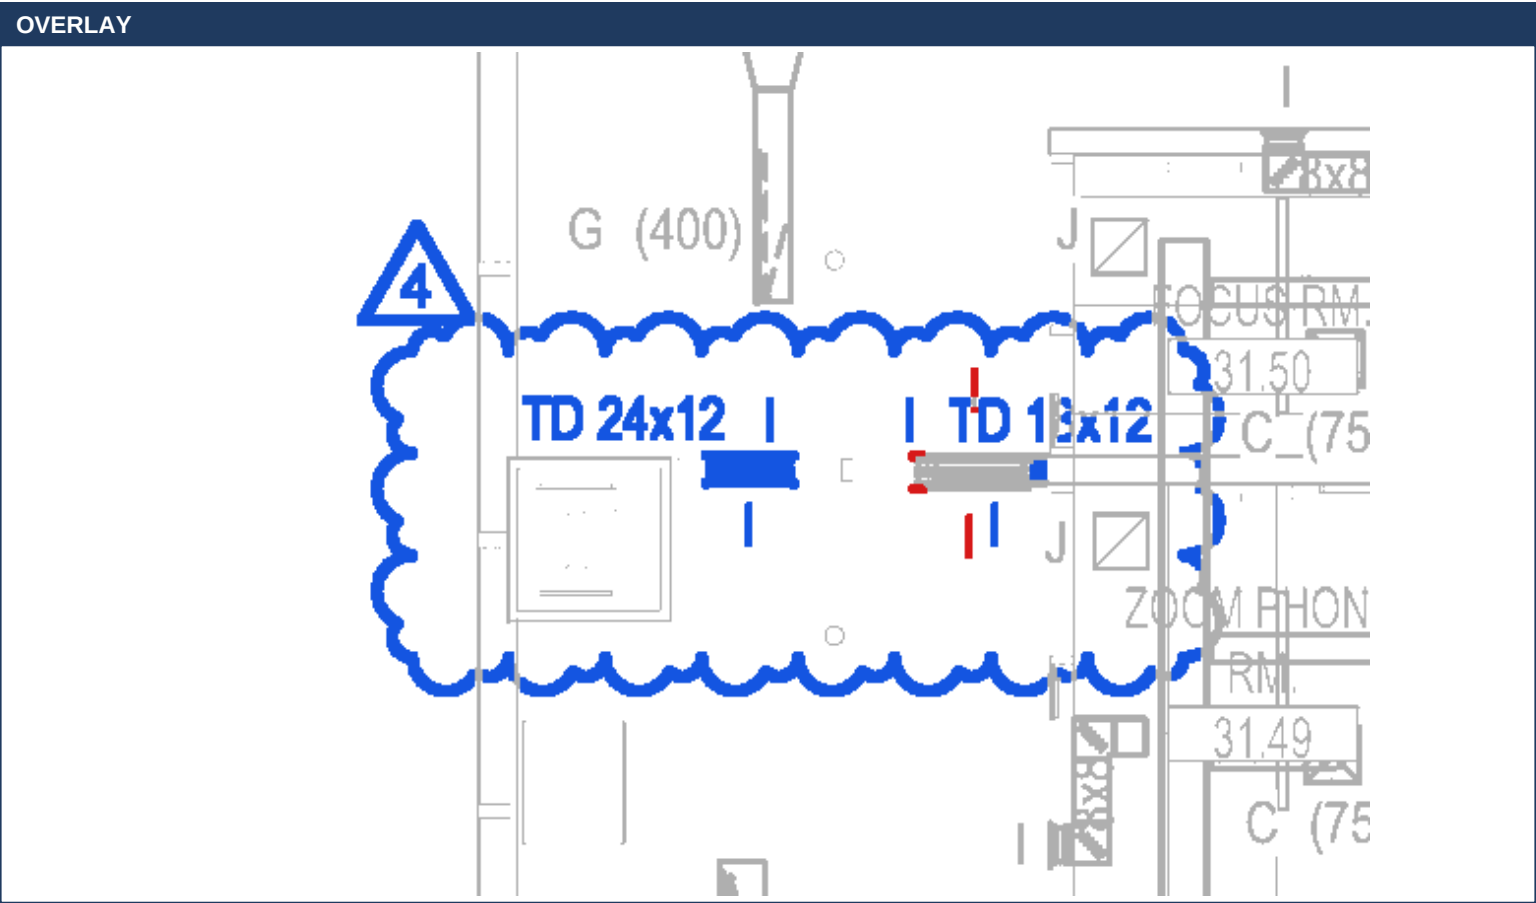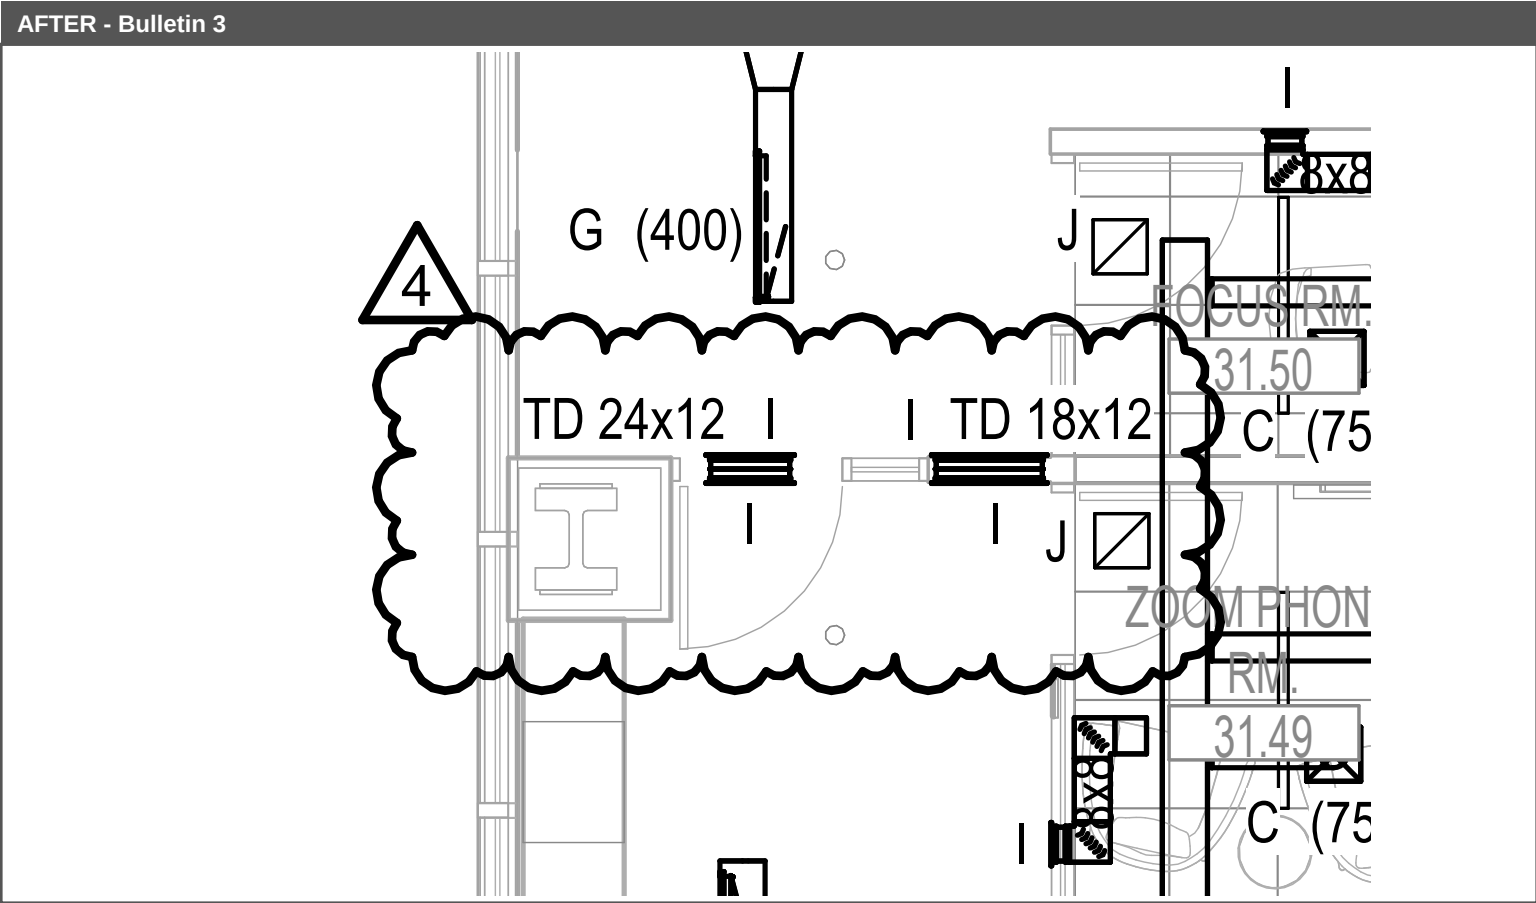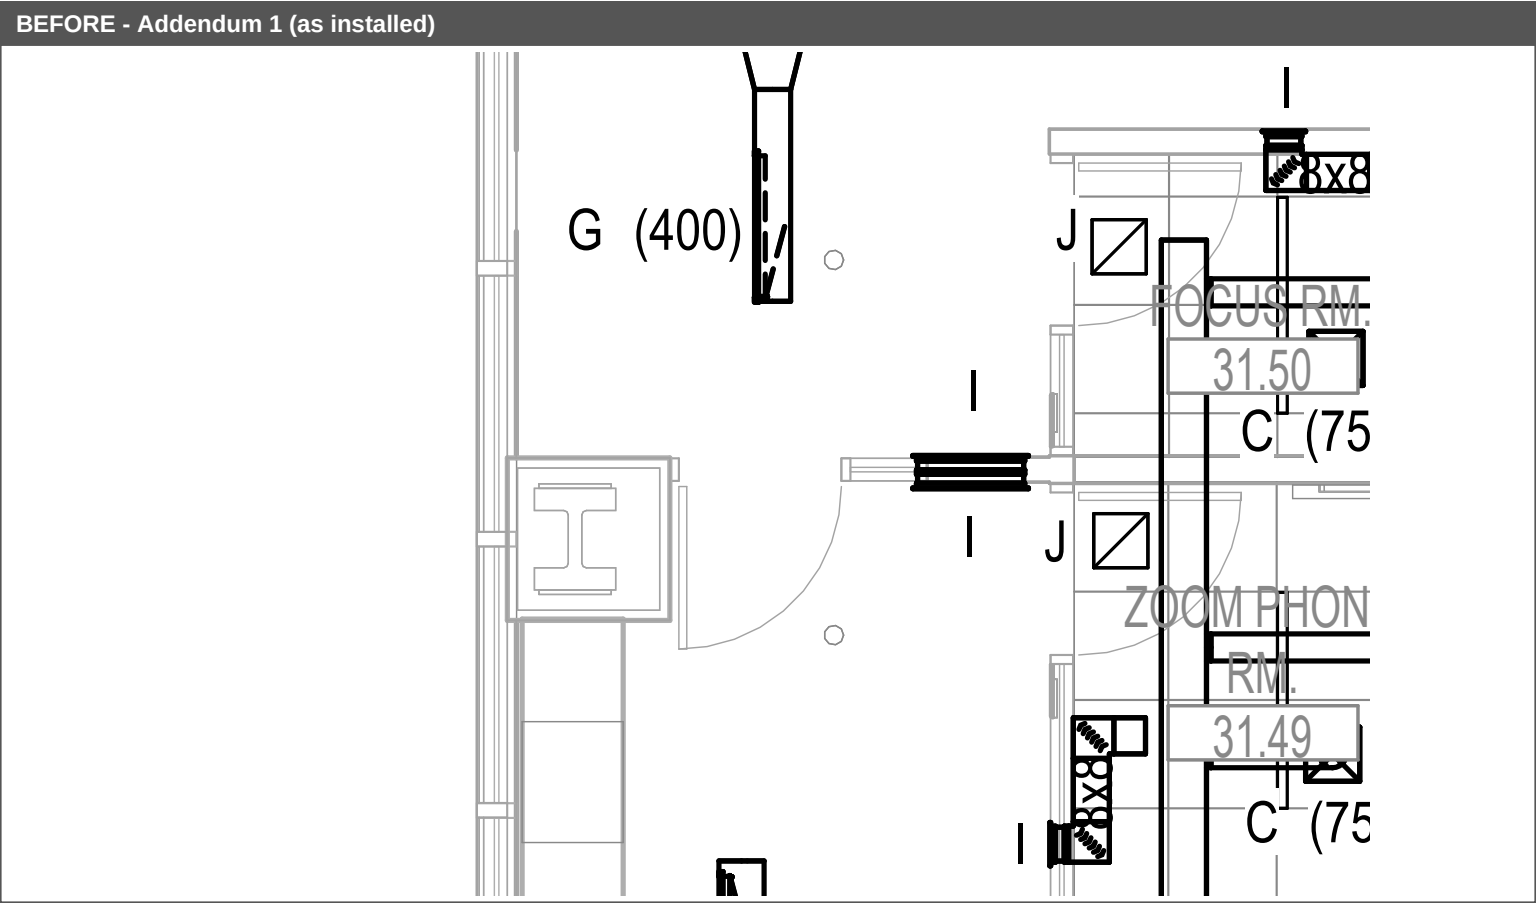


- Unchanged
- Addendum 1 only - installed, removed
- Bulletin 3 only - new work

Before (Addendum 1, installed): (1) transfer duct (not sized on Addendum 1).

After (Bulletin 3): TD 24x12 and new TD 18x12.

Work required: Remove existing transfer duct; fabricate and install TD 24x12 and TD 18x12.

Cost item	Qty	Unit	Rate	Amount
Disconnect / removal of installed ductwork, haul away (labor)	1	MH	\$125	\$125
Fabricated ductwork, fittings, insulation, accessories (material)	1	LS		\$330
Relocation / installation of ductwork (labor)	6	MH	\$125	\$750
Area 31-1 total				\$1,205

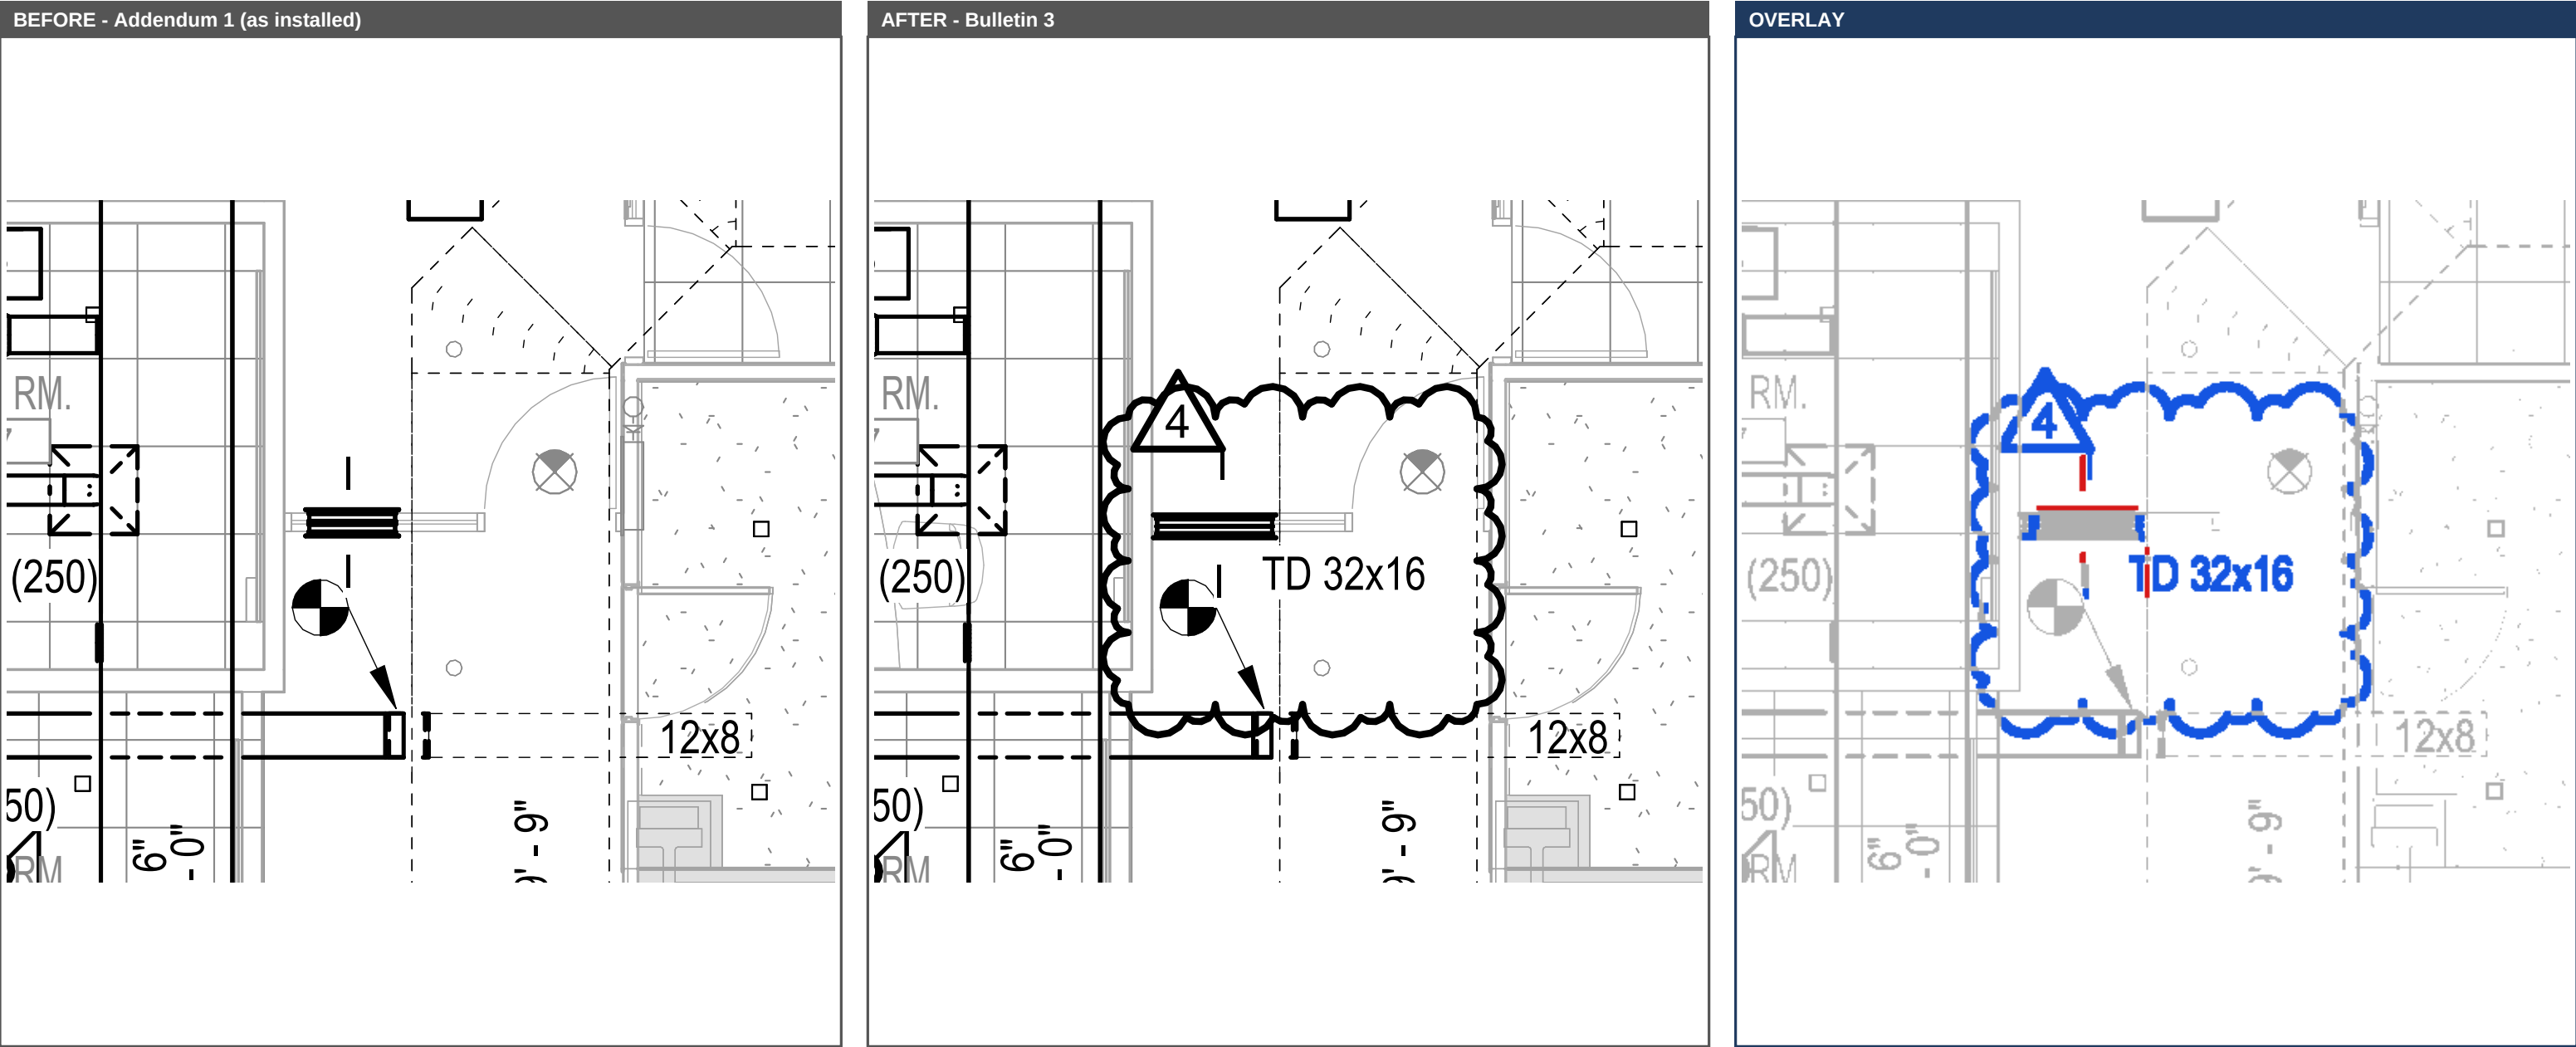

- Unchanged
- Addendum 1 only - installed, removed
- Bulletin 3 only - new work

Before (Addendum 1, installed): Transfer duct as installed per Addendum 1 (not sized on Addendum 1).


After (Bulletin 3): Transfer duct revised to TD 32x16.

Work required: Remove installed transfer duct; fabricate and install TD 32x16.

Cost item	Qty	Unit	Rate	Amount
Disconnect / removal of installed ductwork, haul away (labor)	1	MH	\$125	\$125
Fabricated ductwork, fittings, insulation, accessories (material)	1	LS		\$300
Relocation / installation of ductwork (labor)	5	MH	\$125	\$625
Area 31-2 total				\$1,050

Area 31-3 - Storage 31.02 - new transfer ducts

31th floor, M-531.00 | Before = Addendum 1 After = Bulletin 3 (rev 4, 08/10/2026)

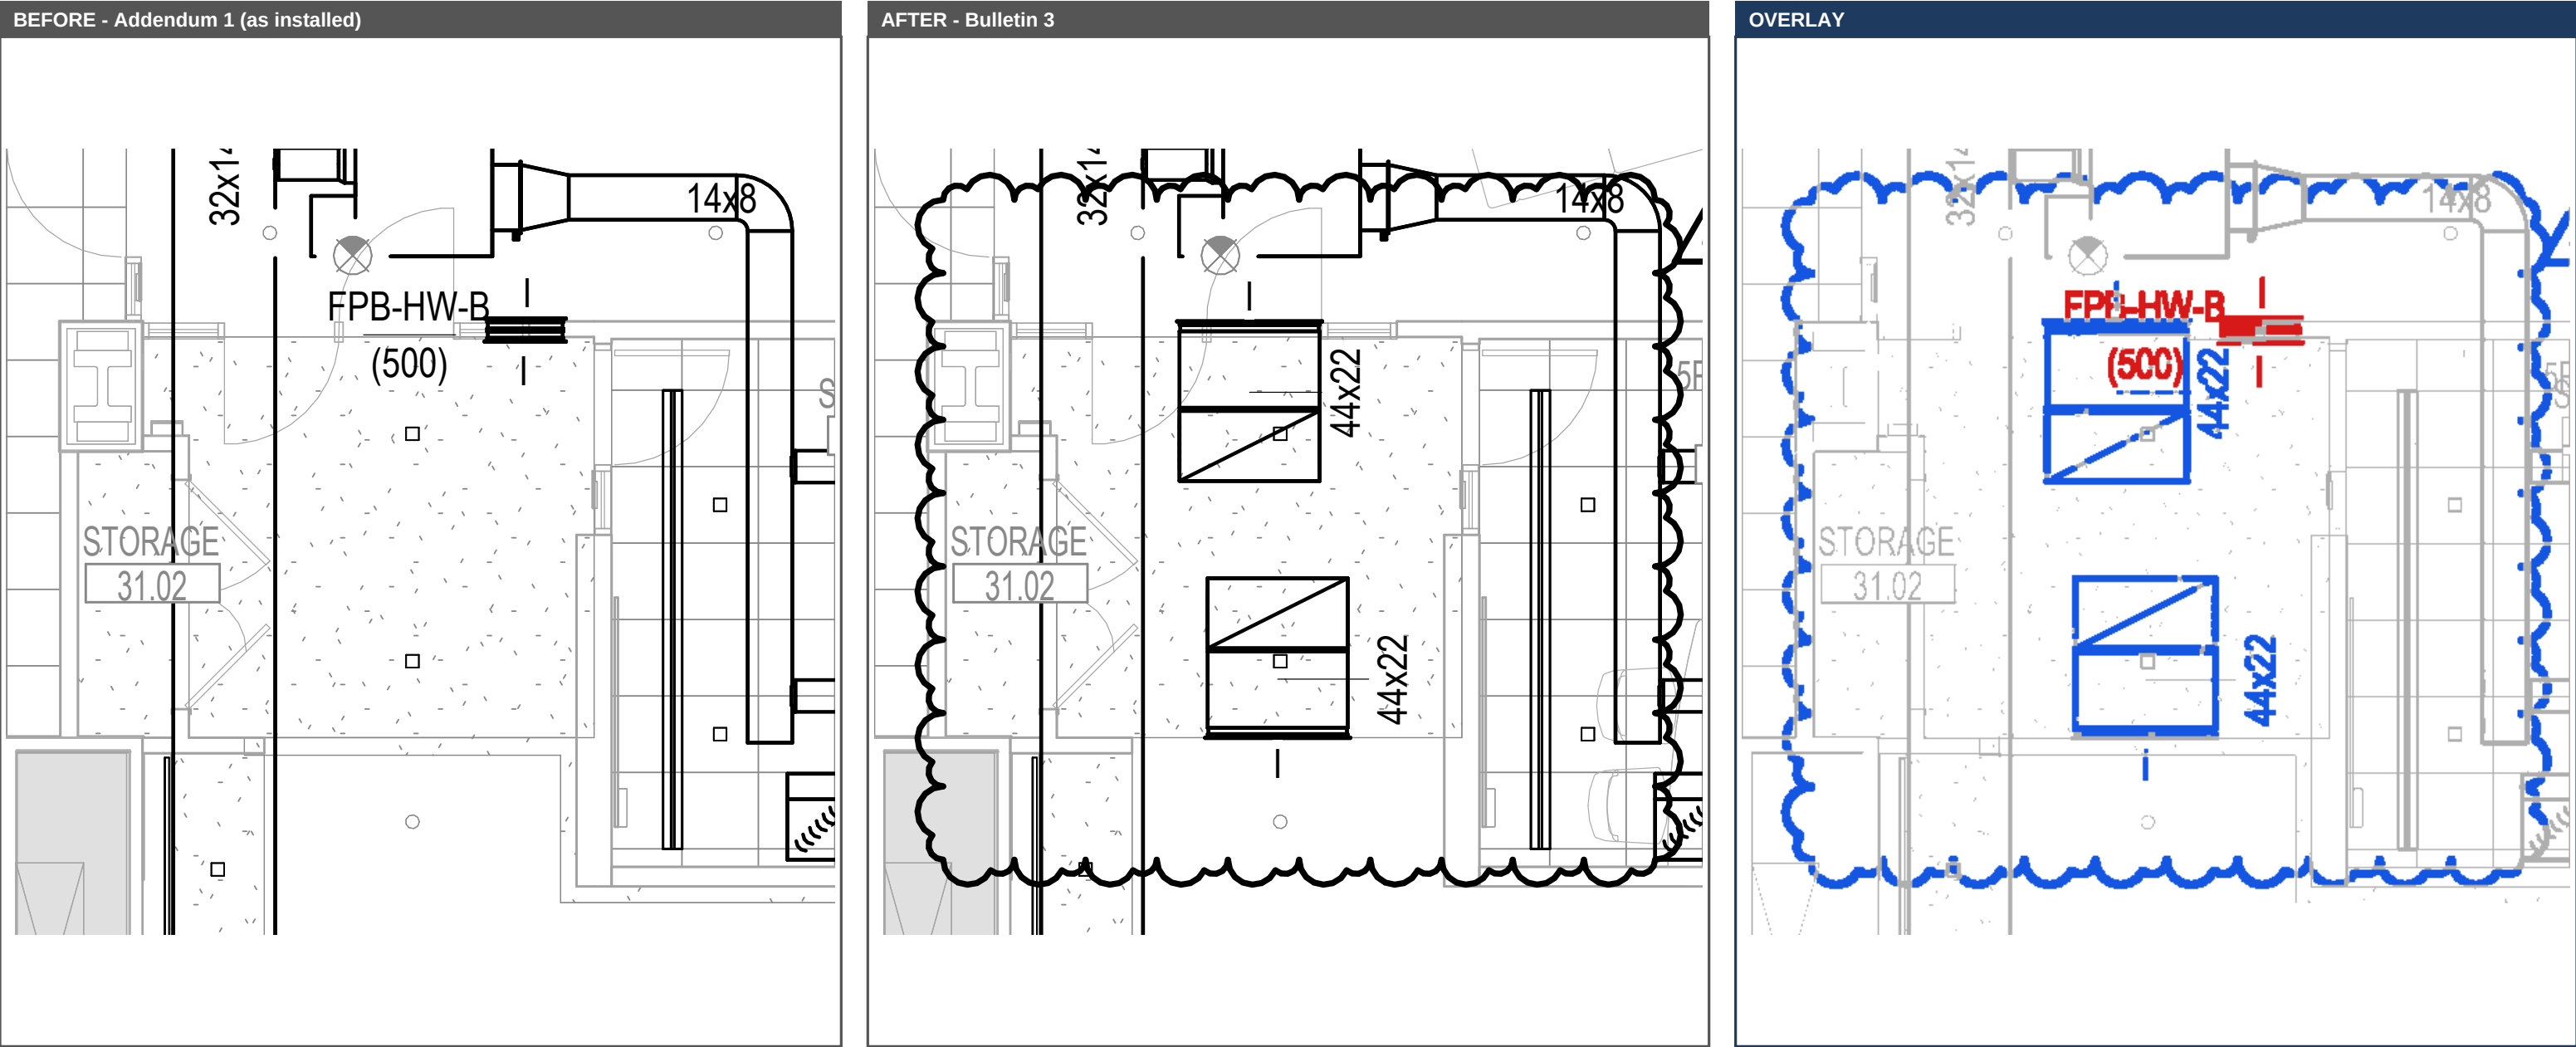


- Unchanged
- Addendum 1 only - installed, removed
- Bulletin 3 only - new work

Before (Addendum 1, installed): No transfer ducts; volume damper at FPB-HW-B (500) branch.

After (Bulletin 3): (2) new 44x22 transfer ducts.

Work required: Remove affected branch fitting; fabricate and install (2) 44x22 lined transfer ducts.

Cost item	Qty	Unit	Rate	Amount
Disconnect / removal of installed ductwork, haul away (labor)	2	MH	\$125	\$250
Fabricated ductwork, fittings, insulation, accessories (material)	1	LS		\$900
Relocation / installation of ductwork (labor)	12	MH	\$125	\$1,500
Area 31-3 total				\$2,650

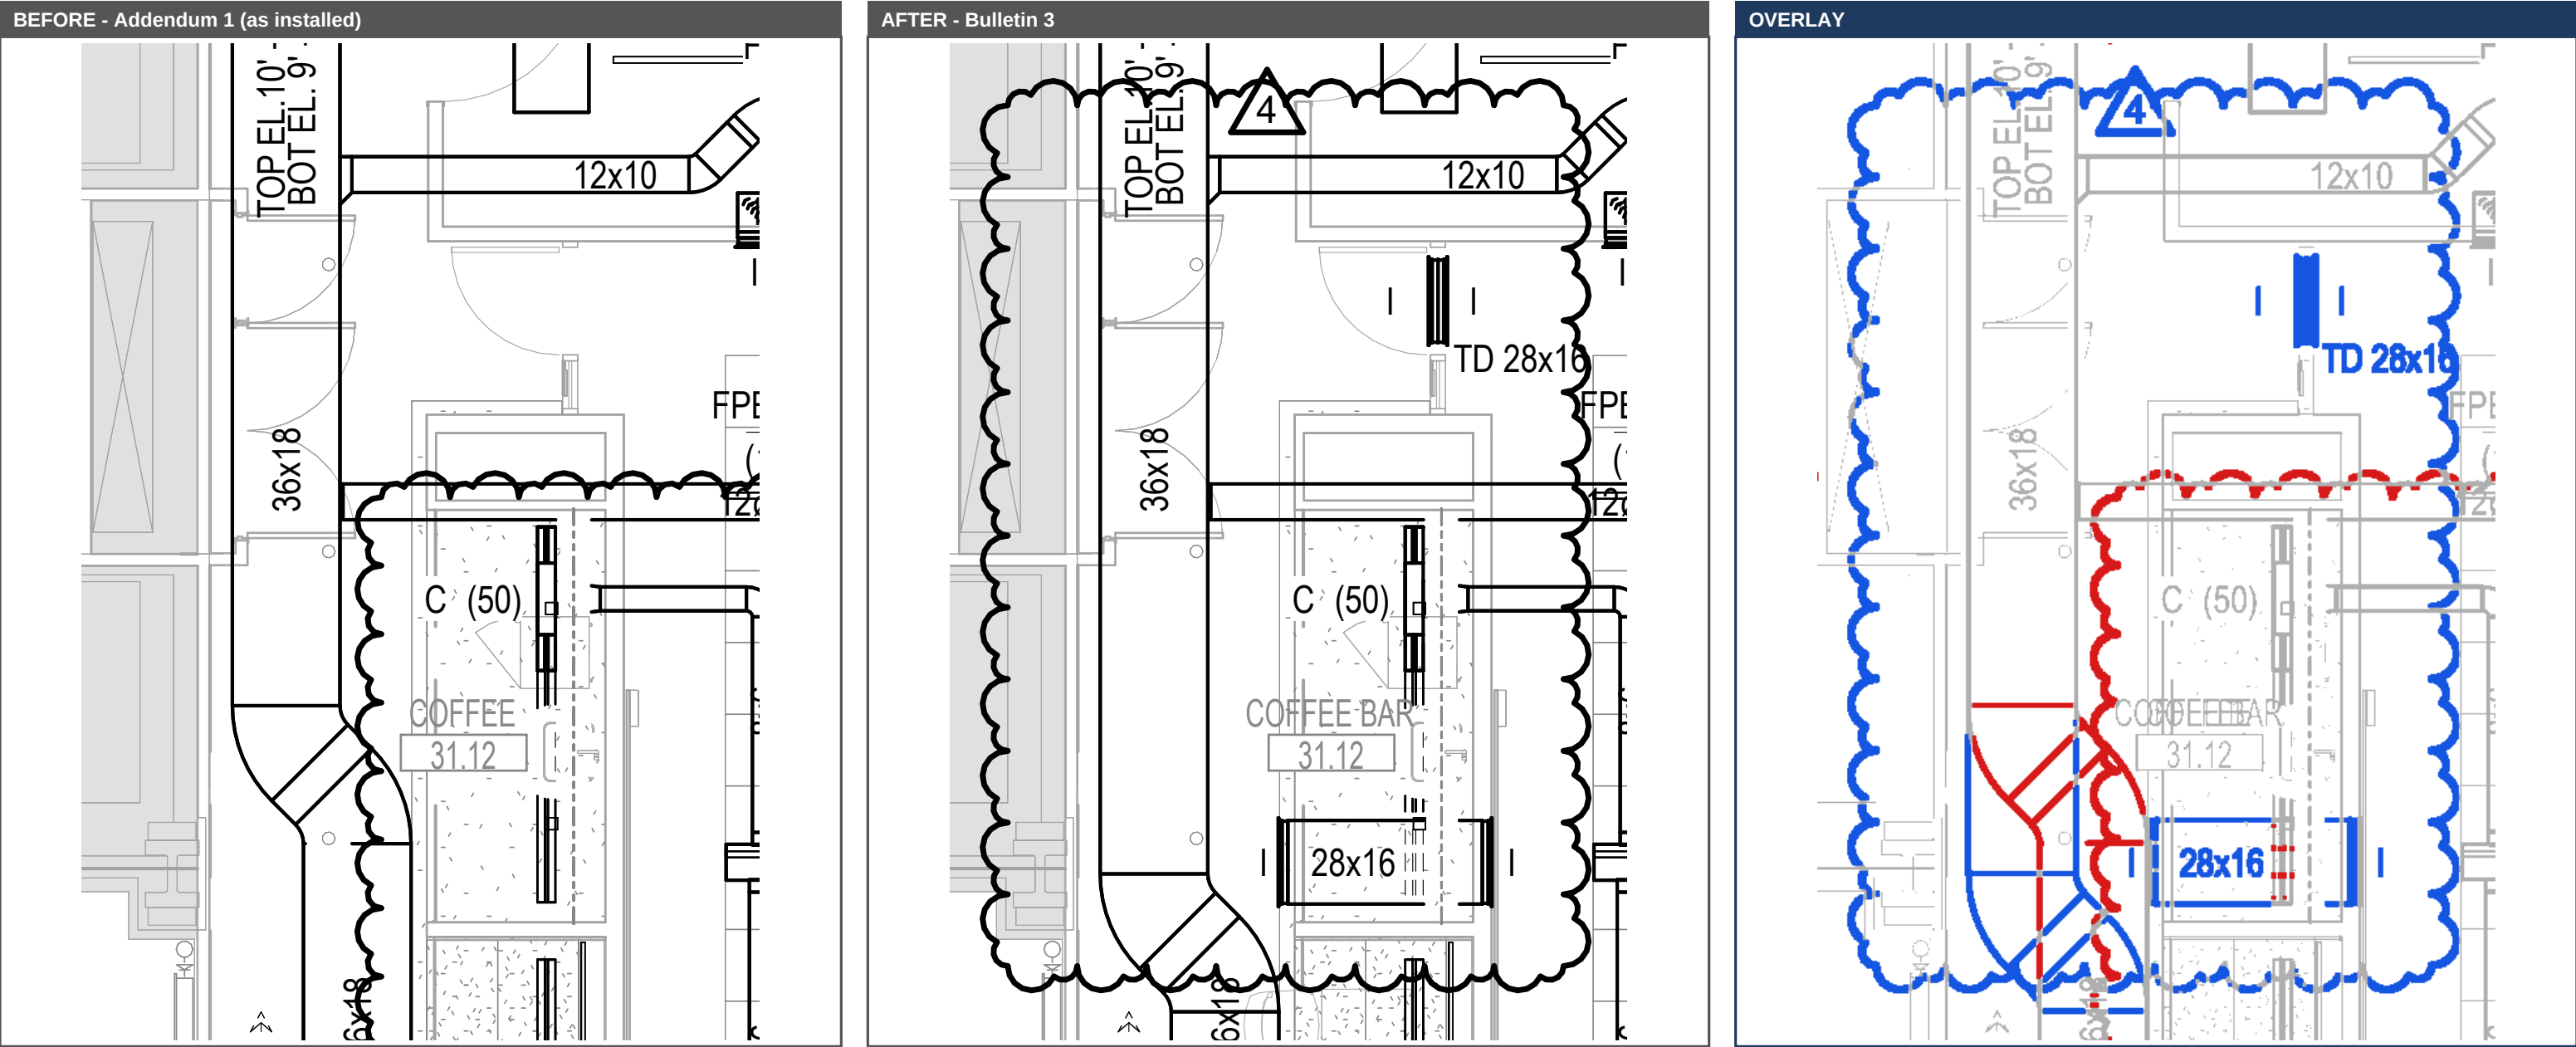


Before (Addendum 1, installed): 36x18 main with elbow at Coffee Bar 31.12; no transfer ducts.

After (Bulletin 3): (2) new TD 28x16; 36x18 main elbow reconfigured.

Work required: Disconnect and remove 36x18 elbow; fabricate and install new fitting and (2) TD 28x16.

Cost item	Qty	Unit	Rate	Amount
Disconnect / removal of installed ductwork, haul away (labor)	4	MH	\$125	\$500
Fabricated ductwork, fittings, insulation, accessories (material)	1	LS		\$1,100
Relocation / installation of ductwork (labor)	18	MH	\$125	\$2,250
Area 31-4 total				\$3,850

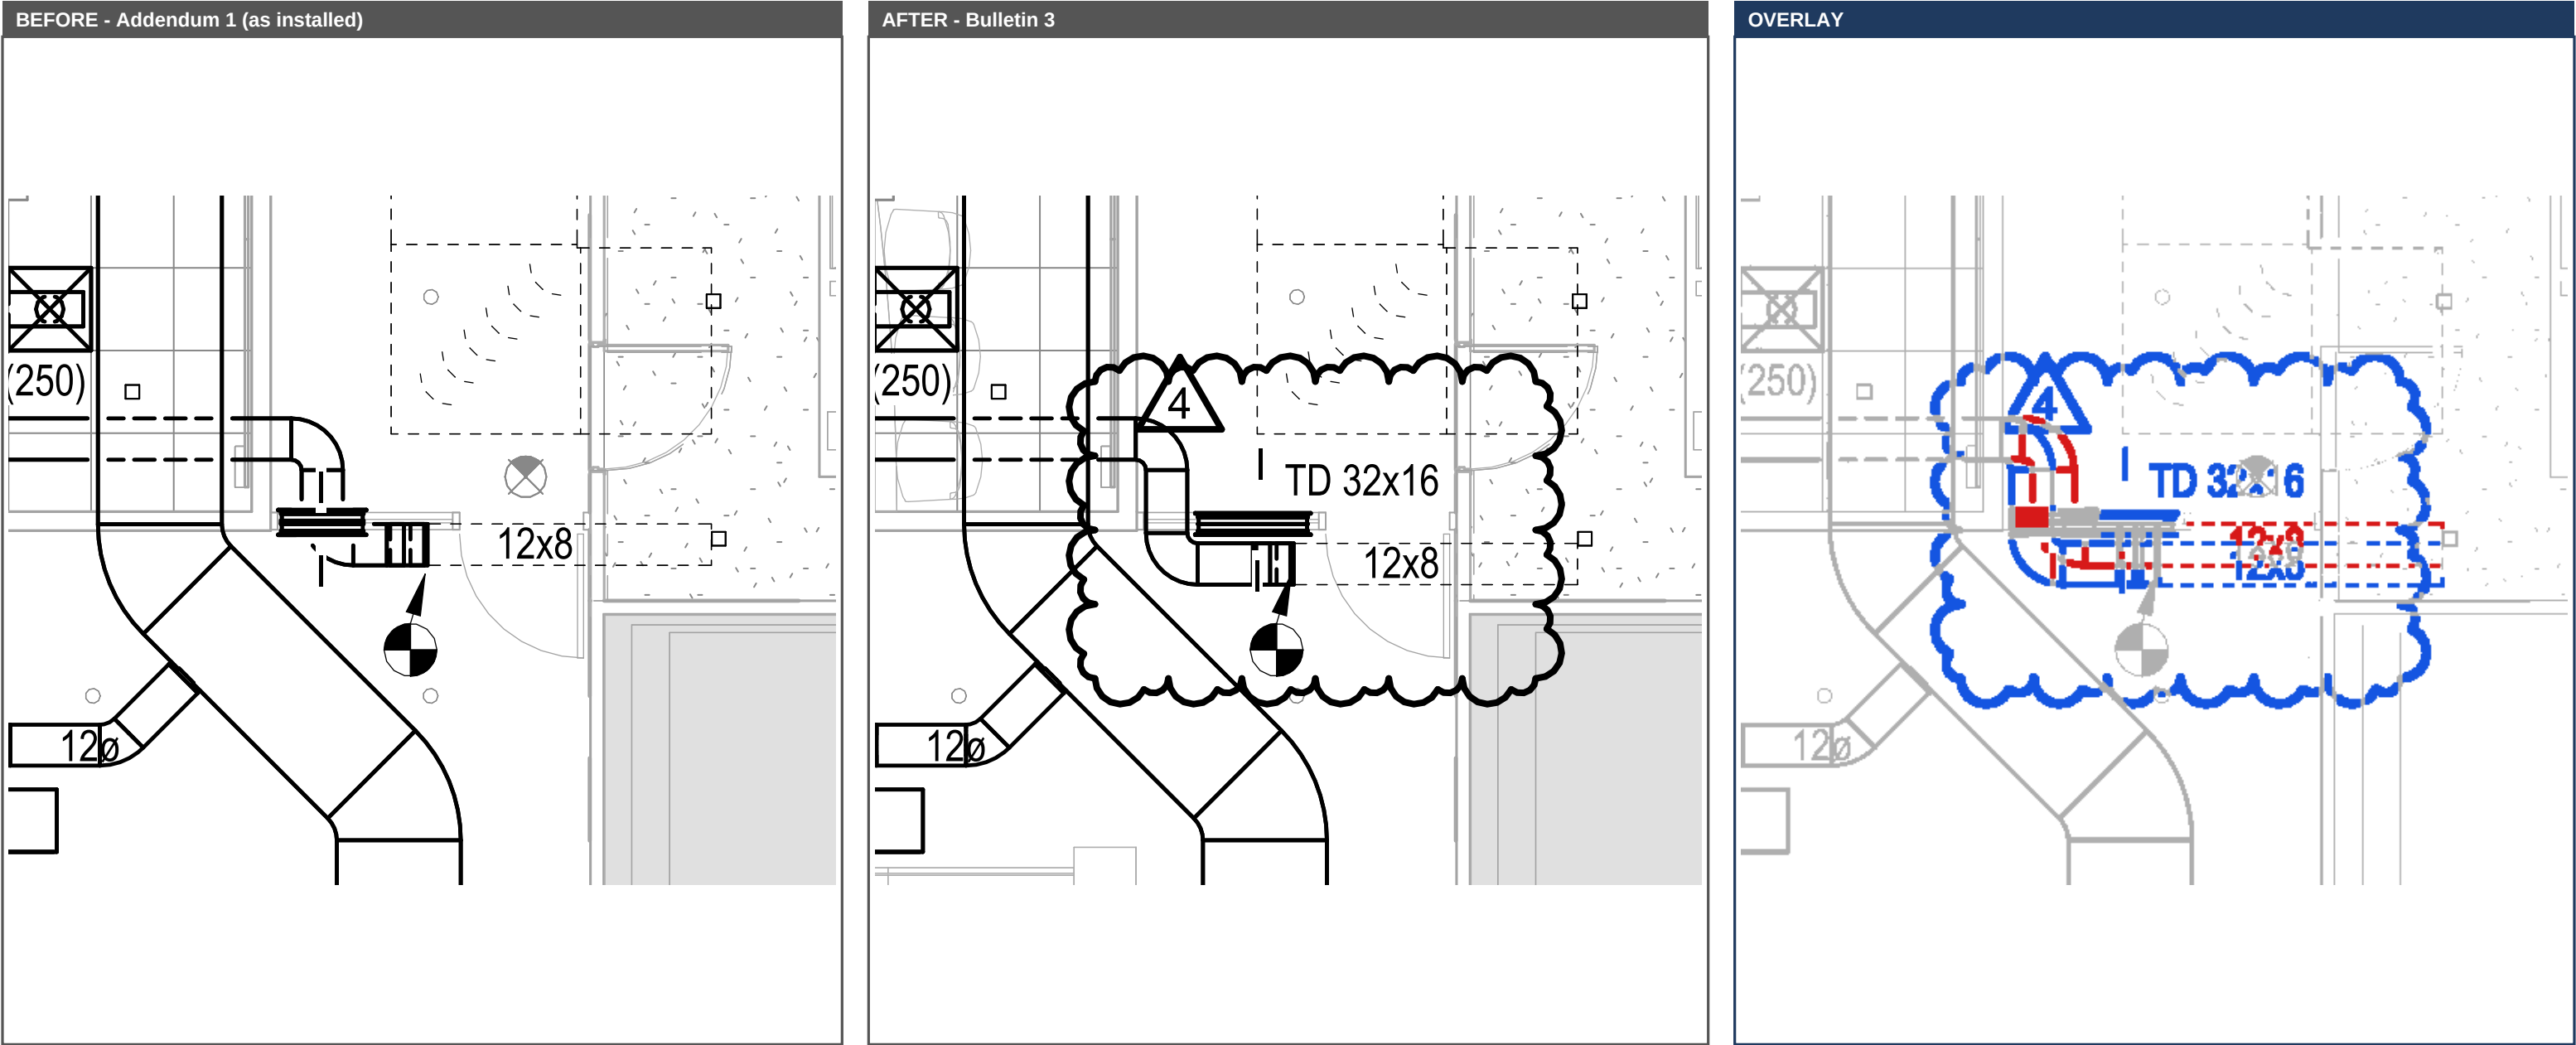

— Unchanged
— Addendum 1 only - installed, removed
— Bulletin 3 only - new work

Before (Addendum 1, installed): Transfer duct and duct elbow as installed per Addendum 1, next to the 12x8 branch.


After (Bulletin 3): Transfer duct revised to TD 32x16; elbow deleted.

Work required: Remove installed transfer duct and elbow; fabricate and install TD 32x16.


Cost item	Qty	Unit	Rate	Amount
Disconnect / removal of installed ductwork, haul away (labor)	1	MH	\$125	\$125
Fabricated ductwork, fittings, insulation, accessories (material)	1	LS		\$300
Relocation / installation of ductwork (labor)	5	MH	\$125	\$625
Area 31-5 total				\$1,050

31th floor, M-531.00 | Before = Addendum 1 After = Bulletin 3 (rev 4, 08/10/2026)


BEFORE - Addendum 1 (as installed)

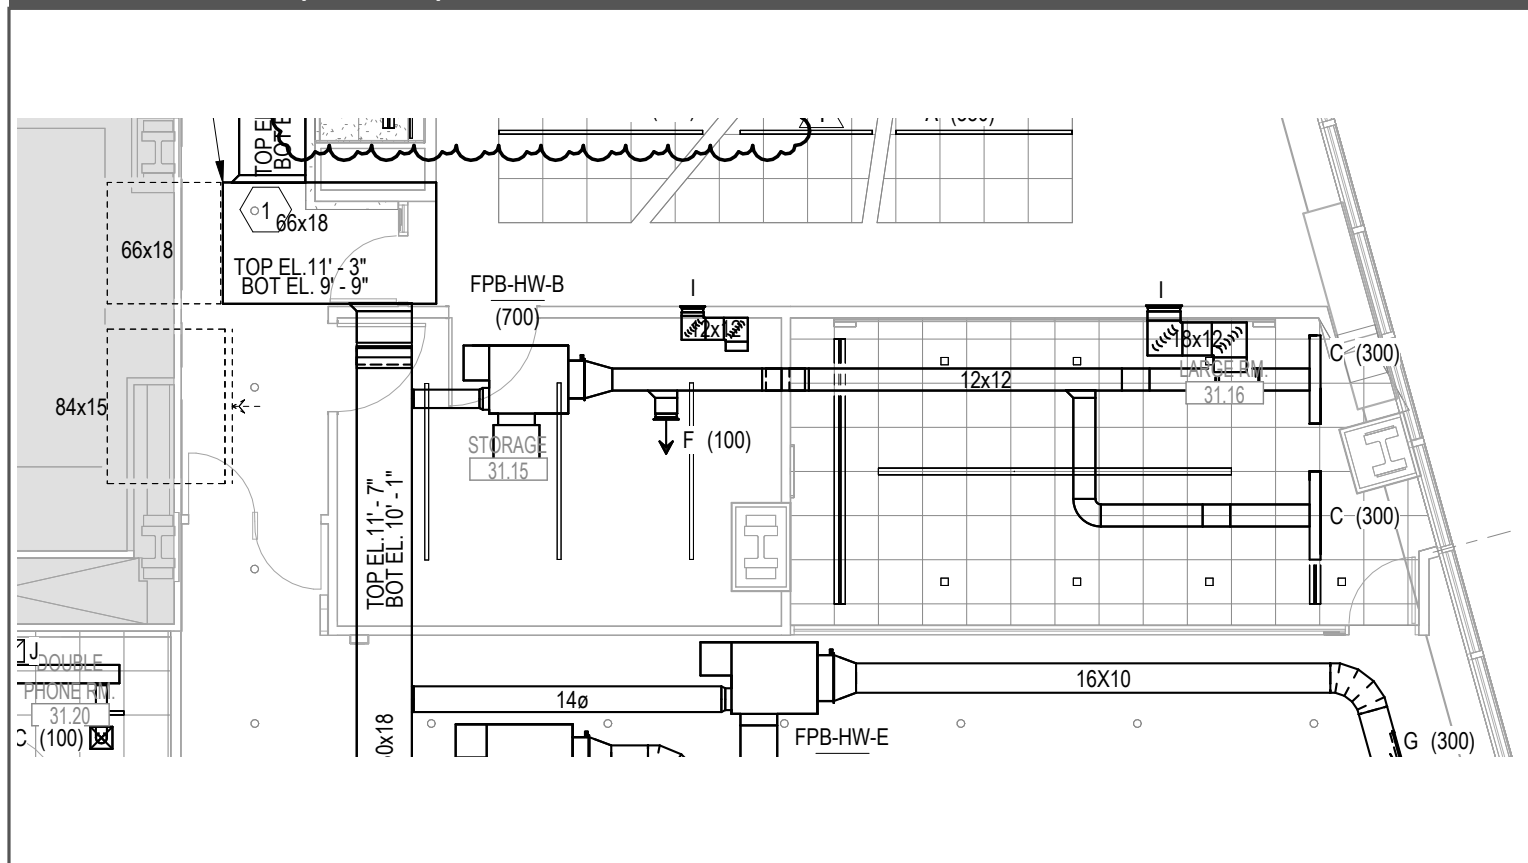

AFTER - Bulletin 3

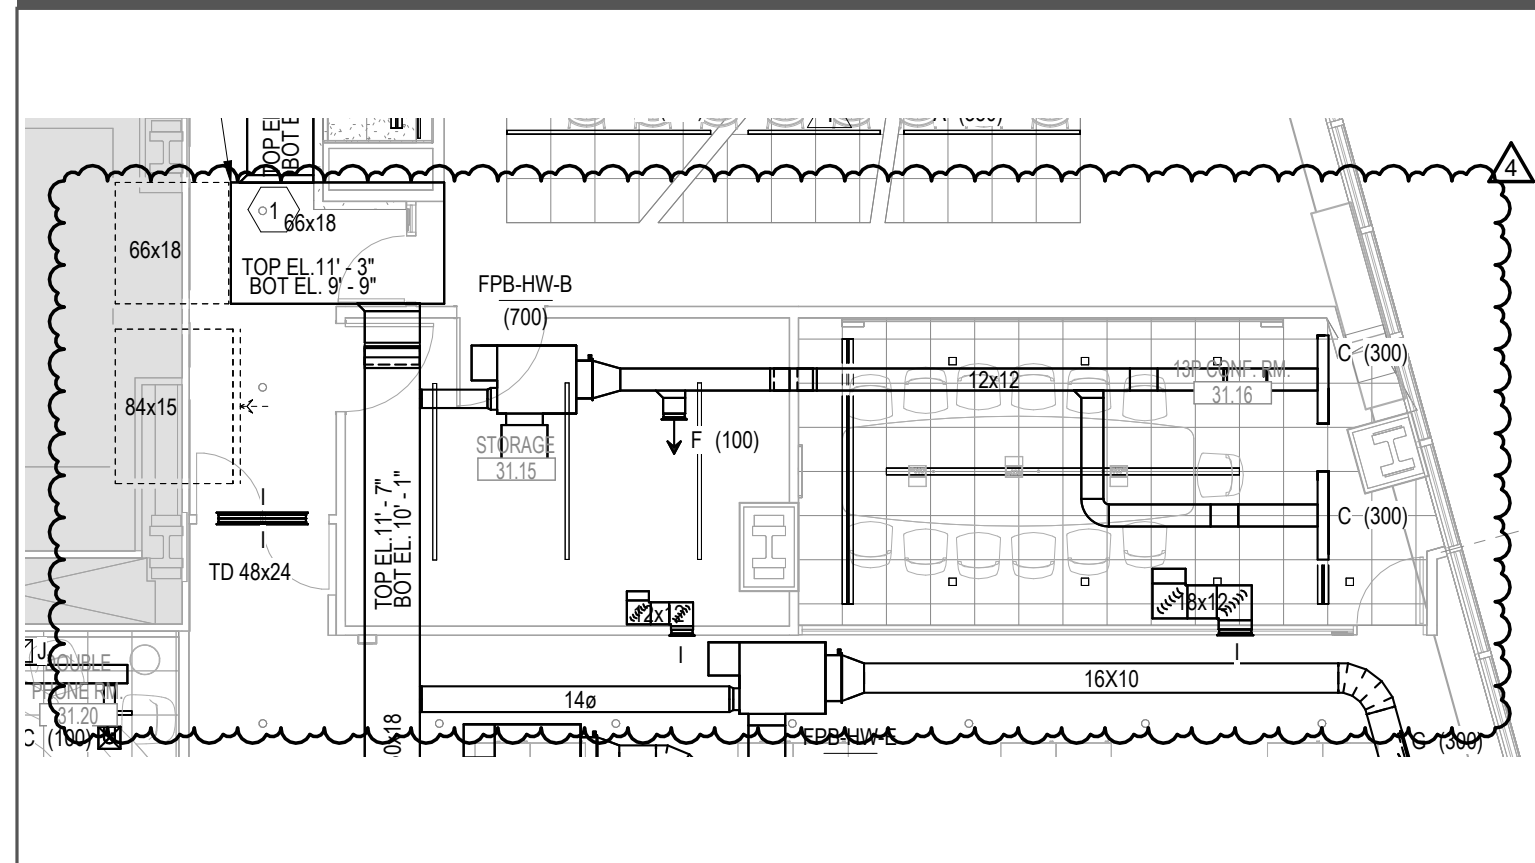

OVERLAY

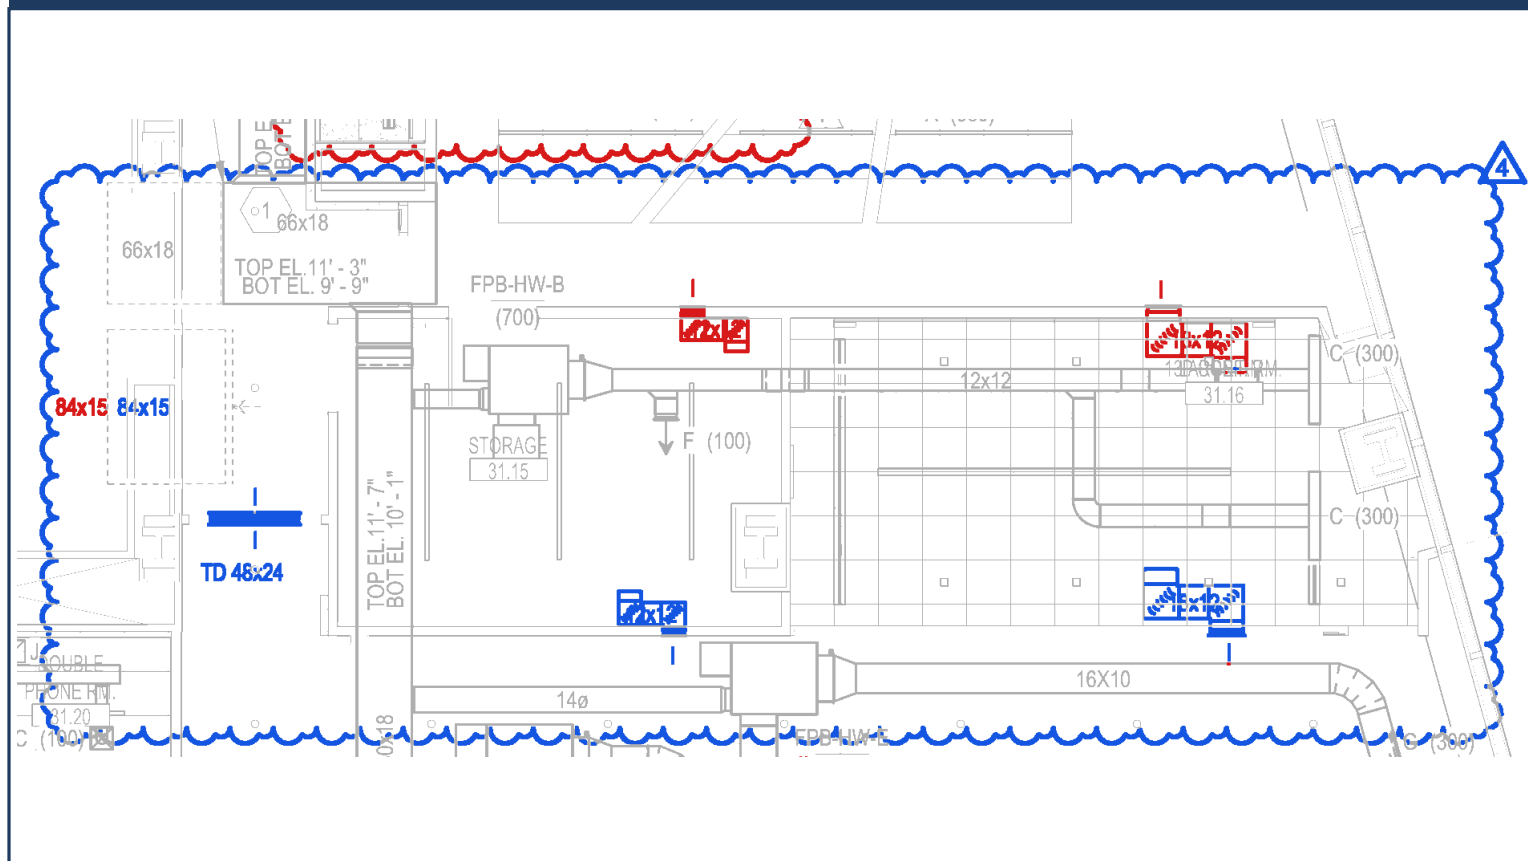

- Unchanged
■ Addendum 1 only - installed, removed
■ Bulletin 3 only - new work

Before (Addendum 1, installed): 12x12 and 18x12 grilles at previous locations; no transfer duct at Storage 31.15.

After (Bulletin 3): New TD 48x24; 12x12 and 18x12 grilles relocated.

Work required: Remove grilles and their duct connections; fabricate and install TD 48x24, F&I 12x12 and 18x12 grilles with duct connections at new locations.

Cost item	Qty	Unit	Rate	Amount
Disconnect / removal of installed ductwork, haul away (labor)	3	MH	\$125	\$375
Fabricated ductwork, fittings, insulation, accessories (material)	1	LS		\$1,450
Relocation / installation of ductwork (labor)	24	MH	\$125	\$3,000
Air outlets (material)	1	LS		\$900
Air outlet installation (labor)	4	MH	\$125	\$500
Area 31-6 total				\$6,225