
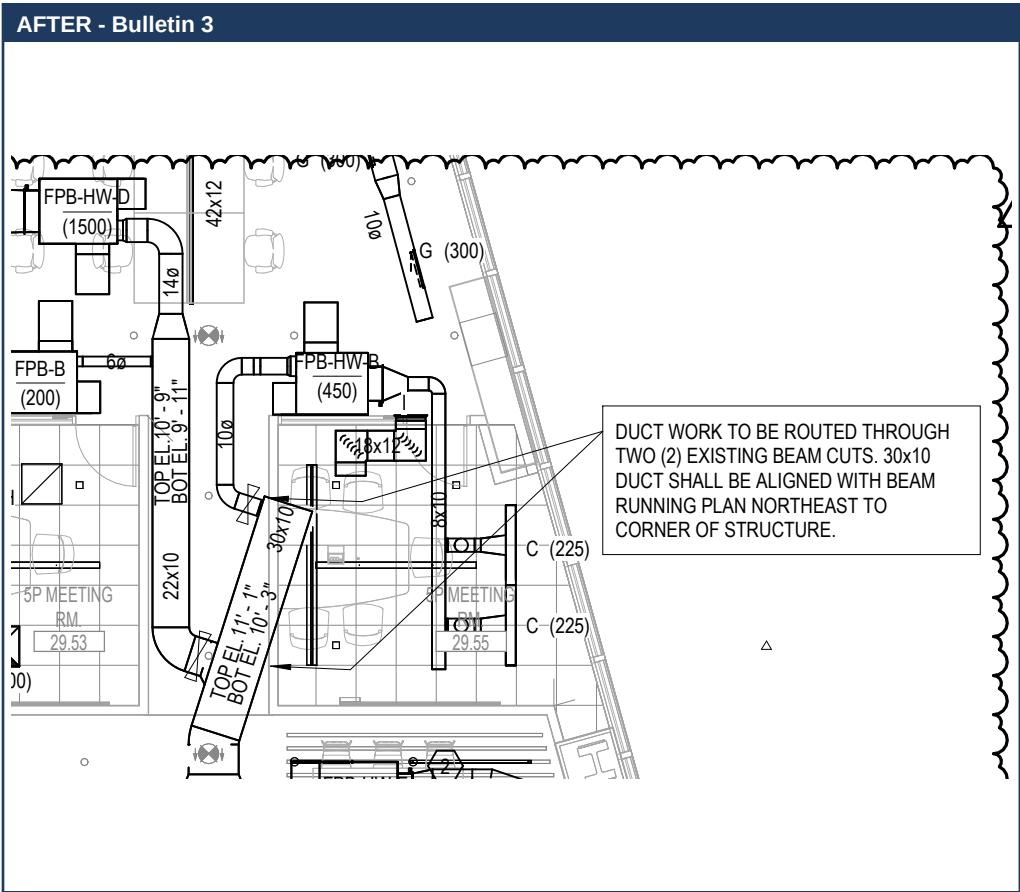


29th Floor - M-529.00: Change Areas, Before and After


Before = Addendum 1 (fabricated and installed) After = Bulletin 3 (rev 4, 08/10/2026) | 29th floor total \$29,600 - scope and costs on next page

Snowflake Fitout - 7 Times Square, Floors 29-31 | COP-SF-05 Bulletin 3 Revision


29-1 North supply main - reroute through existing beam cuts \$15,075

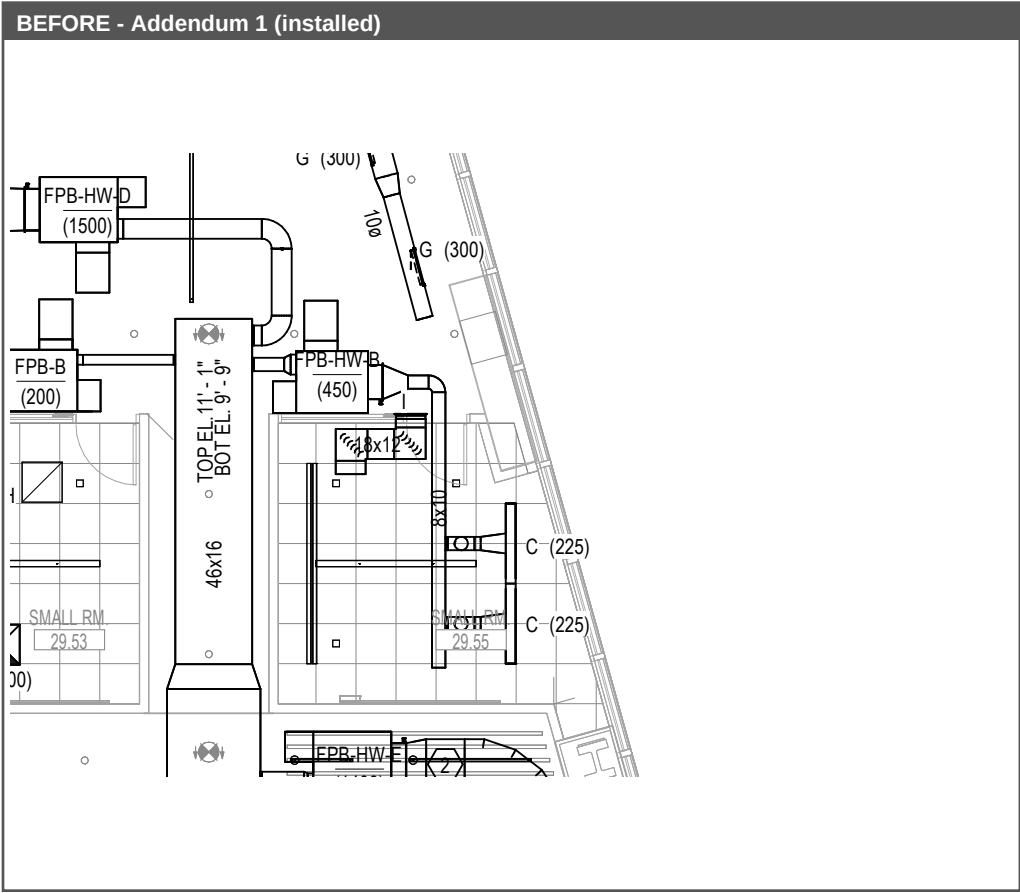

29-2 Supply main resized 56x16 to 42x12 \$11,025

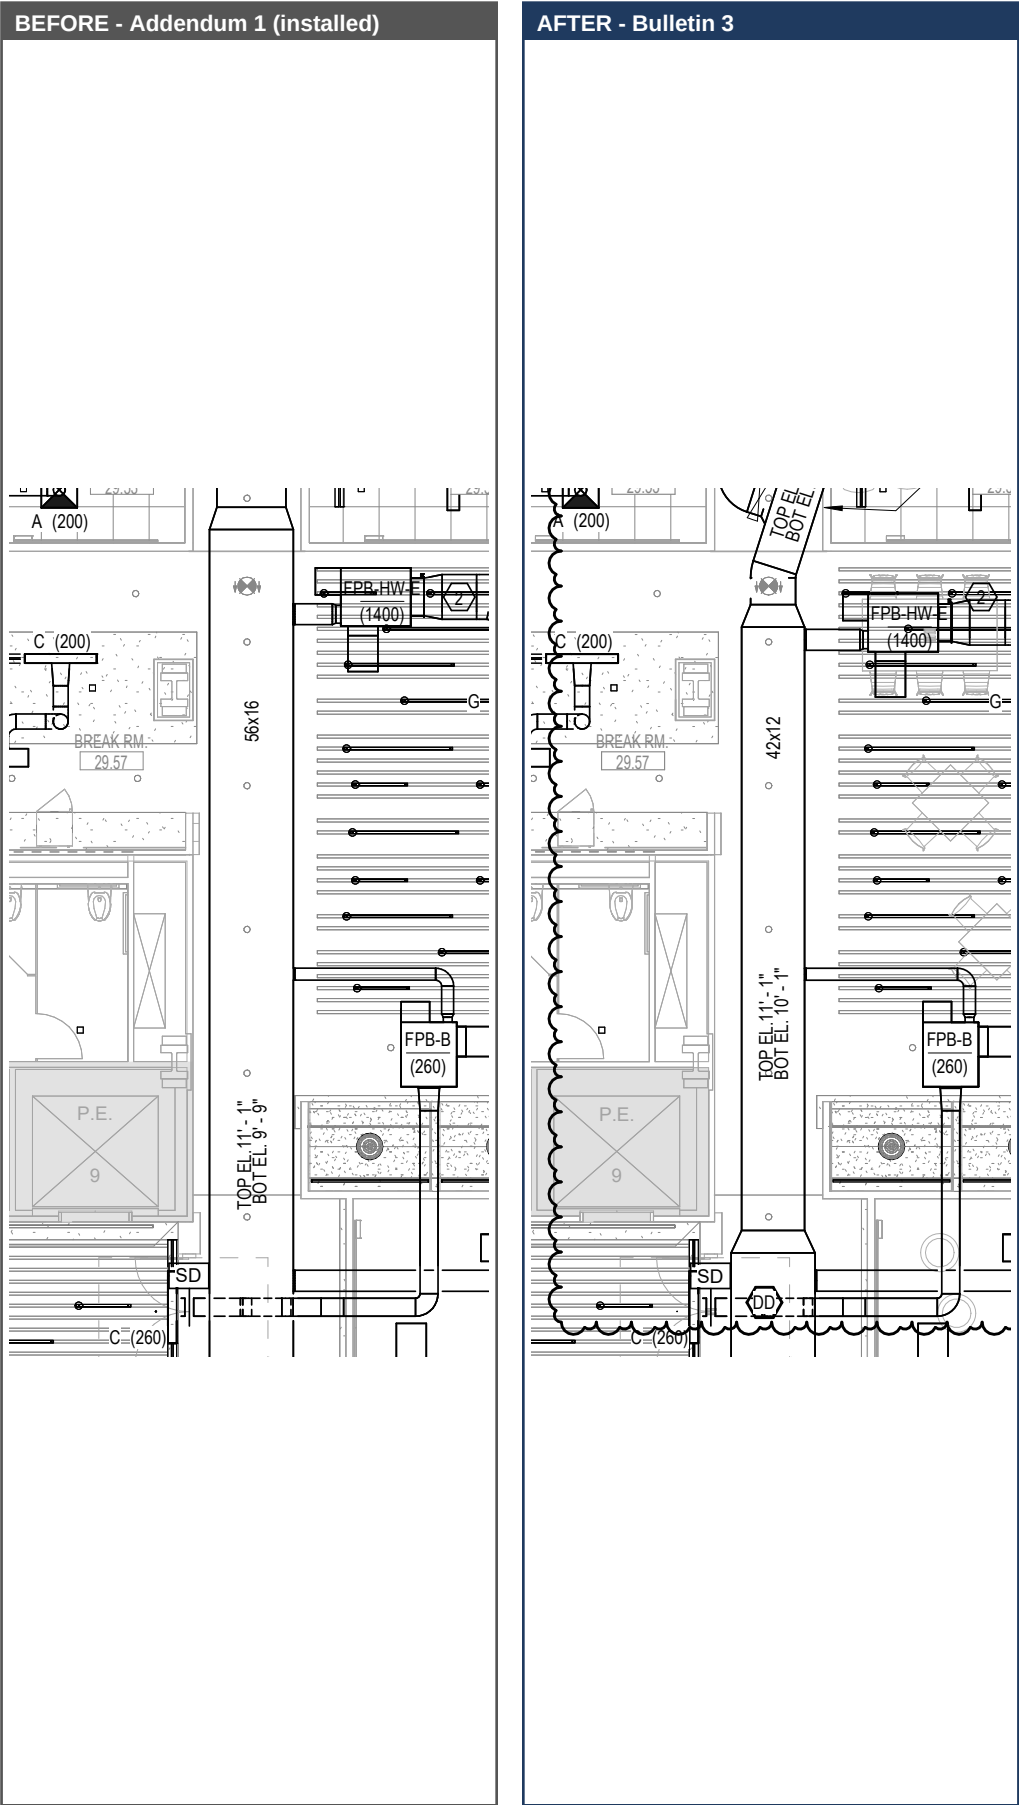

29-3 FPB-HW-E (1400) relocation and discharge reroute \$2,500

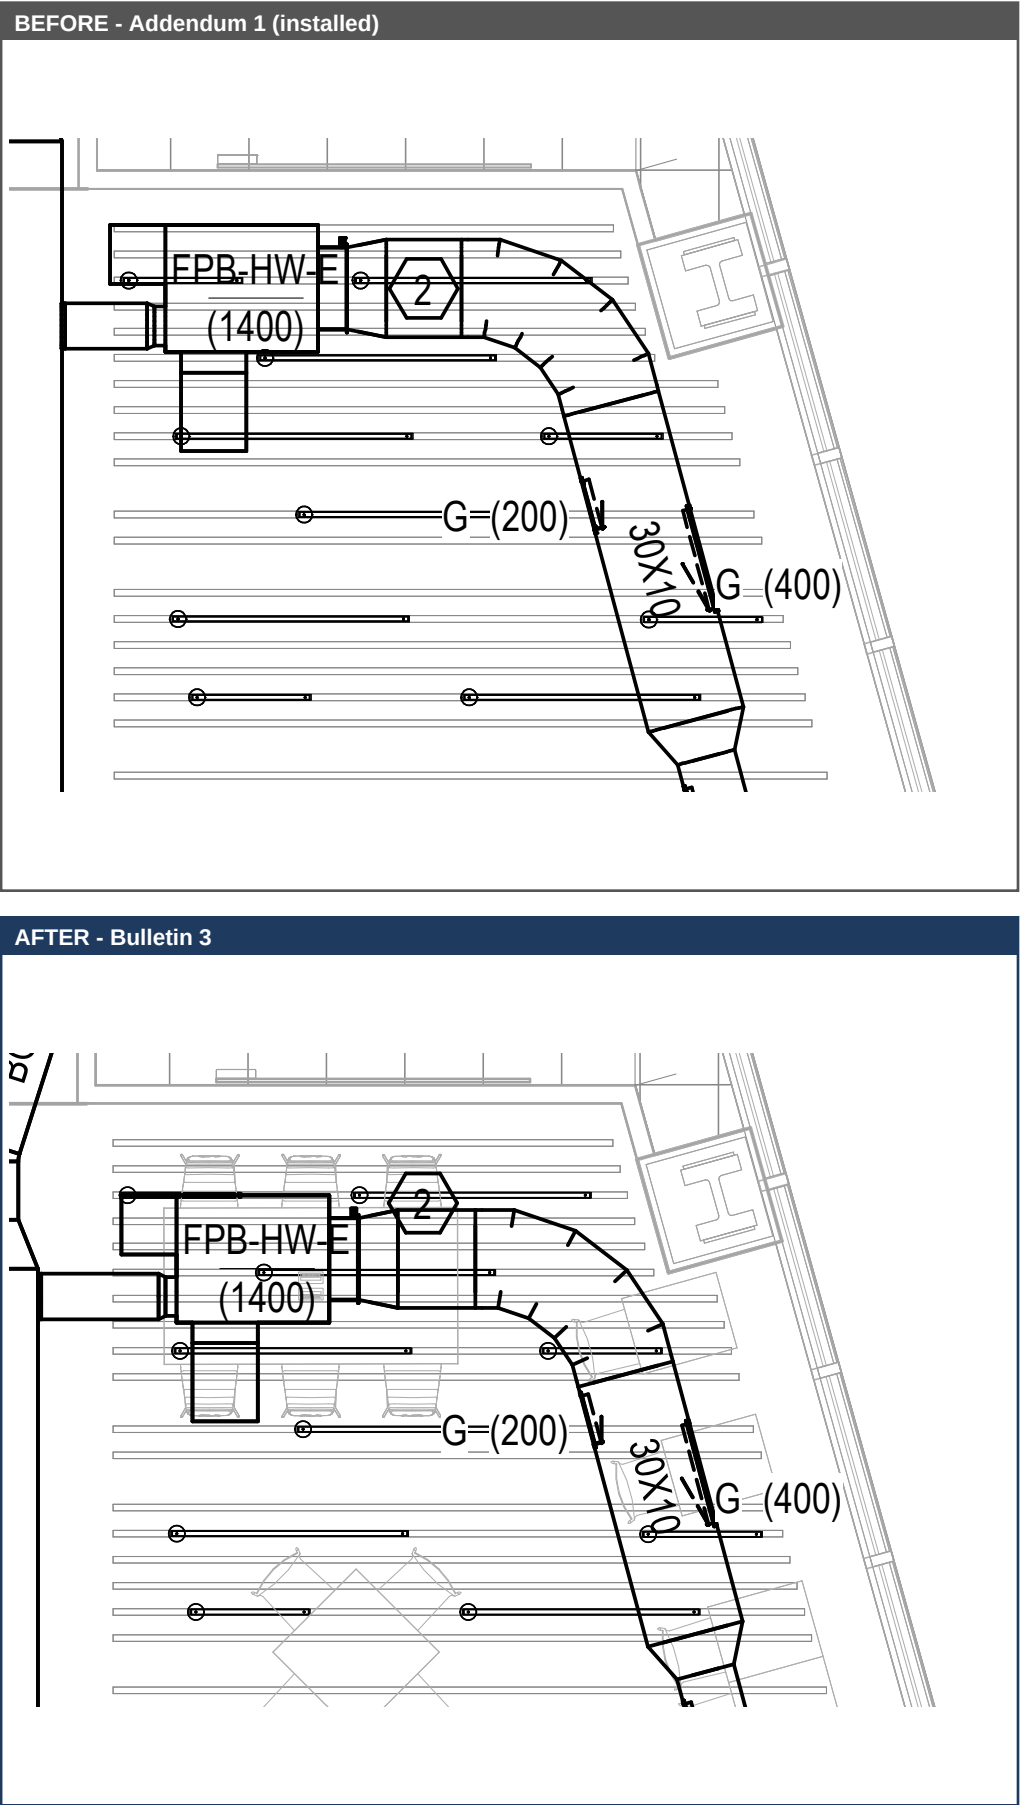


29th Floor - M-529.00: Scope of Work and Cost Breakdown

Labor at \$125.00 per man-hour | Disconnect = removal of installed Addendum 1 work incl. haul away | Material = fabricated ductwork, fittings, insulation, accessories and air outlets | Snowflake Fitout - 7 Times Square, Floors 29-31 | COP-SF-05 Bulletin 3 Revision

Area	Scope of work	Disconnect / removal	Material	Install labor	Total
29-1	North supply main - reroute through existing beam cuts Before: 46x16 supply main (approx. 20 LF, bottom el. 9'-9") with branch connections to FPB-HW-D (1500), FPB-HW-B (450) and FPB-B (200). After: Main rerouted as 22x10 and 30x10 through (2) existing beam cuts, 30x10 aligned with the beam running plan northeast. New 14ø branch to FPB-HW-D, 10ø to FPB-HW-B and 6ø to FPB-B. Work: Disconnect and remove installed 46x16 section and branch connections. Fabricate and install 22x10 / 30x10 duct and round branches with insulation, reconnect terminal units.	12 MH \$1,500	\$6,075	60 MH \$7,500	\$15,075
29-2	Supply main resized 56x16 to 42x12 Before: 56x16 supply main, approx. 44 LF, top el. 11'-1" / bottom el. 9'-9", Break Rm 29.57 to P.E. After: Main resized to 42x12 on the same route, top el. 11'-1" / bottom el. 10'-1". Work: Disconnect and remove installed 56x16 main. Fabricate and install 42x12 main with insulation, reconnect branch takeoffs (FPB-HW-E, FPB-B (260)).	7 MH \$875	\$3,900	50 MH \$6,250	\$11,025
29-3	FPB-HW-E (1400) relocation and discharge reroute Before: FPB-HW-E (1400) with inlet and 30x10 discharge to the G(400) / G(200) linear diffusers along the northeast wall. After: FPB-HW-E relocated; inlet connection and 30x10 discharge elbow rerouted. Work: Disconnect inlet and discharge, relocate and rehang FPB-HW-E, fabricate and install new inlet and 30x10 discharge fittings, reconnect.	2 MH \$250	\$750	12 MH \$1,500	\$2,500
	Shop drawings for revised design				\$1,000
	29th floor total (21 MH disconnect, 122 MH install)	\$2,625	\$10,725	\$15,250	\$29,600

Key plan - Bulletin 3

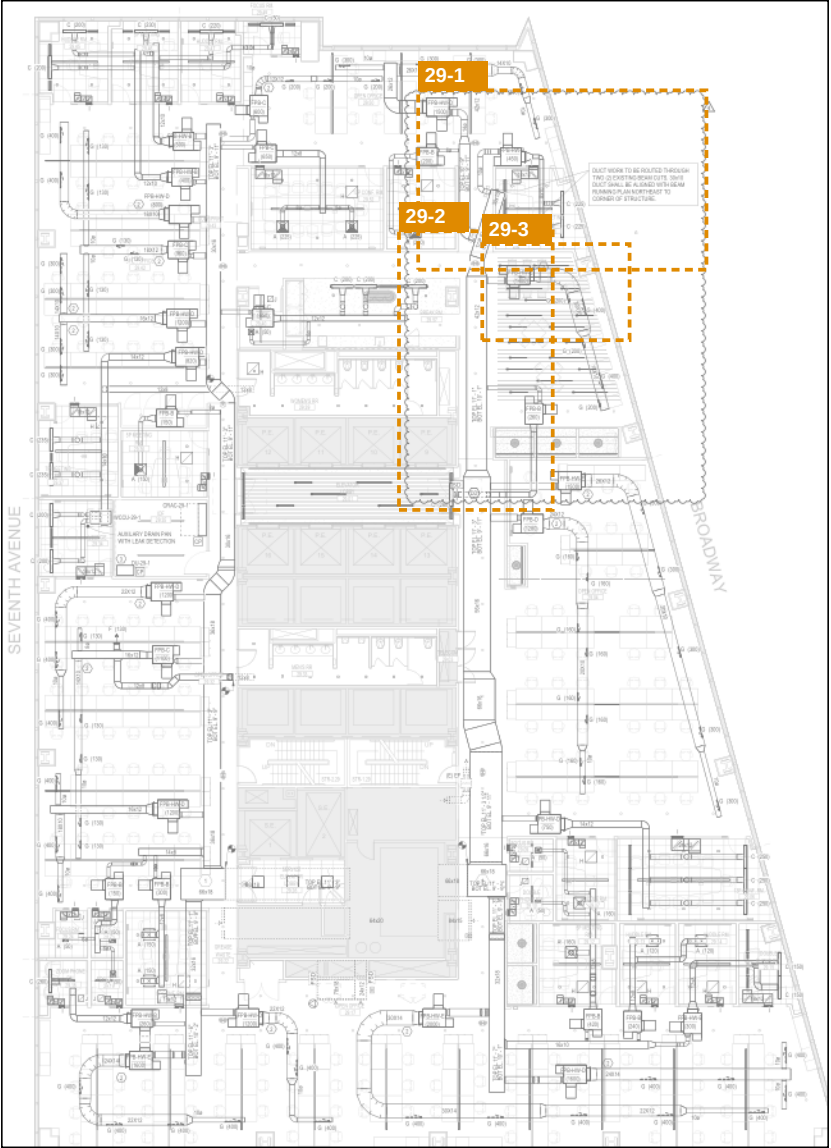


COP-SF-05 summary


Floor	Total
29th floor (M-529.00)	\$29,600
30th floor (M-530.00)	\$18,100
31st floor (M-531.00)	\$19,080
COP-SF-05 total	\$66,780

Bulletin 3 was issued after the ductwork in these areas had been fabricated and installed per Addendum 1, so each area includes disconnecting and removing the installed work. Quantities are approximate, taken from the drawings at 1/8" = 1'-0".


30-1 IT Build Rm 30.23 / F&B Storage 30.14 / west dining \$6,700

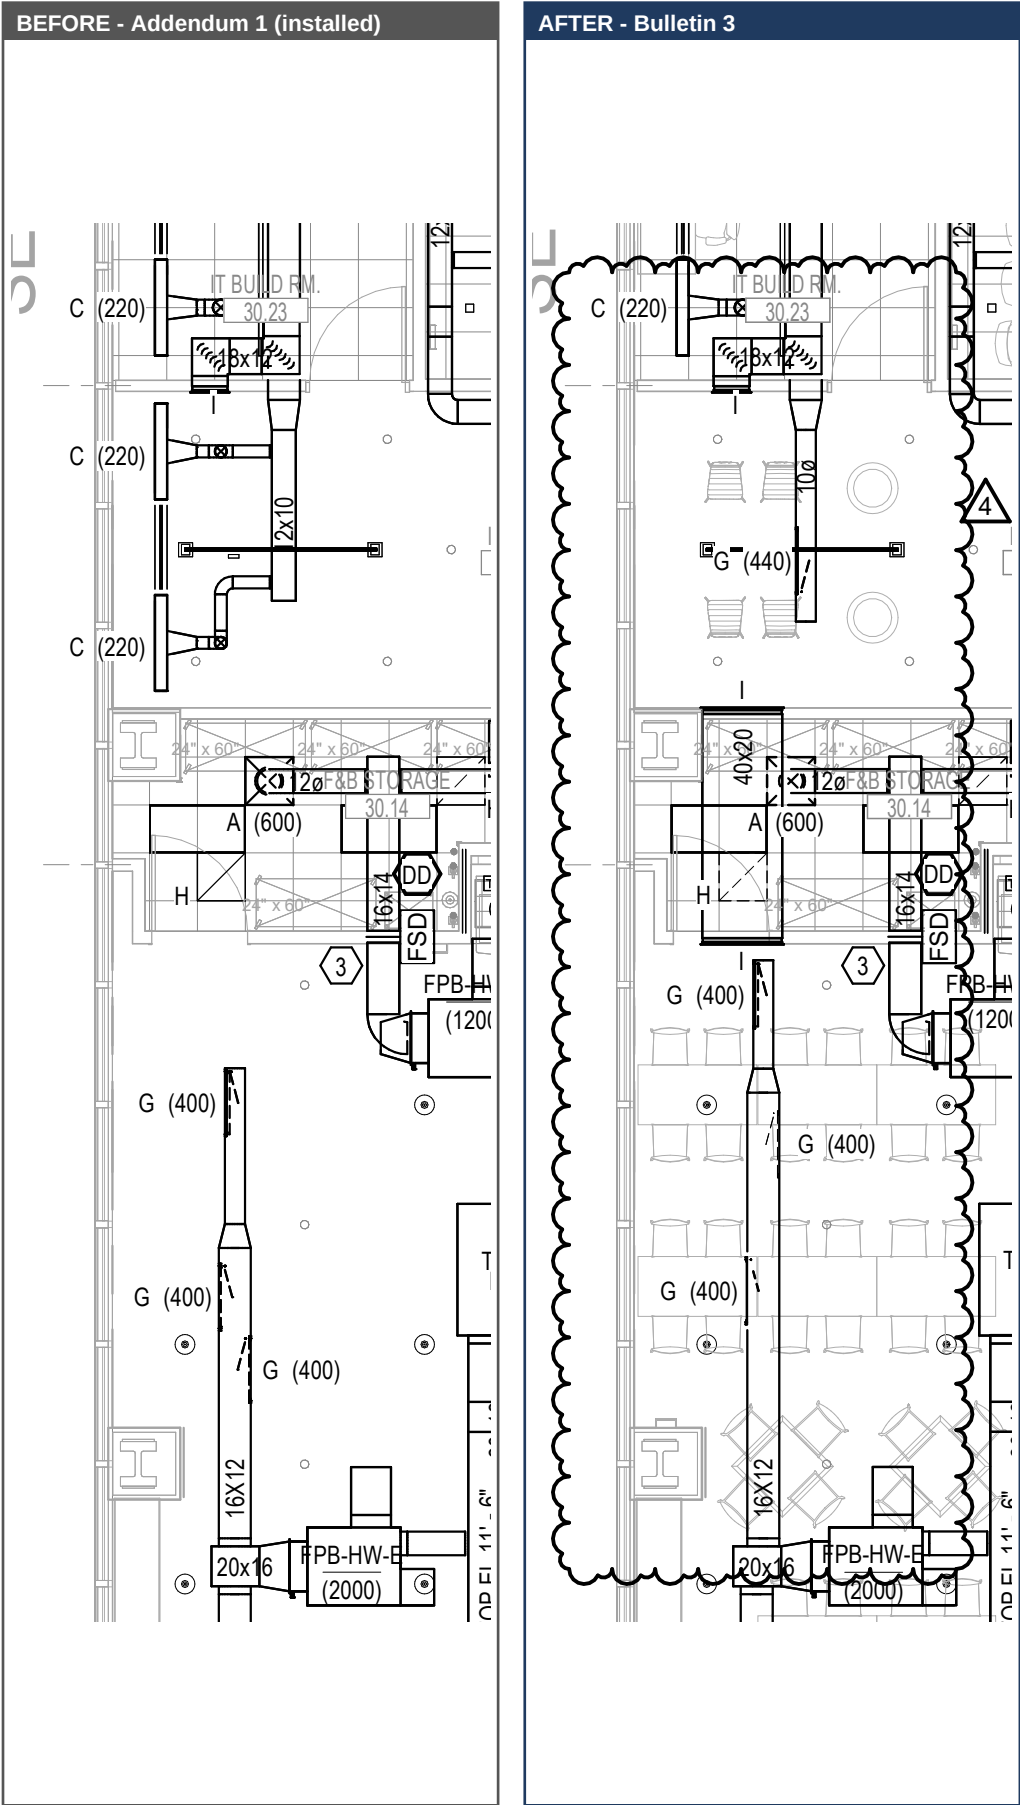

30-2 Lounge 30.02 - new transfer ducts \$5,400

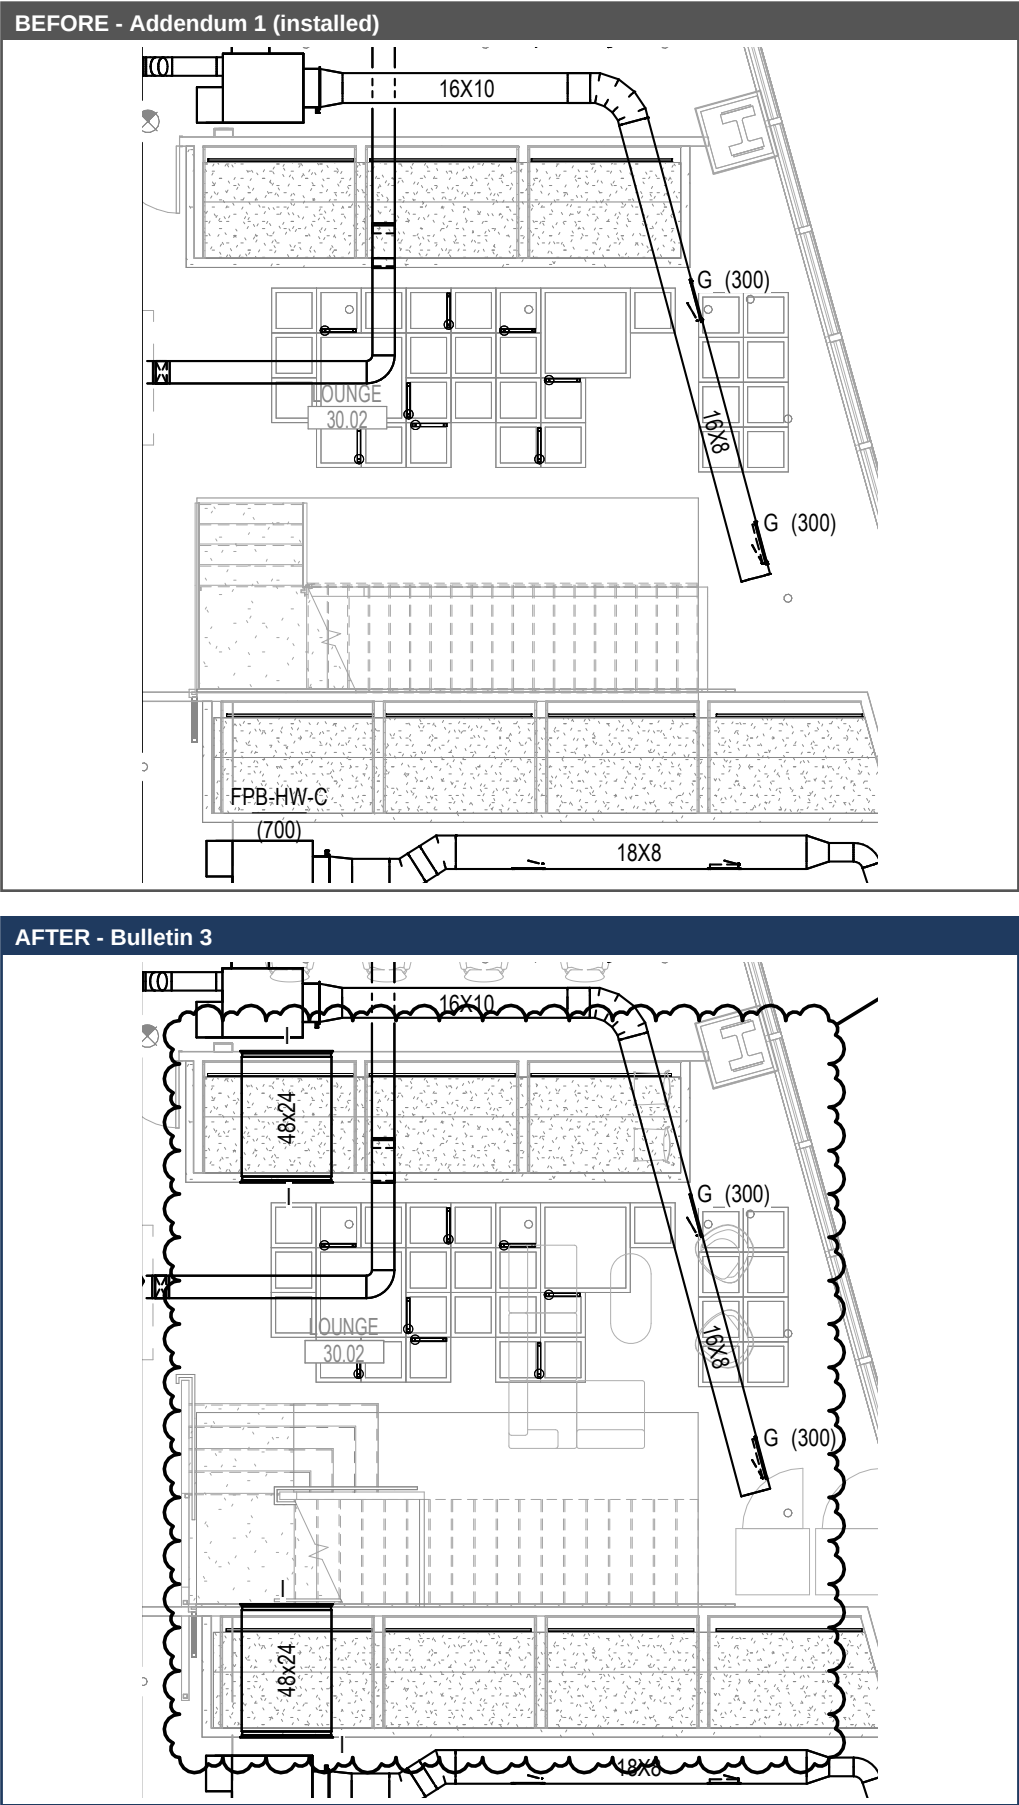

30-3 Meeting Rms 30.04 / 30.05, Storage 30.09, Vestibule 30.07 \$5,000

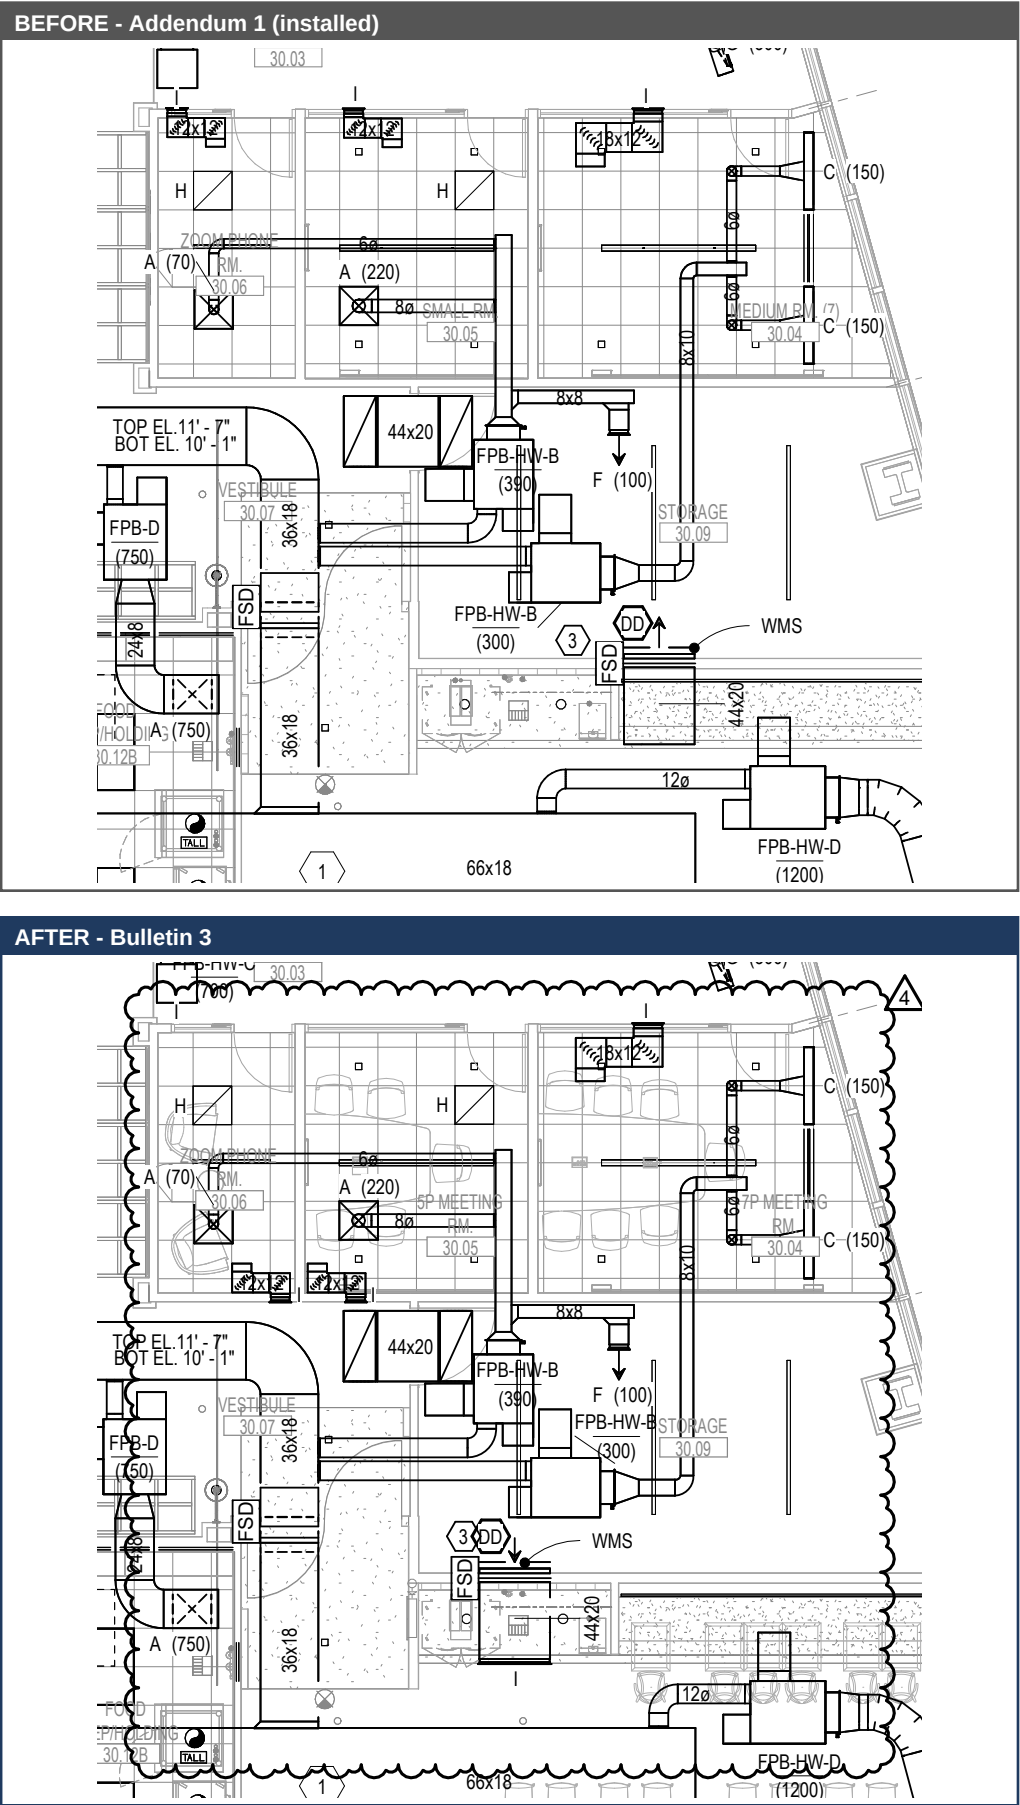


30th Floor - M-530.00: Scope of Work and Cost Breakdown

Labor at \$125.00 per man-hour | Disconnect = removal of installed Addendum 1 work incl. haul away | Material = fabricated ductwork, fittings, insulation, accessories and air outlets | Snowflake Fitout - 7 Times Square, Floors 29-31 | COP-SF-05 Bulletin 3 Revision

Area	Scope of work	Disconnect / removal	Material	Install labor	Total
30-1	IT Build Rm 30.23 / F&B Storage 30.14 / west dining Before: 12x10 branch with (2) C(220) ceiling diffusers; G(400) linear diffuser run on 16x12 branch. After: 12x10 branch and (2) C(220) deleted, replaced with 10ø branch to (1) new G(440) linear diffuser. New 40x20 transfer duct at F&B Storage 30.14. G(400) linear diffusers relocated along the 16x12 branch. Work: Disconnect and remove 12x10 branch and (2) C(220). Install 10ø branch, 40x20 transfer duct, rework 16x12 branch. F&I G(440) linear diffuser with plenum, relocate G(400) diffusers.	6 MH \$750	\$2,200	30 MH \$3,750	\$6,700
30-2	Lounge 30.02 - new transfer ducts Before: No transfer ducts at Lounge 30.02 walls. After: (2) new 48x24 transfer ducts. Work: Fabricate and install (2) 48x24 lined transfer ducts.	-	\$2,150	26 MH \$3,250	\$5,400
30-3	Meeting Rms 30.04 / 30.05, Storage 30.09, Vestibule 30.07 Before: FPB-HW-B (300) with supply connections; 44x20 transfer duct; (2) 12x12 grilles; 12ø branch to FPB-HW-D (1200). After: 44x20 transfer duct relocated; (2) 12x12 grilles relocated to 5P / 7P Meeting; 12ø branch rerouted. Work: Disconnect and remove affected duct, fittings and grilles. Install 44x20 transfer duct and 12ø branch at new locations.	16 MH \$2,000	-	24 MH \$3,000	\$5,000
	Shop drawings for revised design				\$1,000
	30th floor total (22 MH disconnect, 80 MH install)	\$2,750	\$4,350	\$10,000	\$18,100

Key plan - Bulletin 3

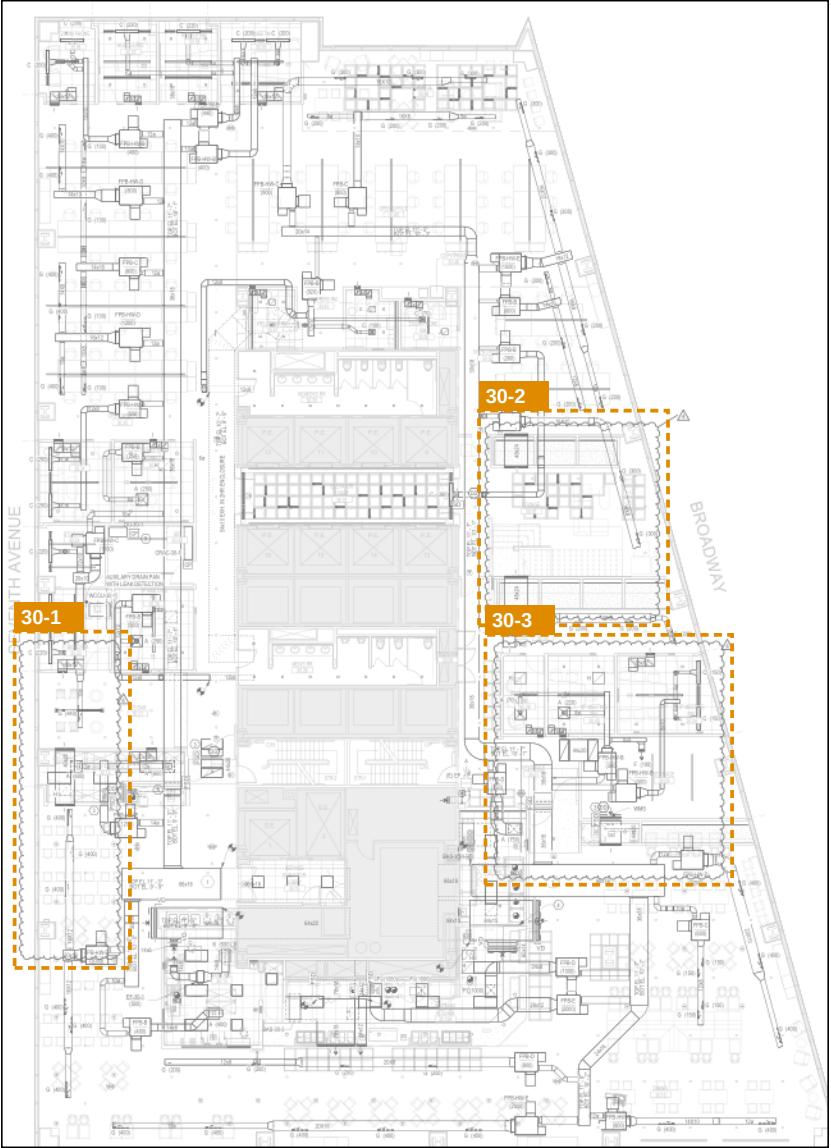

COP-SF-05 summary


Floor	Total
29th floor (M-529.00)	\$29,600
30th floor (M-530.00)	\$18,100
31st floor (M-531.00)	\$19,080
COP-SF-05 total	\$66,780

Bulletin 3 was issued after the ductwork in these areas had been fabricated and installed per Addendum 1, so each area includes disconnecting and removing the installed work. Quantities are approximate, taken from the drawings at 1/8" = 1'-0".


31st Floor - M-531.00: Change Areas, Before and After

Before = Addendum 1 (fabricated and installed) After = Bulletin 3 (rev 4, 08/10/2026) | 31st floor total \$19,080 - scope and costs on next page


31-1 Zoom rooms, northwest - transfer ducts \$1,205

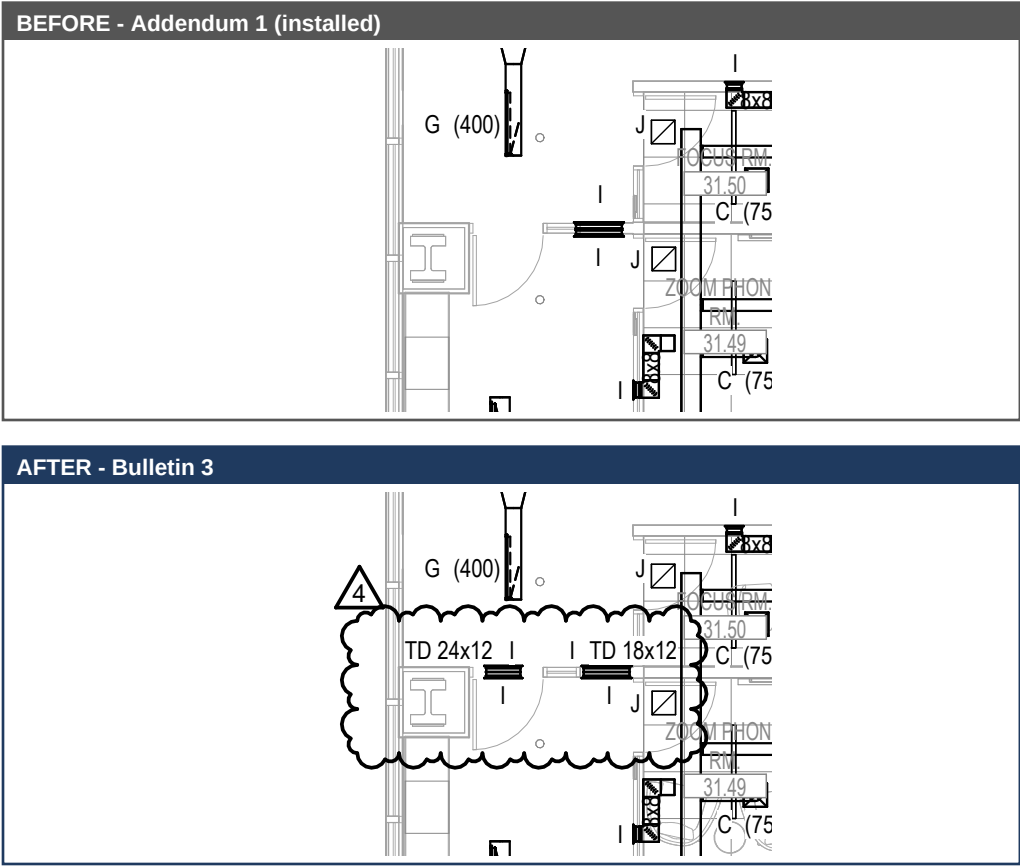


31-2 Transfer duct TD 32x16, north \$1,050

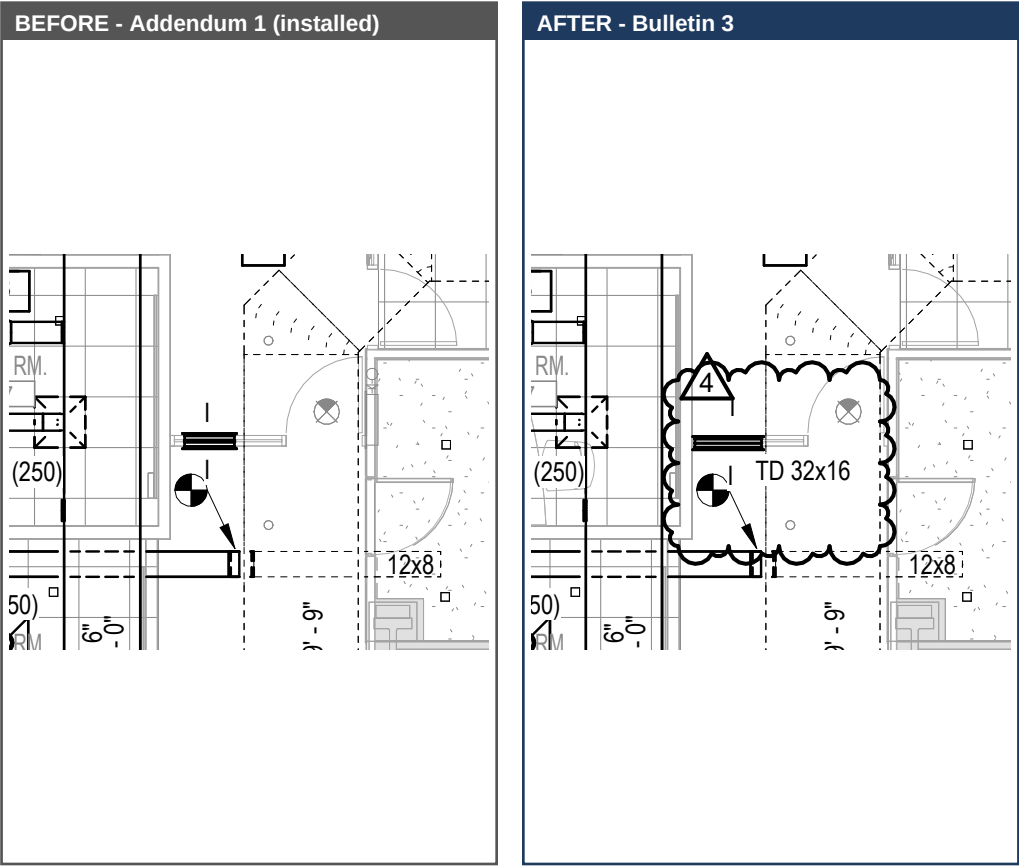


31-3 Storage 31.02 - new transfer ducts \$4,200

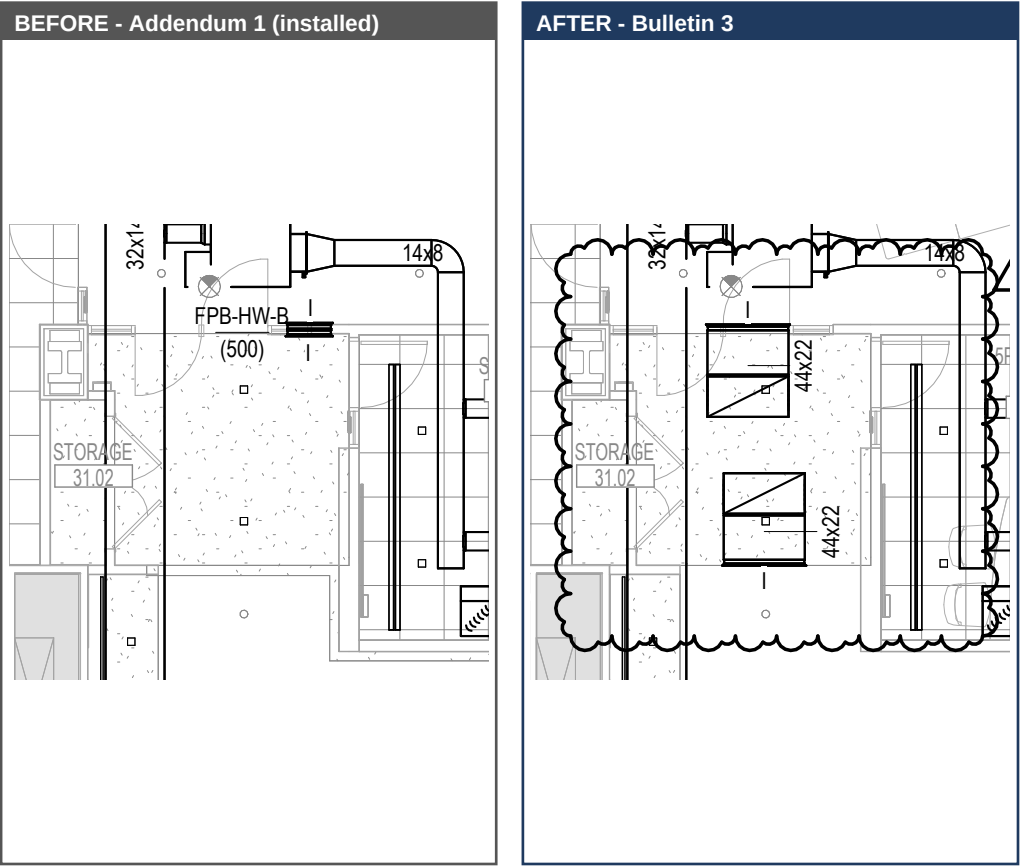


31-4 Coffee Bar 31.12 - transfer ducts and main fitting \$5,450

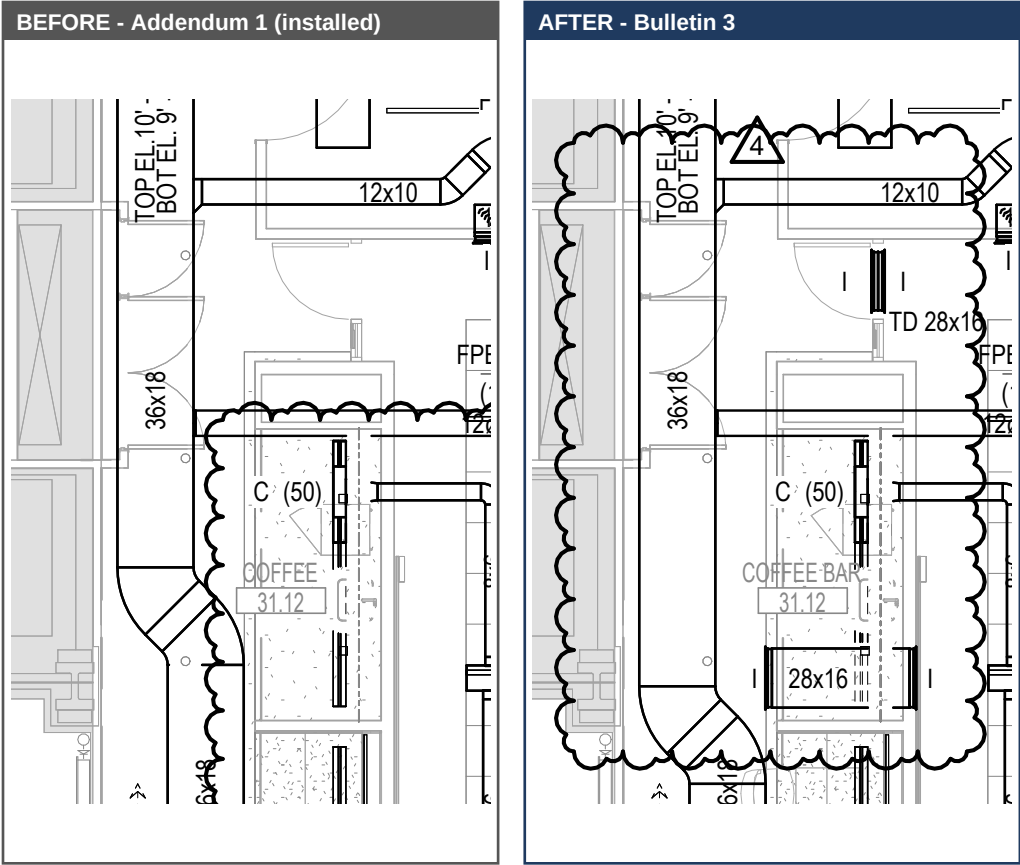

31-5 Transfer duct TD 32x16, southwest \$3,150

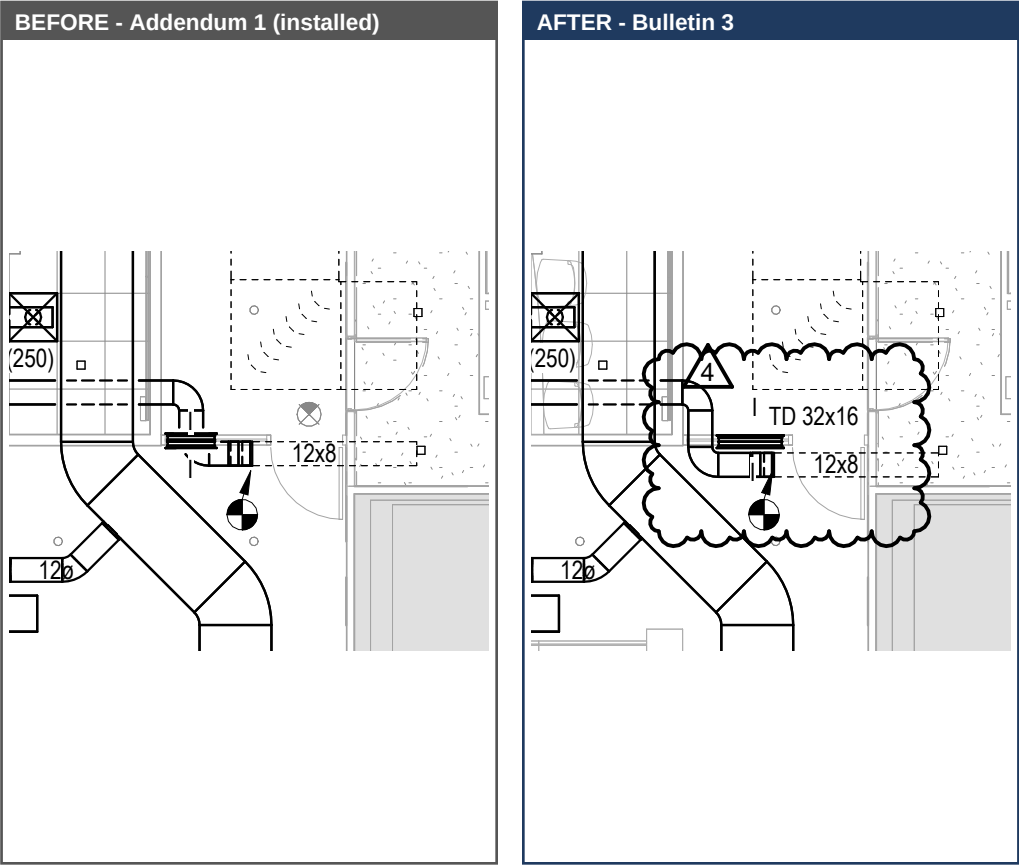

31-6 Storage 31.15 / Room 31.16, southeast \$3,025

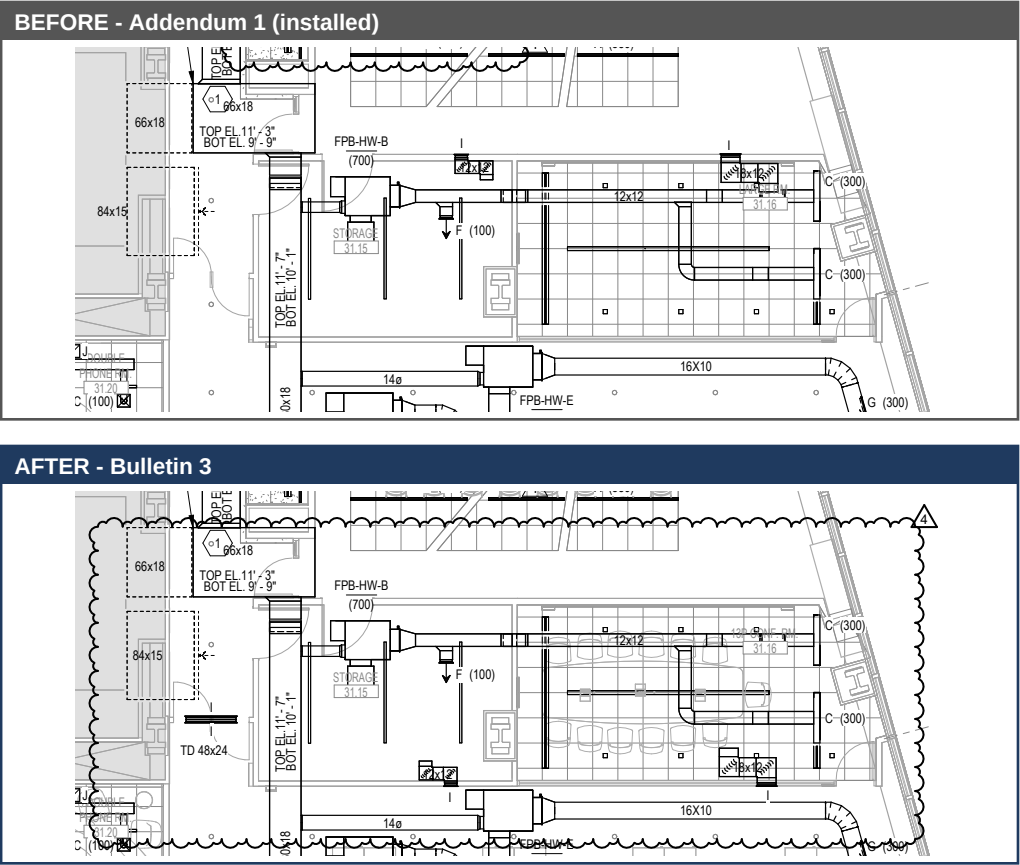


31st Floor - M-531.00: Scope of Work and Cost Breakdown

Labor at \$125.00 per man-hour | Disconnect = removal of installed Addendum 1 work incl. haul away | Material = fabricated ductwork, fittings, insulation, accessories and air outlets | Snowflake Fitout - 7 Times Square, Floors 29-31 | COP-SF-05 Bulletin 3 Revision

Area	Scope of work	Disconnect / removal	Material	Install labor	Total
31-1	Zoom rooms, northwest - transfer ducts Before: (1) transfer duct (not sized on Addendum 1). After: TD 24x12 and new TD 18x12. Work: Remove existing transfer duct; fabricate and install TD 24x12 and TD 18x12.	1 MH \$125	\$330	6 MH \$750	\$1,205
31-2	Transfer duct TD 32x16, north Before: Transfer duct as installed per Addendum 1 (not sized on Addendum 1). After: Transfer duct revised to TD 32x16. Work: Remove installed transfer duct; fabricate and install TD 32x16.	1 MH \$125	\$300	5 MH \$625	\$1,050
31-3	Storage 31.02 - new transfer ducts Before: No transfer ducts; volume damper at FPB-HW-B (500) branch. After: (2) new 44x22 transfer ducts. Work: Fabricate and install (2) 44x22 lined transfer ducts.	-	\$1,700	20 MH \$2,500	\$4,200
31-4	Coffee Bar 31.12 - transfer ducts and main fitting Before: 36x18 main with elbow at Coffee Bar 31.12; no transfer ducts. After: (2) new TD 28x16; 36x18 main elbow reconfigured. Work: Disconnect and remove 36x18 elbow; fabricate and install new fitting and (2) TD 28x16.	6 MH \$750	\$1,700	24 MH \$3,000	\$5,450
31-5	Transfer duct TD 32x16, southwest Before: Transfer duct and duct elbow as installed per Addendum 1, next to the 12x8 branch. After: Transfer duct revised to TD 32x16; elbow deleted. Work: Remove installed transfer duct and elbow; fabricate and install TD 32x16.	4 MH \$500	\$650	16 MH \$2,000	\$3,150
31-6	Storage 31.15 / Room 31.16, southeast Before: 12x12 and 18x12 grilles at previous locations; no transfer duct at Storage 31.15. After: New TD 48x24; 12x12 and 18x12 grilles relocated. Work: Remove grilles and their duct connections; fabricate and install TD 48x24, relocate 12x12 and 18x12 grilles with duct connections at new locations.	5 MH \$625	\$900	12 MH \$1,500	\$3,025
	Shop drawings for revised design				\$1,000
	31st floor total (17 MH disconnect, 83 MH install)	\$2,125	\$5,580	\$10,375	\$19,080

Key plan - Bulletin 3

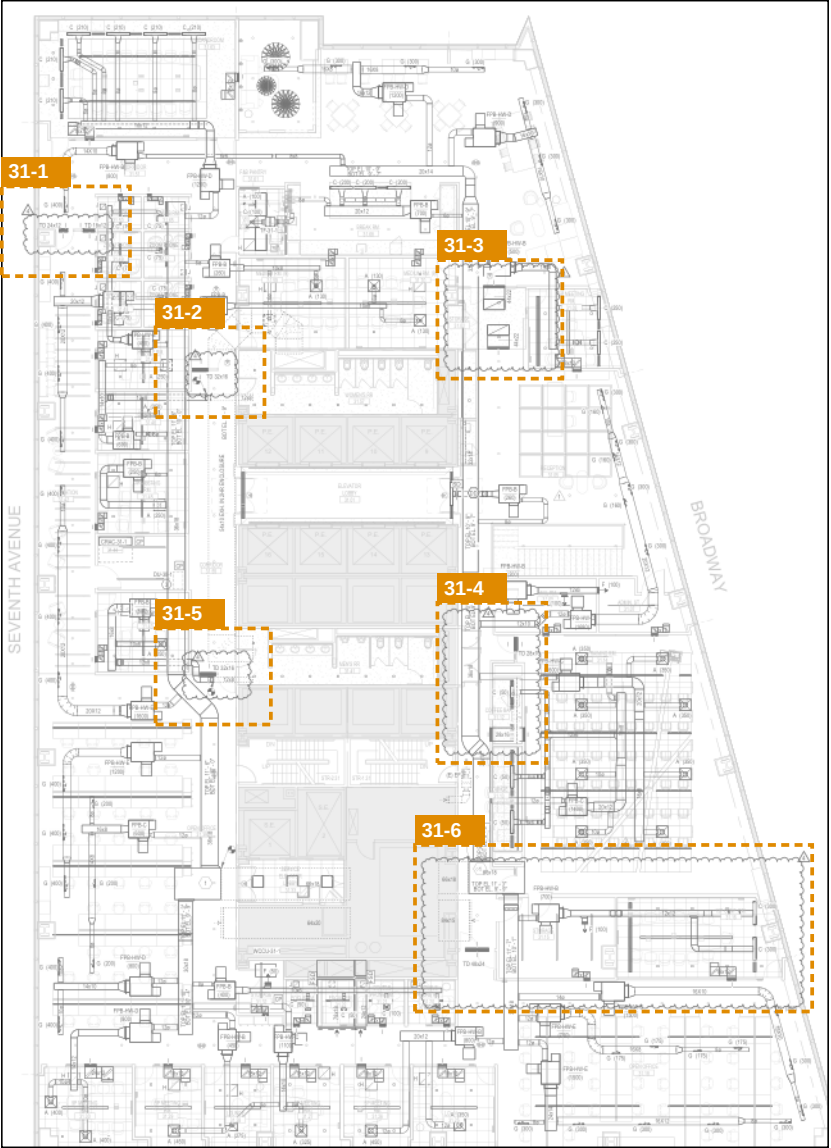

COP-SF-05 summary

Floor	Total
29th floor (M-529.00)	\$29,600
30th floor (M-530.00)	\$18,100
31st floor (M-531.00)	\$19,080
COP-SF-05 total	\$66,780

Bulletin 3 was issued after the ductwork in these areas had been fabricated and installed per Addendum 1, so each area includes disconnecting and removing the installed work. Quantities are approximate, taken from the drawings at 1/8" = 1'-0".