
Fuel Oil Fill / Vent - Contract Drawings vs. Now (RFI#26)

	Contract drawings (IFB 1/8/2026)	Now (RFI#26, ACE response 8/25/2026)
Location	Vesey St facade, 1st floor, east end of the hallway at the exterior door, "INSTALL ABOVE SPRINKLER CONNECTION" (FS102). Driveway to 10 Barclay St is hatched "NOT IN SCOPE OF WORK".	Option 2: fuel oil box on the side wall inside the garage (driveway to 10 Barclay St). ACE: "CONFIRM OPTION 2".
Fill terminal	"2" WALL MOUNTED FUEL PORT" on the facade (FS300). No fill box or spill bucket detail.	Fill box on the garage wall, "approx. location 2 feet away vertically from garage door and 2 feet horizontal", "confirm 2 feet away from building door".
Vent	4" FOV terminates on the facade, min. 2'-0" above the fill port, with the overfill alarm (FS300, MC 1305.7.2).	"We need to stick out of the building" / "2 feet above garage door opening": the 4" vent runs up the outside wall and terminates 2 ft above the garage door opening, 2 ft from building openings.
Routing	From the tank room up through the sub-cellar and cellar (own 2-hr enclosure, FS101) to the facade. Shop drawing Rev.03 (10/13): FOF 93'-7", FOV 95'-2" - still to this location.	Not drawn yet. Fill and vent were excluded from the 19.2 approval (10/20) and must be resubmitted at the new location.
Who asked	-	NWAC's RFI#02 (8/20/2026), logged by KBD as RFI#26, asked for Option 1 (sidewalk above the cellar vault) or Option 2 (garage wall). The reason is not stated in the RFI.

What changes for us (to price once the new route is drawn)


1. Fill box: the contract shows a plain wall-mounted fuel port; the garage location uses a fill box with spill containment (Core RFB-5RMSS4-2, about $1,800, no PO yet). 2. Vent: new exterior run up the garage / building wall to 2 ft above the garage door, with wall penetration, supports and vent head. 3. Fill and vent pipe length and fittings: new route from the cellar to the garage wall vs. FOF 93'-7" / FOV 95'-2" to the facade. 4. Redrawing and resubmittal of the fill / vent shop drawing. Note for a change order: the relocation was requested by NWAC, so the basis has to be why the contract location could not be built (field condition), not an engineer-directed change.

1. Contract drawings - FS102 1st floor (fill / vent at the Vesey St facade)

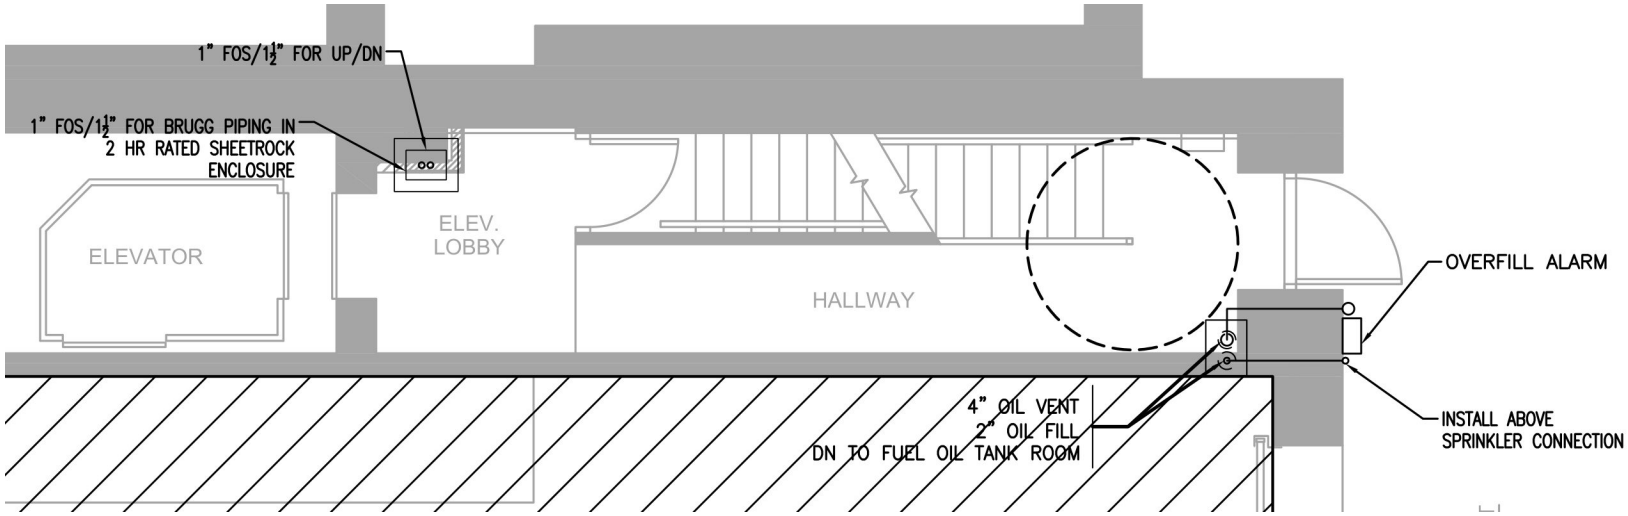


FS102, IFB 1/8/2026: "4" OIL VENT / 2" OIL FILL DN TO FUEL OIL TANK ROOM", "OVERFILL ALARM", "INSTALL ABOVE SPRINKLER CONNECTION".

2. Contract drawings - FS300 facade detail

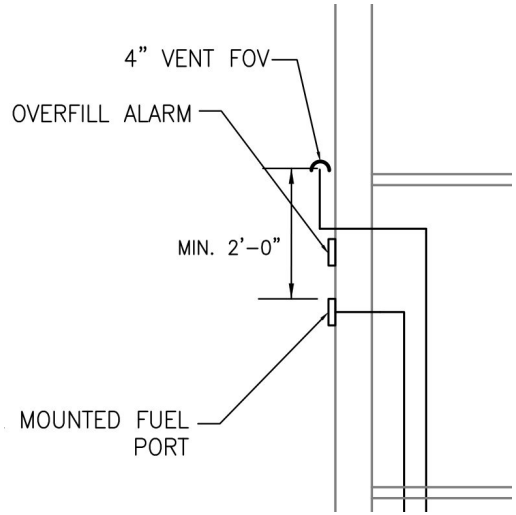

FS300: "4" VENT FOV" min. 2'-0" above the "2" WALL MOUNTED FUEL PORT", overfill alarm between.

3. Now - RFI#26 (NWAC RFI#02), 1st floor plan with options and ACE response

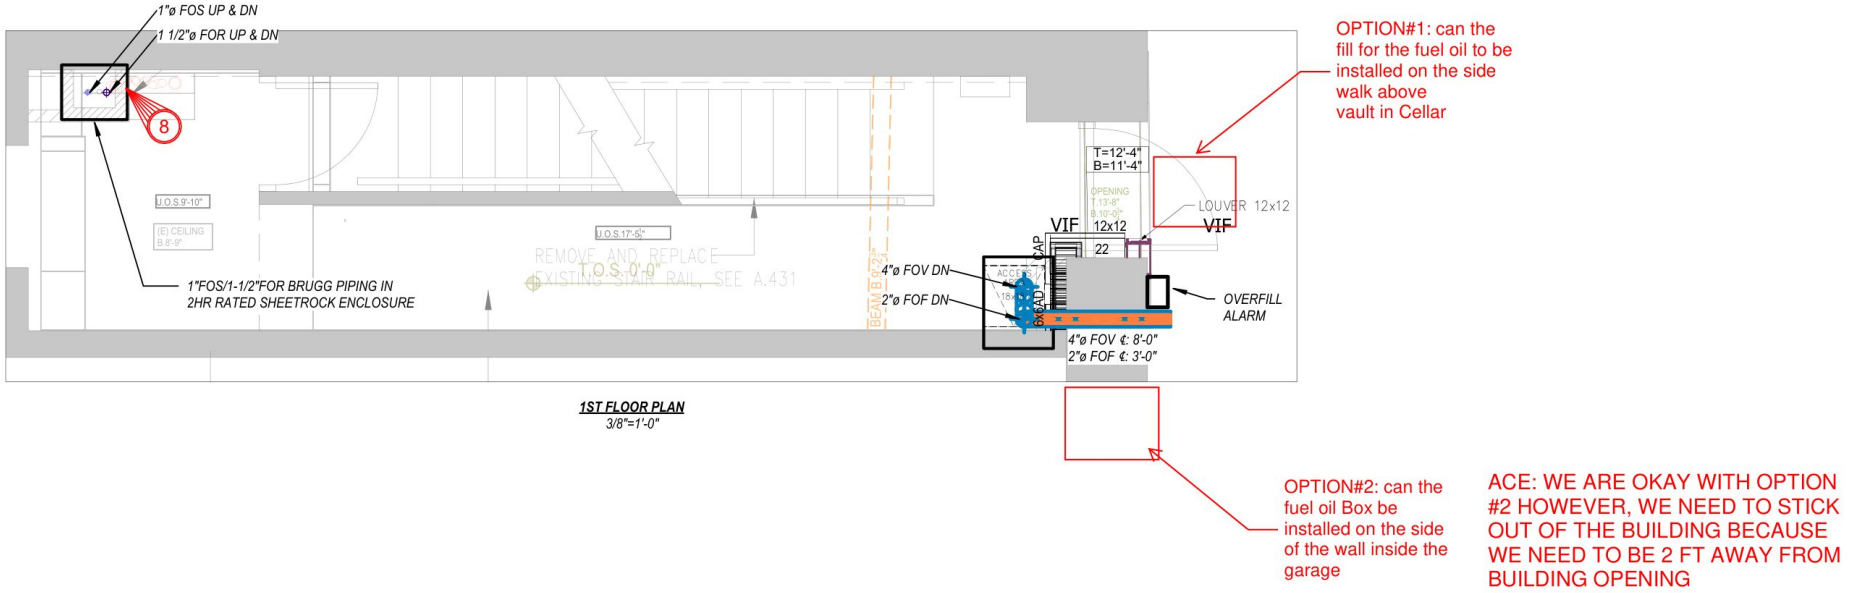

Shop drawing FO-SC 1st floor with Option 1 (sidewalk above the cellar vault) and Option 2 (box on the garage side wall). ACE: "We are okay with option #2 however, we need to stick out of the building because we need to be 2 ft away from building opening."

4. Now - RFI form with ACE answer, and ACE photo markup of the garage entrance (RFI#26)

NORTHERN WOLVES
AIR CONDITIONING

Request for Information

PROJECT: SEAFARERS 18 VESEY ST	**CM: KBD GROUP**
ENGINEER: ACE	**ARCHITECT: ARACARI & IOVINO**
NORTHERN WOLVES RFI#: 02	**DATE: 08-20-2026**
SUBJECT: ALTERNATE FUEL OIL LOCATION	**DRAWING NO: FO-SC**

Description:

Per drawing FO-SC, the fuel oil fill piping (1" FOS / 1-1/2" FOR) is currently routed to the fill location shown on the referenced drawing. Northern Wolves is requesting confirmation on two alternate fill locations for review:


Option 1: Install the fuel oil fill on the sidewalk directly above the vault in the cellar (see marked location, attached 1st Floor Plan).

Option 2: Install the fuel oil box on the interior wall inside the garage, in lieu of the location currently shown (see marked location, attached 1st Floor Plan).

Please advise which option is acceptable, or confirm the fill location shown on the current design intent.

Attachments: Marked-up 1st Floor Plan, site photos of building entrance/garage.

ACE: CONFIRM OPTION 2 HOWEVER, WE NEED TO HAVE THE VENT PIPE 2 FT AWAY FROM BUILDING OPENING. WE NEED TO STICK OUT OF THE BUILDING

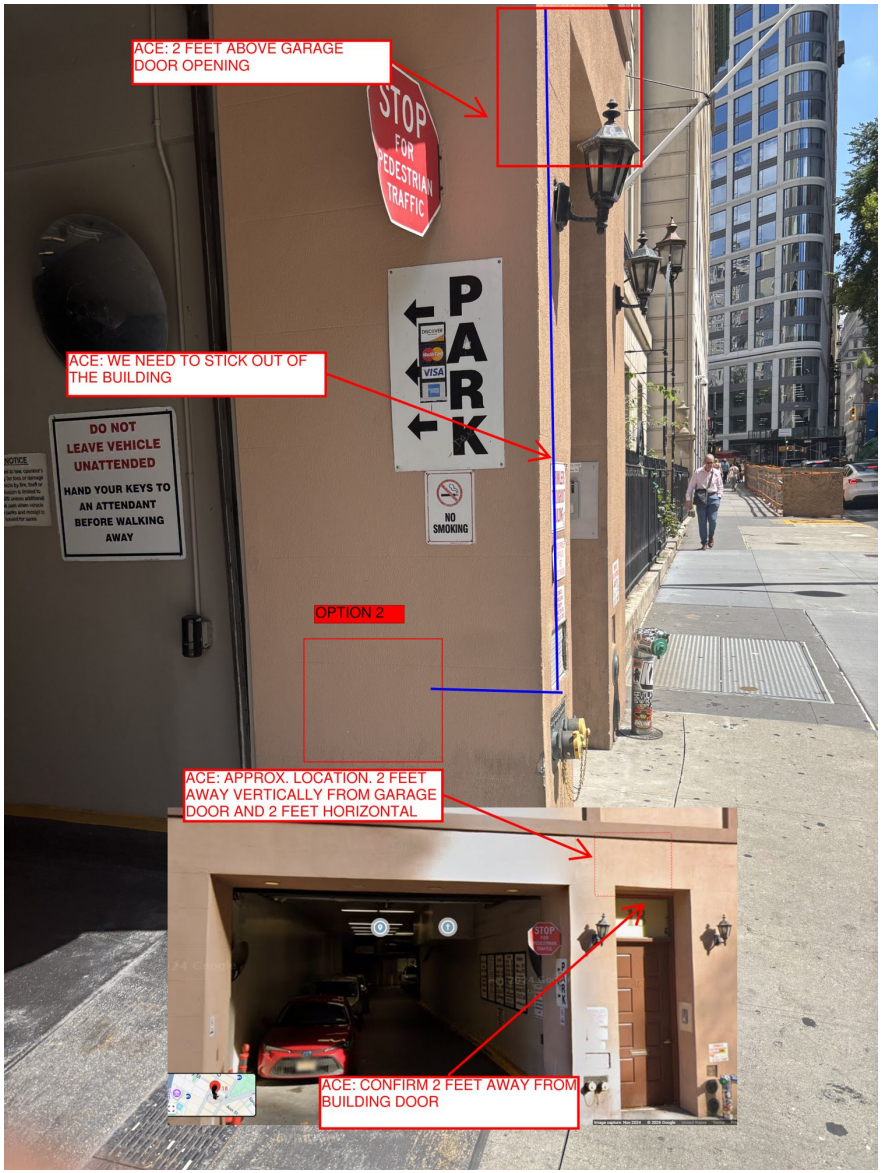

ACE: "Option 2" box on the garage wall; vent "we need to stick out of the building", "2 feet above garage door opening", "approx. location 2 feet away vertically from garage door and 2 feet horizontal", "confirm 2 feet away from building door".