NORTHERN WOLVES
AIR CONDITIONING

Northern Wolves AC
55 9th St, 55-A2
Brooklyn, NY
11215, US
(347) 463-9248

Customer
Callahan Construction Managers

Prepared By:
Alikhan Ilyas
(347) 463-9248
alikhan@northernwolvesac.com

Project: **Sunrise Rye Brook - 900 King St, Rye Brook, NY 10573**

Mechanical drawings dated: 07.15.2026 (GMP set)

Value Engineering - Summary of Changes

1. Heating system - hot water to electric

- Boilers reduced from (3) to (2)
- Boiler pumps and primary pumps deleted
- (20) hot water fan coil units deleted and replaced with (9) electric unit heaters
- Hot water cabinet heaters replaced with (10) electric cabinet heaters
- Hot water heating piping reduced accordingly

2. VAV boxes

- Reduced from (47) to (30): (26) with electric reheat and (4) cooling only
- (18) VAV boxes eliminated in open areas and circulation spaces; these areas will be served directly by the RTUs, with manual volume dampers balanced to design airflow

3. Controls

- For now, we have removed the BMS by ABM and priced standalone controls (factory-mounted controllers with wall thermostats / sensors).
- As an alternative, we can provide BMS for the essential systems only, with the remaining equipment on standalone controls.
- We are currently working on a revised BMS scope and will get back to you shortly.

4. Townhouses

- HVAC system consolidated from two split systems per townhouse to a single system per townhouse.
- Each system: 5-ton cooling condensing unit with cased coil and 2-stage 120 MBH gas furnace.
- Revised price: $1,750,000 (previously $2,600,000).

Equipment removed

Equipment	Tags	Qty	Drawings
Boiler	B-3 (B-1, B-2 remain)	1	M5000, M2002, M6001
Boiler pumps	BP-1, BP-2	2	M5000, M2002, M6001
Primary pumps	PP-1, PP-2	2	M5000, M2002, M6001
Hot water fan coil units	FCU-A (M5000 FCU-1 to FCU-17)	20	M6000, M5000, M2000, M2002
Hot water cabinet heaters	CH-1, CH-3 to CH-12	11	M6001, M2010, M2011
VAV boxes	VAV-5, VAV-6, VAV-12, VAV-13, VAV-18, VAV-19, VAV-24, VAV-23, VAV-25, VAV-27, VAV-28, VAV-29, VAV-33, VAV-34, VAV-35, VAV-36, VAV-37, VAV-40	18	M2010, M2011, M2013, M6000
Hot water reheat coils at VAV boxes	all VAV boxes	47	M6000, M5000
Hot water piping to VAV boxes, cabinet heaters and fan coils	-	lot	M2014, M2015, M2016, M5000
BMS (ABM)	-	lot	-

Equipment replaced / added

VAV boxes with electric reheat and standalone controller with wall thermostat (26)

VAV	Room / area served	Electric reheat
VAV-1	Movement Studio 1045	8 kW
VAV-2	Fitness 1044	13 kW
VAV-3	Multi-Purpose Room 1043	11 kW
VAV-4	Theater 1042	4 kW
VAV-7	Spa / Salon 1041A	2.5 kW
VAV-9	Gen. Manager Office 1035	1.5 kW
VAV-10	Locker rooms / sauna (pool area)	3 kW
VAV-11	Art 1032	5 kW
VAV-15	AVC 1034B	2.5 kW
VAV-16	Sales Office 1034C	3 kW
VAV-17	Family Meeting Room 1002	4.5 kW
VAV-18 (2nd tag)	Treatment Rm 1041C	3 kW
VAV-20	Library 1007	1.5 kW
VAV-21	Store 1008	1.5 kW
VAV-22	Activity Room 1009	2.5 kW
VAV-26	Private Dining 1016	2.5 kW
VAV-30	Private Dining 130 / Dry Storage	2.5 kW
VAV-38	Family Room 120	3.5 kW
VAV-39	Work Room / Sales / Exec. Director	3 kW
VAV-41	Salon 132A	1.5 kW
VAV-42	Theater 135	2.5 kW
VAV-43	Activity 136	4 kW
VAV-44	Fitness 141	5 kW
VAV-45	Fitness / Wellness Office	3.5 kW
VAV-46	Wellness Office	2.5 kW
VAV-47	Exam / AVC Office	3 kW
Total		**100 kW**

VAV boxes cooling only, standalone controller with wall thermostat (4)

VAV	Room / area served
VAV-8	IT Office 1036 / AV Closet
VAV-14	Security 1033 / Package 1003B

VAV	Room / area served
VAV-31	Storage 1031 / Trash 1030 / Receiving
VAV-32	Chef Office 1027

Electric cabinet heaters with integral thermostat (10)

Tag	Location	Electric heat
CH-1	Movement Studio entry	5.3 kW
CH-3	Pool deck / stair entry	5.3 kW
CH-4	Exterior door at gallery	5.3 kW
CH-5	Fitness entry	5.3 kW
CH-12	Multi-Purpose Room entry	5.3 kW
CH-6	Vestibule 1001	5.3 kW
CH-7	Formal Dining entry	5.3 kW
CH-9	Trash 1030 / Storage	10.4 kW
CH-10	Casual Dining entry	5.3 kW
CH-11	Casual Dining entry	5.3 kW
Total		**58.1 kW**

Electric unit heaters with integral thermostat, in lieu of hot water fan coils (9)

#	Location (basement)	Electric heat
EUH-1	Residents' Storage B107	3 kW
EUH-2	Trash Collection B106 (exhaust make-up)	5 kW
EUH-3	Kitchen Storage B113	5 kW
EUH-4	Corridor B100	3 kW
EUH-5	Residents' Storage B115	3 kW
EUH-6	Team Member Lounge B119A	3 kW
EUH-7	Mechanical B118	5 kW
EUH-8	Trash room, AL south (400 CFM exhaust make-up)	5 kW
EUH-9	Storage room, AL south	3 kW
Total		**35 kW**

Electric heat added: about 193.1 kW connected (VAV reheat 100 kW, cabinet heaters 58.1 kW, unit heaters 35 kW), 208 V. Electrical work by EC. Marked-up drawings follow: M5000, M6001, M6000, M2010, M2011, M2013, M2000, M2002, M2014, M2015, M2016.

NORTHERN WOLVES AC - VALUE ENGINEERING MARK-UP Rev 0 10/27/2026

Sheet M5000 (GMP set 07.15.2026). For discussion - not a design document.

DELETE - BOILERS 3 TO 2 (1): Boilers reduced from three to two; B-3 deleted, B-1 and B-2 remain.

DELETE PUMP (4): Boiler pumps BP-1 / BP-2 and primary pumps PP-1 / PP-2 deleted.

ELECTRIC - HW PIPING DELETED (3): Unit changed to electric heat; hot water piping to this unit deleted.

DELETE FCU (1): Hot water FCU deleted; replaced by electric unit heaters (9) as marked on M2000 / M2002.

ROOF

4TH FLOOR

3RD FLOOR

2ND FLOOR

1ST FLOOR

CELLAR LEVEL

IL VAV BOXES: HW REHEAT DELETED - ELECTRIC REHEAT / CANCELLED PER M2010-M2011

VAV VAV VAV

NORTHERN WOLVES AC - VALUE ENGINEERING MARK-UP Rev 0 10/27/2026

Sheet M6001 (GMP set 07.15.2026). For discussion - not a design document.

DELETE - BOILERS 3 TO 2 (1): Boilers reduced from three to two; B-3 deleted, B-1 and B-2 remain.

DELETE PUMP (4): Boiler pumps BP-1 / BP-2 and primary pumps PP-1 / PP-2 deleted.

ELECTRIC CABINET HEATER (11): Replace hot water cabinet heater with electric cabinet heater with integral thermostat, same location. Delete hot water piping. Power by EC.

...TING)

...IN FABRICATED FILTER ANGLES. FILTER ANGLES PROVIDED BY M.C..

3.UNIT SHALL BE PROVIDED WITH CONDENSATE PUMP.
4.INDOOR UNIT CFM SELECTED AT HIGH CFM. INDOOR UNIT SHALL HAVE CAPABILITY TO ADJUST CFM FOR FINAL AIR BALANCING UP OR DOWN THROUGH FIELD ADJUSTMENT.
5.DUCTED CONCEALED UNITS SHALL BE PROVIDED WITH SUPPLY AND RETURN DUCT FLANGES.
6.UNIT SHALL BE PROVIDED WITH INTEGRAL LIFT/PUMP FOR CONDENSATE REMOVAL. IF NOT PROVIDED INTEGRAL WITH UNIT, CONTRACTOR SHALL PROVIDE SEPARATE CONDENSATE PUMP. CONDENSATE PUMP SHALL BE POWERED BY UNIT. IF NOT, MECHANCIAL CONTRACTOR IS RESPONSIBLE TO PROVIDE POWER FOR CONDENSATE PUMP.

TAG NAME	SERVICE	ASSOC. OUTDOOR UNIT	CFM DESIGN	EXT S.P. IN. WC	REFRIGERATION TYPE	REFRIGERATION CHARGE LBS	COOLING TOTAL MBH	HEATING TOTAL MBH	COND. PUMP REQ'D	ELECTRICAL VOLTS	ELECTRICAL PH	ELECTRICAL MCA	ELECTRICAL MOCP	ELECTRICAL DISCONNECT BY [A]	ELECTRICAL DISCONNECT TYPE [B]	ELECTRICAL CNTLR/STARTER BY [A]	ELECTRICAL CNTLR/STARTER SCCR	ELECTRICAL CNTLR/STARTER EM PWR	MAXIMUM DIMENSIONS HEIGHT	MAXIMUM DIMENSIONS WIDTH	MAXIMUM DIMENSIONS DEPTH	WEIGHT LBS OPERATING	MANUFACTURER	MODEL	NOTES
AC-1	<varies>	<varies>	<varies>	<varies>	<varies>	<varies>	<varies>	<varies>	<varies>	208	<varies>	<varies>	<varies>	<varies>	<varies>	MFR	<varies>	<varies>	<varies>	<varies>	<varies>	<varies>	<varies>	<varies>	<varies>
AC-2	<varies>	<varies>	<varies>	<varies>	<varies>	<varies>	<varies>	<varies>	<varies>	208	<varies>	<varies>	<varies>	<varies>	<varies>	MFR	<varies>	<varies>	<varies>	<varies>	<varies>	<varies>	<varies>	<varies>	<varies>
AC-3	SEE DWGS.	HP-3	1,090	0.8	R-32	7.5	30	34	Yes	208	1	3	15	EC	F	MFR	10,000	Yes	10"	4'-8"	2'-8"	101	Daikin	FBA30AAVJU	
AC-4	SEE DWGS.	HP-4	1,130	0.8	R-32	7.5	36	40	Yes	208	1	3.1	15	EC	F	MFR	10,000	Yes	10"	4'-8"	2'-8"	101	Daikin	FBA36AAVJU	
AC-5	SEE DWGS.	HP-5	1,370	0.8	R-32	7.5	40.5	47	Yes	208	1	3.6	15	EC	F	MFR	10,000	Yes	10"	4'-8"	2'-8"	106	Daikin	FBA42AAVJU	

MINI-SPLIT SYSTEM - OUTDOOR UNIT (HEAT PUMP)

NOTES:
1.UNITS SHALL BE SELECTED FOR DESIGN COOLING LOAD.
2.COORDINATE ELECTRICAL CONNECTIONS WITH MANUFACTURER UNIT IS SUPPLIED AS MULTIPLE MODULES. EACH MODULE REQUIRES A SEPARATE ELECTRICAL CONNECTION AND DISCONNECT.
3.DESIGN COOLING CAPACITY SHALL BE RATED AT: INDOOR TEMP = 74°FDB/61.7°FWB, OUTDOOR TEMP = 95°FDB. EFFECTS OF ESTIMATED REFRIGERANT LINE LENGTH SHALL BE INCLUDED IN COMPUTING DESIGN CAPACITY.
4.DESIGN HEATING CAPACITY SHALL BE RATED AT: INDOOR TEMP = 70°FDB, OUTDOOR TEMP = 14°FDB. EFFECTS OF ESTIMATED REFRIGERANT LINE LENGTHS AND DEFROSTING SHALL BE INCLUDED IN COMPUTING DESIGN CAPACITY.

TAG NAME	AMBIENT TEMP °F COOLING RANGE	AMBIENT TEMP °F HEATING RANGE	SERVICE	NO. OF INDOOR UNITS	REFRIGERATION TYPE	REFRIGERATION CHARGE LBS	COOLING MBH (NOTE 3)	HEATING MBH (NOTE 4)	ELECTRICAL (SAME EACH MODULE) VOLTS	PH	DISCONNECT BY [A]	DISCONNECT TYPE [B]	CNTLR/STARTER BY [A]	EM PWR	ELECTRICAL MODULE 1 MCA	MOCP	MAXIMUM DIMENSIONS SCCR	WIDTH	HEIGHT	DEPTH	WEIGHT LBS OPERATING	MANUFACTURER	MODEL	NOTES
HP-1	95	47	INDEPENDENT LIVING UNITS	1	R-32	7.5	18	20	208	1	MFR	F	MFR	Yes	19.8	20	10,000	3'-7 5/16"	2'-10 1/4"	1'-6 1/8"	234	Daikin	RZA18AAVJU	
HP-2	95	47	INDEPENDENT LIVING UNITS	1	R-32	7.5	24	27	208	1	MFR	F	MFR	Yes	19.8	20	10,000	3'-7 5/16"	2'-10 1/4"	1'-6 1/8"	234	Daikin	RZA24AAVJU	
HP-3	95	47	INDEPENDENT LIVING UNITS	1	R-32	7.5	36	40	208	1	MFR	F	MFR	Yes	34.6	35	10,000	3'-7 5/16"	2'-10 1/4"	1'-6 1/8"	234	Daikin	RZA30AAVJU	
HP-4	95	47	INDEPENDENT LIVING UNITS	1	R-32	7.5	36	40	208	1	MFR	F	MFR	Yes	34.6	35	10,000	3'-7 5/16"	2'-10 1/4"	1'-6 1/8"	234	Daikin	RZA36AAVJU	
HP-5	95	47	INDEPENDENT LIVING UNITS	1	R-32	7.5	48	54	208	1	MFR	F	MFR	Yes	34.6	35	10,000	3'-7 5/16"	2'-10 1/4"	1'-6 1/8"	234	Daikin	RZA48AAVJU	

HEAT EXCHANGER SCHEDULE

NOTES:
1.

TAG NAME	LOCATION	BTUH	SERVICE	HOT SIDE FLUID TYPE	HOT SIDE GPM DESIGN	HOT SIDE W.P.D. FT. HD.	HOT SIDE EWT °F	HOT SIDE LWT °F	COLD SIDE GPM DESIGN	COLD SIDE W.P.D. FT. HD.	COLD SIDE EWT °F	COLD SIDE LWT °F	COLD SIDE APPROAC H TEMP °F	PLATES QTY	PLATES WIDTH	PLATES HEIGHT	CURB / PAD TYPE / BY [G]	CURB / PAD HEIGHT	MAXIMUM DIMENSIONS WIDTH	MAXIMUM DIMENSIONS HEIGHT	MAXIMUM DIMENSIONS DEPTH	WEIGHT LBS DRY	WEIGHT LBS OPERATING	MANUFACTURER	MODEL
HX-1	AL BASEMENT	500,000	POOL		0	0	103	83	0	0	0	0	2	0	0' - 0"	0"			0"	0"	0"	0	0		
HX-2	AL BASEMENT	245,000	SPA		0	0	124	104	0	0	0	0	2	0	0' - 0"	0"			0"	0"	0"	0	0		
HX-3	AL BASEMENT	826,000	RAMP RADIANT	30% PROP. GLY.	0	0	120	90	0	0	0	0	2	0	0' - 0"	0"			0"	0"	0"	0	0		

AIR TERMINAL SCHEDULE (EG, RG, SD, etc.)

NOTES:
1.REFER TO DRAWINGS FOR NECK SIZE. ALL BRANCH DUCTWORK TO AIR TERMINALS SHALL BE NECK SIZE UNLESS NOTED OTHERWISE.
2.REFER TO DRAWINGS FOR FACE SIZES NOTED AS <varies>.
3.CONTRACTOR SHALL DETERMINE PROPER BORDER TYPE TO MATCH CEILING CONSTRUCTION.
4.DIFFUSERS WITH MULTIPLE SLOTS SHALL HAVE THE INNER MOST SLOT DIRECTED TOWARDS THE INTERIOR OF THE BUILDING, THE REMAINING SHALL BE DIRECTED TOWARDS THE EXTERIOR UNLESS NOTED OTHERWISE.

TAG NAME	TYPE	MATERIAL	FINISH	FACE SIZE (NOTE 1,2) WIDTH	FACE SIZE (NOTE 1,2) HEIGHT	BORDER (NOTE 3)	LINEAR SLOTS SLOTS (NOTE 4) WIDTH	LINEAR SLOTS SLOTS (NOTE 4) QTY	LINEAR SLOTS PLENUM YES / NO	LINEAR SLOTS PLENUM INSUL	LINEAR SLOTS PATTERN CNTLR	VOLUME DAMPER	WEIGHT LBS DRY	WEIGHT LBS OPERATING	MANUFACTURER	MODEL	NOTES
AP-#	BLANK ACCESS PANEL	[ALUMINUM][STAINLESS STEEL]	WHITE	2'-0"	2'-0"	LAY-IN	0"	0				No	0	0			
EG-2	PERFORATED FACE	STEEL	WHITE	<varies>	<varies>	LAY-IN						No	0	0	TITUS	PAR	
EG-4	35 DEGREE DEFLECTION	[ALUMINUM] [STEEL]	WHITE	8"	6"	SURFACE MOUNT						No	0	0	TITUS	350	LONG BLADES
EG-5	35 DEGREE DEFLECTION	[ALUMINUM] [STEEL]	WHITE	8"	6"	SURFACE MOUNT						No	0	0	TITUS	350	LONG BLADES
LD-1		ALUMINUM	WHITE	<varies>			<varies>	0				Yes	0	0	TITUS	FL	
LD-#		ALUMINUM	WHITE	4 3/4"			2"	0				Yes	0	0	TITUS	FL	
R?-#	[USER DEFINED]	[ALUMINUM] [STEEL]	[USER DEFINED]	8"	<varies>	[USER DEFINED]						No	0	0	TITUS	[USER DEFINED]	[USER DEFINED]
RD-1		ALUMINUM	WHITE	2 3/4"			1"	0				Yes	0	0	TITUS	FL	
RG-1	35 DEGREE DEFLECTION	[ALUMINUM] [STEEL]	WHITE	<varies>	<varies>	SURFACE MOUNT						No	0	0	TITUS	350	LONG BLADES
RG-2	<varies>	<varies>	WHITE	<varies>	<varies>	SURFACE MOUNT						No	0	0	TITUS	<varies>	<varies>
RG-4	PERFORATED FACE	STEEL	WHITE	1'-0"	1'-0"	LAY-IN						No	0	0	TITUS	PAR	DUCTED RETURN
RG-#	PERFORATED FACE	STEEL	WHITE	2'-0"	2'-0"	LAY-IN						No	0	0	TITUS	PAR	DUCTED RETURN
SD-1				<varies>	<varies>							No	0	0			
SD-2				2'-0"	2'-0"							No	0	0			
SD-3				1'-0"	1'-0"							No	0	0			
SD-#				2'-0"	2'-0"							No	0	0			
SG-1	SINGLE DEFLECTION	[ALUMINUM] [STEEL]	WHITE	<varies>	<varies>	SURFACE MOUNT						Yes	0	0	HART AND COOLEY	821	LONG BLADES
SG-2	SINGLE DEFLECTION	[ALUMINUM] [STEEL]	WHITE	<varies>	6"	SURFACE MOUNT						No	0	0			LONG BLADES
SG-3	SINGLE DEFLECTION	[ALUMINUM] [STEEL]	WHITE	8"	6"	SURFACE MOUNT						No	0	0	TITUS	301	SHORT BLADES
SG-#	SINGLE DEFLECTION	[ALUMINUM] [STEEL]	WHITE	6"	4"	SURFACE MOUNT						Yes	0	0	TITUS	301	SHORT BLADES

DEHUMIDIFICATION UNIT SCHEDULE

NOTES:
1.

TAG NAME	LOCATION	SUPPLY SUPPLY CFM	SUPPLY SUPPLY ESP	OUTSIDE AIR OA CFM	OUTSIDE AIR OA ESP	EVAPORATOR COIL SENSIBLE CAPACITY MBH	EVAPORATOR COIL TOTAL CAPACITY MBH	EVAPORATOR COIL MOISTURE REMOVAL CAPACITY (LBS/H)	REHEAT COIL HEAT REJECTION (MBH)	ELECTRICAL VOLTS	ELECTRICAL PH	ELECTRICAL FLA	ELECTRICAL MCA	DIMENSIONS WIDTH	DIMENSIONS HEIGHT	DIMENSIONS DEPTH	WEIGHT LBS OPERATING	MANUFACTURER	MODEL
DH-1 FLOOR MOUNTED	CELLAR	3400	2"	960	0.5"	50.7	84.5	31.3	105.6	208	3	37.4	44	3'-8"	5'-10"	5'-2"	1,400	SERESCO	6 TON COMP. DEHUMIDIFIER

CABINET HEATER SCHEDULE

NOTES:
1.COORDINATE COLOR SELECTION WITH ARCHITECT.

TAG NAME	LOCATION	SERVICE	DIMENSIONS WIDTH	DIMENSIONS HEIGHT	DIMENSIONS DEPTH	FAN CFM DESIGN	FAN DRIVE	COIL FLUID TYPE	GPM	COIL MBH	ELECTRIC AL VOLTS	ELECTRIC AL PH	MAXIMUM DIMENSIONS WIDTH	MAXIMUM DIMENSIONS HEIGHT	MAXIMUM DIMENSIONS DEPTH	WEIGHT LBS DRY	MANUFACTURER	MODEL	NOTES
CH-1	ELECTRIC CABINET HEATER	BOILER	40"	12"	24"	450	CENTRIFUGAL	HOT WATER	3	18062	120	1	4'-0 3/4"	2'-1"	9 3/4"	105	MODINE	CW00450A	
CH-2	ELECTRIC CABINET HEATER	BOILER	40"	12"	24"	450	CENTRIFUGAL	HOT WATER	3	18062	120	1	4'-0 3/4"	2'-1"	9 3/4"	105	MODINE	CW00450A	
CH-3	ELECTRIC CABINET HEATER	BOILER	40"	12"	24"	450	CENTRIFUGAL	HOT WATER	3	18062	120	1	4'-0 3/4"	2'-1"	9 3/4"	105	MODINE	CW00450A	
CH-4	ELECTRIC CABINET HEATER	BOILER	40"	12"	24"	450	CENTRIFUGAL	HOT WATER	3	18062	120	1	4'-0 3/4"	2'-1"	9 3/4"	105	MODINE	CW00450A	
CH-5	ELECTRIC CABINET HEATER	BOILER	40"	12"	24"	450	CENTRIFUGAL	HOT WATER	3	18062	120	1	4'-0 3/4"	2'-1"	9 3/4"	105	MODINE	CW00450A	
CH-6	ELECTRIC CABINET HEATER	BOILER	40"	12"	24"	450	CENTRIFUGAL	HOT WATER	3	18062	120	1	4'-0 3/4"	2'-1"	9 3/4"	105	MODINE	CW00450A	
CH-7	ELECTRIC CABINET HEATER	BOILER	40"	12"	24"	450	CENTRIFUGAL	HOT WATER	5.8	35552	120	1	5'-11 3/4"	2'-4"	1'-0"	185	MODINE	CW01050A	
CH-8	ELECTRIC CABINET HEATER	BOILER	40"	12"	24"	450	CENTRIFUGAL	HOT WATER	3	18062	120	1	4'-0 3/4"	2'-1"	9 3/4"	105	MODINE	CW00450A	
CH-9	ELECTRIC CABINET HEATER	BOILER	40"	12"	24"	450	CENTRIFUGAL	HOT WATER	3	18062	120	1	4'-0 3/4"	2'-1"	9 3/4"	105	MODINE	CW00450A	
CH-10	ELECTRIC CABINET HEATER	BOILER	40"	12"	24"	450	CENTRIFUGAL	HOT WATER	3	18062	120	1	4'-0 3/4"	2'-1"	9 3/4"	105	MODINE	CW00450A	
CH-11	ELECTRIC CABINET HEATER	BOILER	40"	12"	24"	450	CENTRIFUGAL	HOT WATER	3	18062	120	1	4'-0 3/4"	2'-1"	9 3/4"	105	MODINE	CW00450A	

FAN SCHEDULE (EF, RF, SF, etc.)

NOTES:
1.

TAG NAME	LOCATION	SERVICE	CFM DESIGN	TOTAL S.P. IN. WC	DRIVE	RPM	WHEEL DIAMETER	ELECTRICAL WHEEL MOTOR HP	ELECTRICAL VOLTS	ELECTRICAL PH	DIMENSIONS WIDTH	DIMENSIONS HEIGHT	DIMENSIONS DEPTH	WEIGHT LBS OPERATING	MANUFACTURER	MODEL
DWE-1	IL ROOF	DISHWASHER EXHAUST	0	0	TBD	0	0"	TBD	0	1	0"	0"	0"	0	TBD	TBD
GX-1	CELLAR	CO EXHAUST	10,800	0.5	BELT	630	2'-6"	3	208	3	4'-6"	7'-6"	4'-6"	1,511	COOK	QMX
GX-2	CELLAR	CO EXHAUST	10,800	0.5	BELT	630	2'-6"	3	208	3	4'-6"	7'-6"	4'-6"	1,511	COOK	QMX
GX-3	CELLAR	CO EXHAUST	10,800	0.5	BELT	287	5'-10"	3	208	3	5'-6"	6'-2"	5'-6"	2,537	COOK	QMX
GX-4	CELLAR	POOL STORAGE EXHAUST	0	0	TBD	0	0"	TBD	0	1	0"	0"	0"	0	COOK	ACE-DVF
GX-5	CELLAR	DOG SPA/SALON	0	0	TBD	0	0"	TBD	0	1	0"	0"	0"	0	COOK	ACE-DVF
GX-6	CELLAR	TRASH ROOM EXHAUST	0	0	TBD	0	0"	TBD	0	1	0"	0"	0"	0	COOK	ACE-DVF
GX-7	CELLAR	POOL STORAGE EXHAUST	300	0.32	DIRECT	1800	0"	1/6	115	1	0"	0"	0"	0	GREENHECK	SQ-90
GX-8	CELLAR	SPA	450	0.3	DIRECT	1800	0"	1/4	115	1	0"	0"	0"	0	GREENHECK	SQ-95-VG
KE-1	IL ROOF	KITCHEN HOOD #07 EXHAUST	0	0	TBD	0	0"	TBD	0	1	0"	0"	0"	0	TBD	TBD
KE-2	IL ROOF	KITCHEN HOOD #25 EXHAUST	0	0	TBD	0	0"	TBD	0	1	0"	0"	0"	0	TBD	TBD
POE-1	IL ROOF	PIZZA OVEN EXHAUST	0	0	TBD	0	0"	TBD	0	1	0"	0"	0"	0	TBD	TBD
RF-2	IL ROOF	RTU-2	6,500	1.25	CENTRIFUGAL	1155	2'-3"	3	460	3	3'-6"	4'-5"	3'-0"	553	COOK	CPS
RF-3	IL ROOF	RTU-3	6,840	1.25	CENTRIFUGAL	1394	2'-1"	5	460	3	3'-4"	4'-1"	3'-0"	529	COOK	CPS
RF-4	IL ROOF	RTU-4	2,700	1.25	CENTRIFUGAL	1453	2'-0"	1.5	460	3	2'-8"	3'-3"	2'-6"	346	COOK	CPS
TRE-1	IL ROOF	TRASH ROOM EXHAUST	750	0.35	DIRECT	912	1'-1"	1/4	115	1	1'-7"	3'-0"	1'-7"	59	GREENHECK	G-120-G
TRE-2	IL ROOF	TRASH ROOM EXHAUST	750	0.35	DIRECT	912	1'-1"	1/4	115	1	1'-7"	3'-0"	1'-7"	59	GREENHECK	G-120-G
TX-1	IL ROOF	IL WEST BATHROOM EXHAUST	150	1.5	CENTRIFUGAL	1934	1'-8"	1/2	115	1	1'-8"	2'-4"	1'-8"	72	COOK	ACE-DVF
TX-2	IL ROOF	IL EAST BATHROOM EXHAUST	150	1.5	CENTRIFUGAL	1934	1'-8"	1/2	115	1	1'-8"	2'-4"	1'-8"	72	COOK	ACE-DVF
TX-4	1ST FLOOR	IL GARBAGE BATHROOM EXHAUST	250	1	INLINE	1702	1'-8"	5/8	115	1	1'-8"	2'-4"	1'-8"	76	COOK	ACE-DVF
TX-5	1ST FLOOR	IL DINING ROOM BATHROOM EXHAUST	250	1	INLINE	1725	1'-8"	1/3	115	1	1'-8"	2'-4"	1'-8"	66	COOK	ACE-DVF
TX-6	1ST FLOOR	AL 1ST FLOOR BATHROOM EXHAUST	250	1	INLINE	1725	1'-8"	1/4	115	1	1'-8"	2'-4"	1'-8"	63	COOK	ACE-DVF
TX-7	2ND FLOOR	AL 2ND FLOOR BATHROOM EXHAUST	250	1	INLINE	1725	1'-8"	1/3	115	1	1'-8"	2'-4"	1'-8"	66	COOK	ACE-DVF
TX-8	3RD FLOOR	AL 3RD FLOOR BATHROOM EXHAUST	250	1	INLINE	1725	1'-8"	1/4	115	1	1'-8"	2'-4"	1'-8"	63	COOK	ACE-DVF
TX-9	CELLAR	AL BASEMENT BATHROOM EXHAUST	75	1	TBD	0	0"	TBD	0	1	0"	0"	0"	0	COOK	ACE-DVF
TX-10			450	0.3	DIRECT	1800	0"	1/6	115	1	0"	0"	0"	0	GREENHECK	SQ-95-VG
TX-A	IL / AL	UNIT RESTROOMS	75	0.25	DIRECT	900	0"	0.04	120	1	1'-3 1/2"	1'-1 1/4"	9"	12	COOK	GC-146

BOILER SCHEDULE - HOT WATER (BLR)

NOTES:
1.

TAG NAME	SERVICE	FUEL TYPE	MBH INPUT	MBH OUTPUT	MAXIMUM DIMENSIONS WIDTH	MAXIMUM DIMENSIONS HEIGHT	MAXIMUM DIMENSIONS DEPTH	WEIGHT LBS DRY	MANUFACTURER	MODEL	NOTES
B-1	DELETE - BOILERS 3 TO 2	FIRE TUBE	1999	1900	3'-0"	6'-8"	6'-2"	1,750	LAARS MAGNTHERM FT	2000	
B-2	BUILDING HEATING	FIRE TUBE	1999	1900	3'-0"	6'-8"	6'-2"	1,750	LAARS MAGNTHERM FT	2000	
B-3	BUILDING HEATING	FIRE TUBE	1999	1900	3'-0"	6'-8"	6'-2"	1,750	LAARS MAGNTHERM FT	2000	

PUMP SCHEDULE (P)

NOTES:
1.

TAG NAME	SERVICE	GPM DESIGN	FT. HEAD	WEIGHT LBS OPERATING	MANUFACTURER AND MODEL
BP-1	AL BASEMENT BOILER	381	30	141	ARMSTRONG 4300 0610-005
BP-2	AL BASEMENT BOILER	381	30	141	ARMSTRONG 4300 0610-005
P-1	AL BASEMENT HX-3	55	40	67	ARMSTRONG 4300 1205-001.5
P-2	HX-3	55	40	67	ARMSTRONG 4300 1205-001.5
P-3	HX-3	56	30	67	ARMSTRONG 4300 1205-000.7
P-4	HX-3	56	30	67	ARMSTRONG 4300 1205-000.7
PP-1	AL BASEMENT BOILER	0	0	0	
PP-2	AL BASEMENT BOILER	0	0	0	

DELETE PUMP (BP-1)
DELETE PUMP (BP-2)
DELETE PUMP (P-2)
DELETE PUMP (P-3)
DELETE PUMP (P-4)
DELETE PUMP (PP-1)
DELETE PUMP (PP-2)

AIR CURTAIN SCHEDULE (ACR)

NOTES:
1.MANUFACTURER SHALL PROVIDE FACTORY WIRED MOTOR STARTER, DISCONNECT, CONTROL TRANSFORMER AS REQUIRED FOR SINGLE POINT POWER CONNECTION, TIME DELAY RELAY, AND REMOTE THERMOSTAT.

TAG NAME	LOCATION NAME	SERVICE	ARRANGEMENT	FINISH	MBH	STEAM CFM DESIGN	STEAM DRIVE	STEAM MHP	ELECTRIC ELEMENT LB/HR	ELECTRIC ELEMENT OPER PSIG	ELECTRIC ELEMENT NO. OF STAGES	ELECTRIC ELEMENT TOTAL KW (QTY * KW) QTY	ELECTRIC ELEMENT TOTAL KW (QTY * KW) KW	ELECTRICAL VOLTS	ELECTRICAL PH	DISCONNECT BY [A]	DISCONNECT TYPE [B]	CNTLR/STARTER BY [A]	CNTLR/STARTER TYPE [C]	CNTLR/STARTER SCCR	CNTLR/STARTER EM PWR	VIBRATION ISO TYPE	VIBRATION ISO DEFL	MAXIMUM DIMENSIONS WIDTH	MAXIMUM DIMENSIONS HEIGHT	MAXIMUM DIMENSIONS DEPTH	WEIGHT LBS DRY	WEIGHT LBS OPERATING	MANUFACTURER	MODEL	NOTES (NOTE 1)
AC-1	POOL DECK		WALL-MOUNTED	CC	95.6	2,706	AC	0.5	0	0	1	1	12	208	3	MFR		MFR		0	No		0"	6'-0"	1'-1"	1'-10"	0	176	Berner International Corp.	A310-E-2072E	1
AC-2			WALL-MOUNTED	CC	95.6	2,706	AC	0.5	0	0	1	1	12	208	3	MFR		MFR		0	No		0"	6'-0"	1'-1"	1'-10"	0	176	Berner International Corp.	A310-E-2072E	1


HKS
ARCHITECT
HKS ARCHITECTS, P.C.
30 WEST 26th STREET, 12th FLOOR
NEW YORK, NY 10010
STRUCTURAL
IMEG
1411 BROADWAY, SUITE 600
NEW YORK, NY 10018
MEP ENGINEER
IMEG
177 CROSSWAYS PARK DRIVE
WOODBURY, NY 11797
LV ENGINEER
TAZERGY
7653 HICKORY FLAT HWY, SUITE 200
WOODSTOCK, GA 301888
LANDSCAPE ARCHITECT
MPFP
120 BROADWAY, 20TH FLOOR
NEW YORK, NY 10271
POOL DESIGNER
COUNSILMAN-HUNSAKER & ASSOCIATES, INC.
12851 MANCHESTER ROAD, SUITE 120
ST. LOUIS, MO 63131
FOOD SERVICE & LAUNDRY
CLARK
2551 HORSESHOE RD.
LANCASTER, PA 17601

SUNRISE SENIOR LIVING
RYE BROOK
PROJECT ADDRESS: 900 King St, Rye Brook, NY 10573

DOB BSCAN | DOB STAMP & SIGNATURES

SEAL & SIGNATURE

CON NO.: 111AAA
KEY PLAN

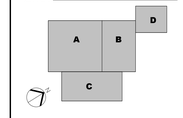

REVISION

NO.	DESCRIPTION	DATE
1	DD Progress Print	09/26/25
2	DESIGN DEVELOPMENT	11/25/25
3	EXTERIOR BUILDING PERMIT	12/23/25
4	100% DESIGN DEVELOPMENT	01/30/26
5	ISSUED FOR PERMIT	06/05/26

HKS PROJECT NUMBER
25004064.00
DATE
07/15/26
ISSUE
ISSUED FOR GMP
SHEET TITLE
MECHANICAL SCHEDULES
SHEET NO.
M6001

DOB FILE #:_____ DOB PAGE #:_____

IMEG 177 CROSSWAYS PARK DRIVE WOODBURY, NY 11797 P: 516.827.4900 www.IMEGCORP.COM
IMEG RESERVES PROPRIETARY RIGHTS, INCLUDING COPYRIGHTS, TO THIS DRAWING AND THE DATA SHOWN THEREON. SAID DRAWING AND/OR DATA ARE THE EXCLUSIVE PROPERTY OF IMEG AND SHALL NOT BE USED OR REPRODUCED FOR ANY OTHER PROJECT WITHOUT THE EXPRESS WRITTEN APPROVAL AND PARTICIPATION OF IMEG. ©2025 IMEG CONSULTANTS CORP.
0 1 2 3
REF. SCALE IN INCHES PROJECT #25004064.00
© HKS, INC.

MODEL: Autodesk Docs://25004064.00_Sunrise Rye Brook NY - Senior & ALMC_2025MEP25_25004064.00_R_AL Building_C.rvt
PRINT DATE: 7/15/2026 12:46:39 PM TEMPLATE VERSION: 23.0.4

NORTHERN WOLVES AC - VALUE ENGINEERING MARK-UP Rev 0 10/27/2026

Sheet M6000 (GMP set 07.15.2026). For discussion - not a design document.

DELETE FCU (1): Hot water FCU deleted; replaced by electric unit heaters (9) as marked on M2000 / M2002.

CANCEL VAV (18): Cancel VAV box (open area / circulation). Branch duct stays with manual volume damper, balanced to design max CFM; area served directly by the RTU (RTU space sensor here). Gas heat from the RTU.

KEEP VAV - ELEC. REHEAT (25): Keep VAV box. Electric reheat coil with SCR in lieu of hot water coil; simple standalone thermostat. No hot water piping or control valve.

KEEP VAV - NO REHEAT (4): Keep VAV box, cooling only. No reheat required: RTU is gas heat and the room is interior / back-of-house. Standalone thermostat.

TAG NAME	LOCATION	SERVICE	SUPPLY FAN CFM	SUPPLY FAN E.S.P	SUPPLY FAN HP	EXHAUST FAN CFM	EXHAUST FAN E.S.P.	EXHAUST FAN HP	SENSIBLE MBH	COOLING COIL TOTAL MBH	COOLING COIL EAT DB	COOLING COIL EAT WB	COOLING COIL LAT DB	COOLING COIL LAT WB	HEAT PUMP TOTAL MBH	HEAT PUMP EAT	HEAT PUMP LAT	ENERGY WHEEL PERFORMANCE DATA: RECOVERED CAPACITY: SUMMER TOTAL MBH	SUMMER SENS. MBH	WINTER TOTAL MBH	WINTER SENS. MBH	ENTHALPY RECOVERY RATIO	EER	FILTER TYPE	REFRIGERANT TYPE	ELECTRICAL: VOLTS	PH	FLA	MCA	MOCP	MAXIMUM DIMENSIONS: WIDTH	HEIGHT	DEPTH	WEIGHT LBS: OPERATING	MANUFACTURER	MODEL
DOAS-1	IL ROOF	NORTHWEST RESIDENCE	3,500	2.25	3.27	0	0.75	1.83	113.1	175.8	80.7	67.8	50.6	50.6	124.5	53	84.6	96.6	53.65	213.24	154.65	62.9	14.7	MERV-8	R-454B	460	3	46.5	49.6	60	7'-11"	5'-8"	15'-3"	4,143	TRANE	HORIZON
DOAS-2	IL ROOF	NORTHEAST RESIDENCE	3,500	2.25	3.27	0	0.75	1.83	113.1	175.8	80.7	67.8	50.6	50.6	124.5	53	84.6	96.6	53.65	213.24	154.65	62.9	14.7	MERV-8	R-454B	460	3	46.5	49.6	60	7'-11"	5'-8"	15'-3"	4,143	TRANE	HORIZON
DOAS-3	IL ROOF	SOUTHWEST RESIDENCE	3,500	2.25	3.27	0	0.75	1.83	113.1	175.8	80.7	67.8	50.6	50.6	124.5	53	84.6	96.6	53.65	213.24	154.65	62.9	14.7	MERV-8	R-454B	460	3	46.5	49.6	60	7'-11"	5'-8"	15'-3"	4,143	TRANE	HORIZON
DOAS-4	IL ROOF	SOUTHEAST RESIDENCE	3,900	2.25	3.86	0	0.75	2.26	123.1	196.3	80.8	67.9	51.4	50.8	136.3	52.7	82.4	105.97	59.39	234.75	171.3	61.9	14.1	MERV-8	R-454B	460	3	49.5	52.6	60	7'-11"	5'-8"	15'-3"	4,392	TRANE	HORIZON
DOAS-5	AL ROOF	AL RESIDENCE	6,500	2.25	7.92	0	0.75	3.84	220.3	329	80.7	67.8	49.1	49.1	239.6	53	83.7	177.71	99.24	393.13	286.17	62.6	12.3	MERV-8	R-454B	460	3	81.9	88.7	110	7'-11"	5'-8"	15'-3"	5,538	TRANE	HORIZON
DOAS-6	IL ROOF	SOUTHEAST RESIDENCE	3,500	2.25	3.27	0	0.75	1.83	113.1	175.8	80.7	67.8	50.6	50.6	124.5	53	84.6	96.6	53.65	213.24	154.65	62.9	14.7	MERV-8	R-454B	460	3	46.5	49.6	60	7'-11"	5'-8"	15'-3"	4,143	TRANE	HORIZON
DOAS-7	IL ROOF	SOUTHEAST RESIDENCE	3,500	2.25	3.27	0	0.75	1.83	113.1	175.8	80.7	67.8	50.6	50.6	124.5	53	84.6	96.6	53.65	213.24	154.65	62.9	14.7	MERV-8	R-454B	460	3	46.5	49.6	60	7'-11"	5'-8"	15'-3"	4,143	TRANE	HORIZON

PACKAGED ROOFTOP UNIT SCHEDULE (RTU)

REFER TO "PACKAGED ROOFTOP UNIT COMPONENT SCHEDULES" FOR ADDITIONAL INFORMATION

NOTES:
1.OPERATING WEIGHT INCLUDES UNIT, CURB, ACCESSORIES AND UNIT MOUNTED POWER EXHAUST. DUCT MOUNTED ACCESSORIES AND EQUIPMENT ARE NOT INCLUDED. CONTRACTOR IS RESPONSIBLE FOR ALL CHANGES REQUIRED DUE TO ROOFTOP UNIT HEAVIER THAN THE BASIS OF DESIGN AT NO ADDITIONAL COST.

TAG NAME	LOCATION	SERVICE	SUPPLY FAN CFM	SUPPLY FAN ESP	SUPPLY FAN HP	EXHAUST FAN CFM	EXHAUST FAN ESP	EXHAUST FAN HP	COOLING COIL: TOTAL MBH	SENSIBLE MBH	EAT DB	EAT WB	LAT DB	LAT WB	NATURAL GAS HEATING: HEATING INPUT (MBH)	HEATING OUTPUT MBH	HEATING COIL EAT	HEATING COIL LAT	EER	REFRIGERANT TYPE	TONS	ELECTRICAL: VOLTS	PH	HZ	MCA	MOCP	DIMENSIONS: WIDTH	HEIGHT	DEPTH	WEIGHT LBS: OPERATING	MANUFACTURER	MODEL
RTU-1	IL ROOF	WEST WING	10,500	2.5"	15	7500	1"	1	359.78	277.2	75	62.5	50.4	50.3	600	486	75	118.1	10.7	R-454B	30	460	3	60	90	100	7'-6"	5'-10"	17'-4"	5,417	TRANE	VOYAGER
RTU-2	IL ROOF	CENTER WING	7,000	1.25"	2.9	4500	0.5"	2	249.37	146.38	75	0	56.1	56.1	400	324	75	108.6	9.3	R-454B	20	460	3	60	55	70	7'-3"	5'-6"	10'-3"	2,699	TRANE	PRECEDENT
RTU-3	IL ROOF	EAST WING	7,200	1.75"	2.9	5200	0.5"	2	251.85	148.84	75	0	56.3	55.5	400	324	75	116.1	9.3	R-454B	20	460	3	60	55	70	7'-3"	5'-6"	10'-3"	2,699	TRANE	PRECEDENT
RTU-4	IL ROOF	KITCHEN	3,500	1.4"	4.2	2700	0.5"	1	122.55	72.54	75	0	55.5	55.5	240	194.4	75	125.8	10.8	R-454B	10	460	3	60	35	45	5'-3"	4'-4"	8'-3"	1,803	TRANE	PRECEDENT
RTU-5	AL ROOF	ASSISTED LIVING	11,000	2.5"	51	10000	1"	1	390	297.58	75	62.6	49.9	49.8	600	864	75	116	10.3	R-454B	35	460	3	60	94	110	7'-6"	5'-10"	17'-4"	5,489	TRANE	VOYAGER

PACKAGED TERMINAL AIR CONDITIONER SCHEDULE (PTAC)

NOTES:
1.

TAG NAME	AMBIENT TEMP °F: SUMMER DRY BULB	AMBIENT TEMP °F: WINTER DRY BULB	SERVICE	TYPE	FAN CFM: DESIGN	OA CFM: DESIGN	REFRIGERATION: TYPE	REFRIGERATION: CHARGE LBS	EFFICIENCY: CLG EER	EFFICIENCY: HTG COP	COOLING: BTUH	HEATING (HEAT PUMP W/ AUX. ELECTRIC HEAT): HEAT PUMP BTUH @37°F	ELECTRIC ELEMENT: NO. OF STAGES	ELECTRIC ELEMENT: TOTAL KW (QTY * KW): QTY	KW	ELECTRICAL: VOLTS	PH	FLA	MCA	MOCP	DISCONNECT: BY [A]	DISCONNECT: TYPE [B]	CNTLR/STARTER: BY [A]	CNTLR/STARTER: TYPE [C]	SCCR	EM PWR	CONTROL: TYPE [H]	MAXIMUM DIMENSIONS: WIDTH	HEIGHT	DEPTH	WEIGHT LBS: OPERATING	MANUFACTURER	MODEL	NOTES
PTAC-1A	95	27	ASSISTED LIVING	WALL-MOUNTED	330	0	R32	0	12.8	3.7	7000	6100	1	1	1.3	208	1	6.2	8.5	15	MFR		MFR		0	No		3'-6"	1'-7"	1'-10"	106	AMANA	PTH073J	
PTAC-1B	95	27	ASSISTED LIVING	WALL-MOUNTED	330	0	R32	0	12.8	3.7	7000	6100	1	1	2.1	208	1	10.1	14.1	15	MFR		MFR		0	No		3'-6"	1'-7"	1'-10"	106	AMANA	PTH073J	
PTAC-1C	95	27	ASSISTED LIVING	WALL-MOUNTED	330	0	R32	0	12.8	3.7	7000	6100	1	1	3	208	1	14.1	19.5	20	MFR		MFR		0	No		3'-6"	1'-7"	1'-10"	106	AMANA	PTH073J	
PTAC-2B	95	27	ASSISTED LIVING	WALL-MOUNTED	330	0	R32	0	12.5	3.6	9000	8000	1	1	2.1	208	1	10.1	14.1	15	MFR		MFR		0	No		3'-6"	1'-7"	1'-10"	102	AMANA	PTH093J	
PTAC-2C	95	27	ASSISTED LIVING	WALL-MOUNTED	330	0	R32	0	12.5	3.6	9000	8000	1	1	3	208	1	14	19.5	20	MFR		MFR		0	No		3'-6"	1'-7"	1'-10"	102	AMANA	PTH093J	
PTAC-2D	95	27	ASSISTED LIVING	WALL-MOUNTED	330	0	R32	0	12.5	3.6	9000	8000	1	1	4.1	208	1	20	27.6	30	MFR		MFR		0	No		3'-6"	1'-7"	1'-10"	102	AMANA	PTH093J	
PTAC-3B	95	27	ASSISTED LIVING	WALL-MOUNTED	330	0	R32	0	11.5	3.3	11600	10800	1	1	2.1	208	1	10.1	14.1	15	MFR		MFR		0	No		3'-6"	1'-7"	1'-10"	108	AMANA	PTH123J	
PTAC-3C	95	27	ASSISTED LIVING	WALL-MOUNTED	330	0	R32	0	11.5	3.3	11600	10800	1	1	3	208	1	14.1	19.5	20	MFR		MFR		0	No		3'-6"	1'-7"	1'-10"	108	AMANA	PTH123J	
PTAC-3D	95	27	ASSISTED LIVING	WALL-MOUNTED	330	0	R32	0	11.5	3.3	11600	10800	1	1	4.1	208	1	20	27.6	30	MFR		MFR		0	No		3'-6"	1'-7"	1'-10"	108	AMANA	PTH123J	
PTAC-4D	95	27	ASSISTED LIVING	WALL-MOUNTED	330	0	R32	0	10.6	3.1	14000	14000	1	1	4.1	208	1	20	27.6	30	MFR		MFR		0	No		3'-6"	1'-7"	1'-10"	113	AMANA	PTH153J	

FAN COIL UNIT SCHEDULE - HYDRONIC (FCU)

NOTES:
1.

TAG NAME	QUANTITY	SERVICE	TYPE	FAN: CFM DESIGN	FAN: EXT S.P. IN. WC	FAN: MOTOR MHP [E]	HEATING COIL: MBH	EAT DB °F	LAT DB °F	GPM DESIGN	W.P.D. FT. HD.	EWT °F	LWT °F	ELECTRICAL: VOLTS	PH	CONTROL: TYPE [H]	DIAGRAM	MAXIMUM DIMENSIONS: WIDTH	HEIGHT	DEPTH	WEIGHT LBS: DRY	MANUFACTURER	MODEL	NOTES
FCU-A	20	BASEMENT HEATING	HORIZONTAL	0	0	0	0	0	0	0	0	0	0	0	1			0"	0"	0"	0			

DELETE FCU (QTY 20)

VAV SCHEDULE - HYDRONIC REHEAT

TAG	AHU	ROOM	MODEL	SIZE: UNIT	SIZE: OUTLET	CFM: MAX	CFM: MIN	STATIC PRESSURE: INLET	STATIC PRESSURE: DOWN	STATIC PRESSURE: MIN	NC LEVELS: RAD	NC LEVELS: DIS	HOT WATER HEATING COIL: CFM	MBH	EAT	EWT	LAT	APd	GPM	LWT	WPd	ROWS	FPI	UNIT INFO: HAND	
VAV-01			DESV	12	16x15	1200	825	1	0.25	0.24	20	24	825	26.9	60	160	90	0.23	1.5	122.5	0.24	2-RH	10	RH	KEEP VAV - ELEC. REHEAT (8 kW)
VAV-02			DESV	14	20x17.5	1450	1350	1	0.25	0.19	20	19	1350	44	60	160	90	0.17	2.4	122.6	0.3	2-RH	10	RH	KEEP VAV - ELEC. REHEAT (13 kW)
VAV-03			DESV	14	20x17.5	2250	1150	1	0.25	0.39	23	22	1150	37.5	60	160	90	0.35	1.9	120	0.22	2-RH	10	RH	KEEP VAV - ELEC. REHEAT (11 kW)
VAV-04			DESV	08	12x10	700	375	1	0.25	0.32	22	28	375	12.2	60	160	90	0.3	0.8	127.1	0.15	2-RH	10	RH	KEEP VAV - ELEC. REHEAT (4 kW)
VAV-05			DESV	08	12x10	400	400	1	0.25	0.13	17	25	400	13	60	160	90	0.12	0.8	127.8	0.17	2-RH	10	RH	CANCEL VAV
VAV-06			DESV	08	12x10	400	400	1	0.25	0.13	17	25	400	13	60	160	90	0.12	0.8	127.8	0.17	2-RH	10	RH	CANCEL VAV
VAV-07			DESV	10	14x12.5	700	250	1	0.25	0.09	23	27	250	8.1	60	160	90	0.08	1	143.9	0.15	1-RH	10	RH	KEEP VAV - ELEC. REHEAT (2.5 kW)
VAV-08			DESV	04	12x8	200	100	1	0.25	0.11	27	34	100	3.3	60	160	90.7	0.03	0.4	140.8	0.1	1-RH	10	RH	KEEP VAV - NO REHEAT
VAV-09			DESV	08	12x10	350	150	1	0.25	0.06	17	25	150	4.9	60	160	90	0.05	0.5	137.8	0.19	1-RH	10	RH	KEEP VAV - ELEC. REHEAT (1.5 kW)
VAV-10			DESV	06	12x8	425	250	1	0.25	0.36	23	24	250	8.9	60	160	92.8	0.21	0.7	134.3	0.1	2-RH	10	RH	KEEP VAV - ELEC. REHEAT (3 kW)
VAV-11			DESV	10	14x12.5	550	500	1	0.25	0.12	20	24	500	16.8	60	160	90.9	0.11	1.1	127.8	0.14	2-RH	10	RH	KEEP VAV - ELEC. REHEAT (5 kW)
VAV-12			DESV	14	20x17.5	1300	1300	1	0.25	0.15	18	19	1300	42.3	60	160	90	0.14	2.3	122.3	0.28	2-RH	10	RH	CANCEL VAV
VAV-13			DESV	10	14x12.5	600	600	1	0.25	0.14	20	24	600	19.5	60	160	90	0.13	1.3	128.7	0.18	2-RH	10	RH	CANCEL VAV
VAV-14			DESV	10	14x12.5	600	600	1	0.25	0.14	20	24	600	19.5	60	160	90	0.13	1.3	128.7	0.18	2-RH	10	RH	KEEP VAV - NO REHEAT
VAV-15			DESV	06	12x8	200	200	1	0.25	0.09	14	22	200	8.1	60	160	97.4	0.06	0.7	136.6	0.1	2-RH	10	RH	KEEP VAV - ELEC. REHEAT (2.5 kW)
VAV-16			DESV	06	12x8	300	250	1	0.25	0.19	18	22	250	8.9	60	160	92.8	0.12	0.7	134.3	0.1	2-RH	10	RH	KEEP VAV - ELEC. REHEAT (3 kW)
VAV-17			DESV	08	12x10	450	450	1	0.25	0.16	18	25	450	14.7	60	160	90	0.15	1	129.4	0.21	2-RH	10	RH	KEEP VAV - ELEC. REHEAT (4.5 kW)
VAV-18			DESV	08	12x10	500	500	1	0.25	0.19	19	27	500	16.3	60	160	90	0.18	1.1	130.8	0.25	2-RH	10	RH	CANCEL VAV
VAV-19			DESV	06	12x8	200	50	1	0.25	0.06	14	22	50	2.4	60	160	103.6	0.03	0.4	146.4	0.1	1-RH	10	RH	CANCEL VAV
VAV-20			DESV	08	12x10	350	150	1	0.25	0.06	17	25	150	4.9	60	160	90	0.05	0.5	137.8	0.19	1-RH	10	RH	KEEP VAV - ELEC. REHEAT (1.5 kW)
VAV-21			DESV	08	12x10	300	150	1	0.25	0.05	14	24	150	4.9	60	160	90	0.04	0.5	137.8	0.19	1-RH	10	RH	KEEP VAV - ELEC. REHEAT (1.5 kW)
VAV-22			DESV	12	16x15	900	250	1	0.25	0.08	19	23	250	8.4	60	160	90.8	0.07	0.7	135.9	0.11	1-RH	10	RH	KEEP VAV - ELEC. REHEAT (2.5 kW)
VAV-23			DESV	06	12x8	300	100	1	0.25	0.13	20	22	100	3.3	60	160	90.7	0.06	0.4	140.8	0.1	1-RH	10	RH	CANCEL VAV
VAV-24			DESV	10	14x12.5	550	200	1	0.25	0.07	22	24	200	6.6	60	160	90.3	0.06	0.7	141	0.09	1-RH	10	RH	CANCEL VAV
VAV-25			DESV	14	20x17.5	3000	1100	1	0.25	0.64	25	23	1100	35.8	60	160	90	0.56	1.8	119.3	0.2	2-RH	10	RH	CANCEL VAV
VAV-26			DESV	06	12x8	400	200	1	0.25	0.32	22	24	200	8.1	60	160	97.4	0.19	0.7	136.6	0.1	2-RH	10	RH	KEEP VAV - ELEC. REHEAT (2.5 kW)
VAV-27			DESV	14	20x17.5	1850	425	1	0.25	0.16	22	22	425	13.8	60	160	90	0.13	1.3	137.6	0.12	1-RH	10	RH	CANCEL VAV
VAV-28			DESV	10	14x12.5	800	525	1	0.25	0.21	22	24	525	17.1	60	160	90	0.2	1.1	127.2	0.14	2-RH	10	RH	CANCEL VAV
VAV-29			DESV	16	24x18	1800	600	1	0.25	0.1	17	18	600	19.5	60	160	90	0.09	1.9	139	0.23	1-RH	10	RH	CANCEL VAV
VAV-30			DESV	06	12x8	350	200	1	0.25	0.26	21	23	200	8.1	60	160	97.4	0.16	0.7	136.6	0.1	2-RH	10	RH	KEEP VAV - ELEC. REHEAT (2.5 kW)
VAV-31			DESV	14	20x17.5	1200	400	1	0.25	0.07	19	19	400	13	60	160	90	0.06	1.1	136.6	0.1	1-RH	10	RH	KEEP VAV - NO REHEAT
VAV-32			DESV	06	12x8	150	50	1	0.25	0.04	11	18	50	2.4	60	160	103.6	0.02	0.4	146.4	0.1	1-RH	10	RH	KEEP VAV - NO REHEAT
VAV-33			DESV	16	24x18	2500	1000	1	0.25	0.33	18	20	1000	36.3	60	160	93.5	0.31	2.1	125.1	0.1	2-RH	10	RH	CANCEL VAV
VAV-34			DESV	14	20x17.5	1200	450	1	0.25	0.07	19	19	450	14.7	60	160	90	0.06	1.4	138.7	0.14	1-RH	10	RH	CANCEL VAV
VAV-35			DESV	06	12x8	200	200	1	0.25	0.09	14	22	200	8.1	60	160	97.4	0.06	0.7	136.6	0.1	2-RH	10	RH	CANCEL VAV
VAV-36			DESV	08	12x10	350	150	1	0.25	0.06	17	25	150	4.9	60	160	90	0.05	0.5	137.8	0.19	1-RH	10	RH	CANCEL VAV
VAV-37			DESV	08	12x10	250	150	1	0.25	0.04	13	27	150	4.9	60	160	90	0.03	0.5	137.8	0.19	1-RH	10	RH	CANCEL VAV
VAV-38			DESV	08	12x10	450	300	1	0.25	0.16	18	25	300	10.9	60	160	93.4	0.15	0.7	128.6	0.14	2-RH	10	RH	KEEP VAV - ELEC. REHEAT (3.5 kW)
VAV-39			DESV	06	12x8	400	250	1	0.25	0.32	22	24	250	8.9	60	160	92.8	0.19	0.7	134.3	0.1	2-RH	10	RH	KEEP VAV - ELEC. REHEAT (3 kW)
VAV-40			DESV	06	12x8	200	100	1	0.25	0.06	14	22	100	3.3	60	160	90.7	0.03	0.4	140.8	0.1	1-RH	10	RH	CANCEL VAV
VAV-41			DESV	08	12x10	400	150	1	0.25	0.07	18	25	150	4.9	60	160	90	0.06	0.5	137.8	0.19	1-RH	10	RH	KEEP VAV - ELEC. REHEAT (1.5 kW)
VAV-42			DESV	12	16x15	600	200	1	0.25	0.05	16	23	200	7.6	60	160	94.9	0.04	0.7	138.2	0.11	1-RH	10	RH	KEEP VAV - ELEC. REHEAT (2.5 kW)
VAV-43			DESV	14	20x17.5	1000	400	1	0.25	0.06	18	18	400	13	60	160	90	0.05	1.1	136.6	0.1	1-RH	10	RH	KEEP VAV - ELEC. REHEAT (4 kW)
VAV-44			DESV	16	24x18	1100	500	1	0.25	0.05	12	11	500	16.3	60	160	90	0.04	1.3	134.7	0.14	1-RH	10	RH	KEEP VAV - ELEC. REHEAT (5 kW)
VAV-45			DESV	08	12x10	450	350	1	0.25	0.16	18	25	350	11.5	60	160	90.3	0.15	0.7	126.8	0.14	2-RH	10	RH	KEEP VAV - ELEC. REHEAT (3.5 kW)
VAV-46			DESV	06	12x8	400	200	1	0.25	0.32	22	24	200	8.1	60	160	97.4	0.19	0.7	136.6	0.1	2-RH	10	RH	KEEP VAV - ELEC. REHEAT (2.5 kW)
VAV-47			DESV	06	12x8	450	300	1	0.25	0.4	23	24	300	9.8	60	160	90	0.24	0.7	133.2	0.11	2-RH	10	RH	KEEP VAV - ELEC. REHEAT (3 kW)

NOTES
1. SELECTIONS ARE BASED ON TITUS AS MANUFACTURER.
2. ALL PERFORMANCE BASED ON TESTS CONDUCTED IN ACCORDANCE WITH ASHRAE 130-2008 AND AHRI 880-2011.
3. ALL NC LEVELS DETERMINED USING AHRI 885-2008 APPENDIX E.
4. ALL AIRFLOW, PRESSURE LOSSES AND HEATING PERFORMANCE VALUES HAVE BEEN CORRECTED FOR ALTITUDE.
5. UNITS OF MEASURE: DIMENSIONS (IN), AIRFLOW (CFM), WATER FLOW (GPM), AIR PRESSURE (IN WG), WATER HEAD LOSSES (FT) AND TEMPERATURES (DEGF).
6. WATER PRESSURE DROP (WPD) UNITS IS IN FT. WATER.

HKS

ARCHITECT
HKS ARCHITECTS, P.C.
30 WEST 26th STREET, 12th FLOOR
NEW YORK, NY 10010

STRUCTURAL
IMEG
1411 BROADWAY, SUITE 600
NEW YORK, NY 10018

MEP ENGINEER
IMEG
177 CROSSWAYS PARK DRIVE
WOODBURY, NY 11797

LV ENGINEER
TAZERGY
7653 HICKORY FLAT HWY, SUITE 200
WOODSTOCK, GA 301888

LANDSCAPE ARCHITECT
MPFP
120 BROADWAY, 20TH FLOOR
NEW YORK, NY 10271

POOL DESIGNER
COUNSILMAN-HUNSAKER & ASSOCIATES, INC.
12851 MANCHESTER ROAD, SUITE 120
ST. LOUIS, MO 63131

FOOD SERVICE & LAUNDRY
CLARK
2551 HORSESHOE RD.
LANCASTER, PA 17601

SUNRISE SENIOR LIVING


RYE BROOK

PROJECT ADDRESS: 900 King St, Rye Brook, NY 10573

DOB BSCAN | DOB STAMP & SIGNATURES

SEAL & SIGNATURE_____

CON NO.: 111AAA
KEY PLAN_____

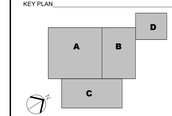

REVISION

NO.	DESCRIPTION	DATE
1	DD Progress Print	09/26/25
2	DESIGN DEVELOPMENT	11/25/25
3	EXTERIOR BUILDING PERMIT	12/23/25
4	100% DESIGN DEVELOPMENT	01/30/26
5	ISSUED FOR PERMIT	06/05/26

HKS PROJECT NUMBER
25004064.00

DATE
07/15/26

ISSUE
ISSUED FOR GMP

SHEET TITLE
MECHANICAL SCHEDULES

SHEET NO.
M6000

DOB FILE #:_____ DOB PAGE #:_____

IMEG
177 CROSSWAYS PARK DRIVE
WOODBURY, NY 11797
P. 516.827.4900
www.imegcorp.com

IMEG RESERVES PROPRIETARY RIGHTS, INCLUDING COPYRIGHTS, TO THIS DRAWING AND THE DATA SHOWN THEREON. SAID DRAWING AND/OR DATA ARE THE EXCLUSIVE PROPERTY OF IMEG AND SHALL NOT BE USED OR REPRODUCED FOR ANY OTHER PROJECT WITHOUT THE WRITTEN CONSENT OF IMEG AND PARTICIPATION OF IMEG.
©2025 IMEG CONSULTANTS CORP.

REF. SCALE IN INCHES 0 1 2 3 — PROJECT #25004064.00

© HKS, INC.

PRINT DATE: 7/15/2026 12:46:29 PM TEMPLATE VERSION: 23.0.4 MODEL: ...\submits Docs 25720\2,000 Sunrise Rye Brook NY - Senior IL-AL-MC - 25004MEP25_25004064.00_IL-AL Building_Cyl.rvt

NORTHERN WOLVES AC - VALUE ENGINEERING MARK-UP Rev 0 10/27/2026

Sheet M2010 (GMP set 07.15.2026). For discussion - not a design document.

KEEP VAV - ELEC. REHEAT (15): Keep VAV box. Electric reheat coil with SCR in lieu of hot water coil; simple standalone thermostat. No hot water piping or control valve.


CANCEL VAV (7): Cancel VAV box (open area / circulation). Branch duct stays with manual volume damper, balanced to design max CFM; area served directly by the RTU (RTU space sensor here). Gas heat from the RTU.

KEEP VAV - NO REHEAT (2): Keep VAV box, cooling only. No reheat required: RTU is gas heat and the room is interior / back-of-house. Standalone thermostat.

ELECTRIC CABINET HEATER (6): Replace hot water cabinet heater with electric cabinet heater with integral thermostat, same location. Delete hot water piping. Power by EC.

KEYNOTES:

1. 44x24 SUPPLY AIR DUCT UP THROUGH CHASE TO RTU-1.
2. 44x24 RETURN AIR DUCT UP THROUGH CHASE TO RTU-1.
3. 12x8 RETURN AIR DUCT UP THROUGH CHASE TO DOAS-1.
4. 10x10 SUPPLY AIR DUCT UP THROUGH CHASE TO DOAS-1.
5. 8x8 TOILET EXHAUST AIR DUCT UP THROUGH CHASE TO TX-1 ON ROOF.
6. 16x12 RETURN AIR DUCT UP THROUGH CHASE TO DOAS-3.
7. 14x12 SUPPLY AIR DUCT UP THROUGH CHASE TO DOAS-3.
8. 10" EXHAUST AIR SERVING TRASH ROOM UP THROUGH CHASE TO ROOF.
9. VAV UNITS TO REQUIRE ACCESS PANEL IN CEILING. COORDINATE ACCESS PANEL LOCATION WITH FINAL RCP. (TYP. ALL)
10. 80" ID/100" OD FIREPLACE CHIMNEY UP
11. 38x18 SUPPLY DUCT UP THROUGH CHASE TO RTU-2.
12. 46x16 RETURN DUCT UP THROUGH CHASE TO RTU-2.
13. 12x10 LOW RETURN DUCT UP AND DOWN IN BUMP OUT.
14. PROVIDE 8"x6" TRANSFER AIR DUCT THROUGH WALL WITH FIRE/SMOKE DAMPER AS REQUIRED.
15. PROVIDE 1-TON WALL MOUNTED MINI-SPLIT. ROUTE REFRIGERANT TO CONDENSING UNIT ON ROOF.

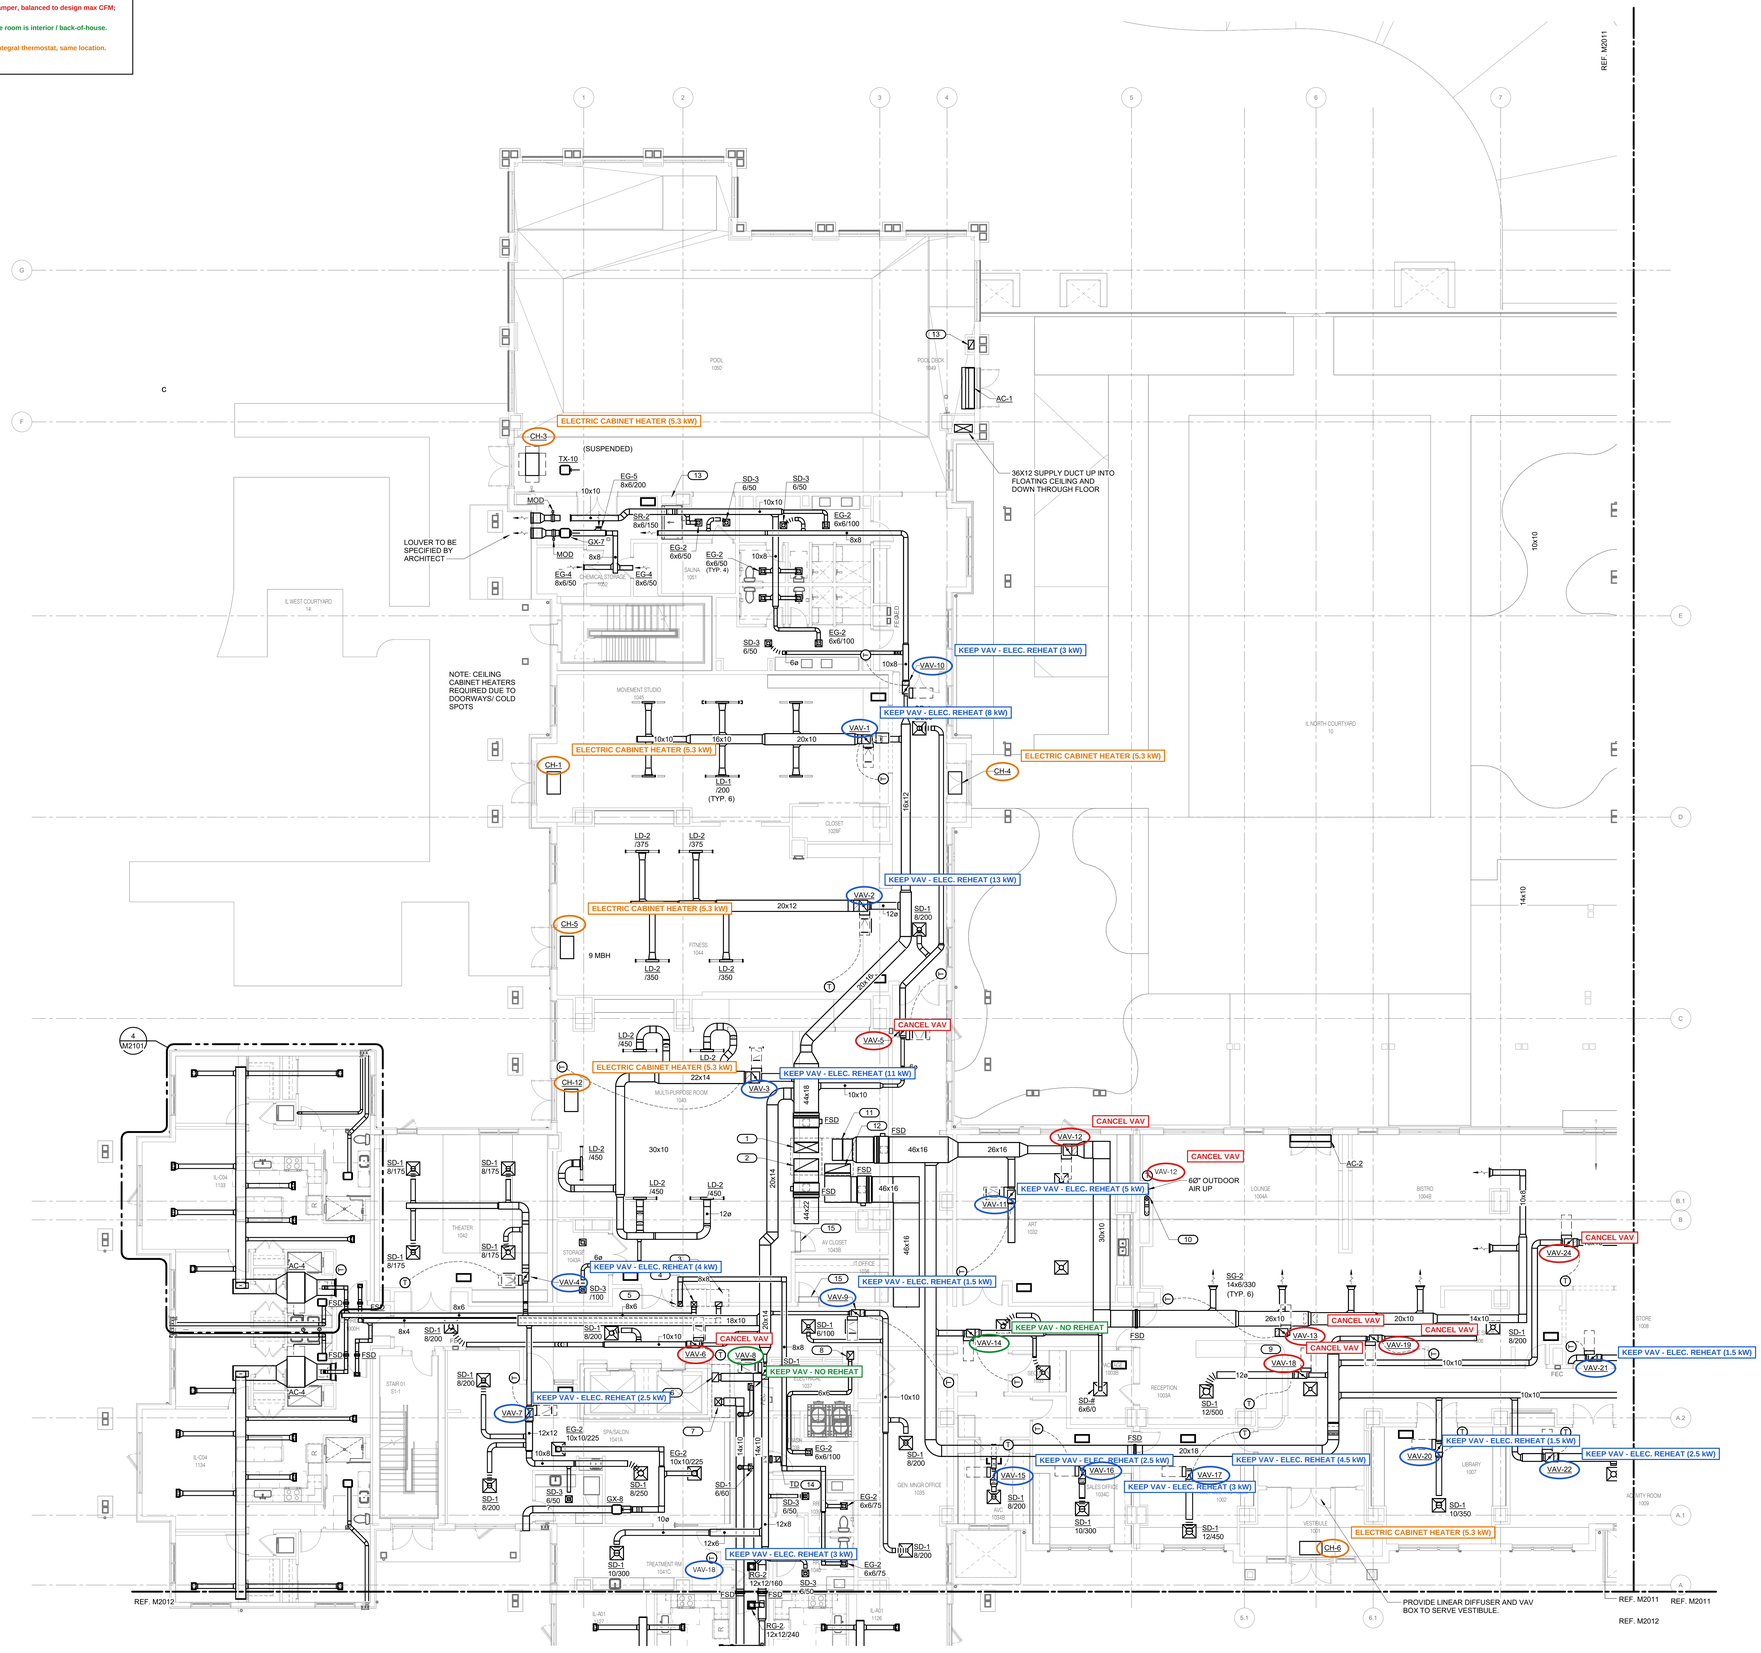

1 INDEPENDENT LIVING FIRST FLOOR PLAN - MECHANICAL IL AREA A

1/8" = 1'-0"

NORTH

ARCHITECT
HKS ARCHITECTS, P.C.
30 WEST 26th STREET, 12th FLOOR
NEW YORK, NY 10010

STRUCTURAL
IMEG
1411 BROADWAY, SUITE 600
NEW YORK, NY 10018

MEP ENGINEER
IMEG
177 CROSSWAYS PARK DRIVE
WOODBURY, NY 11797

LV ENGINEER
TAZERDY
7653 HICKORY FLAT HWY, SUITE 200
WOODSTOCK, GA 301888

LANDSCAPE ARCHITECT
MPFP
120 BROADWAY, 20TH FLOOR
NEW YORK, NY 10271

POOL DESIGNER
COUNSILMAN-HUNSAKER & ASSOCIATES, INC.
12851 MANCHESTER ROAD, SUITE 120
ST. LOUIS, MO 63131

FOOD SERVICE & LAUNDRY
CLARK
2551 HORSESHOE RD.
LANCASTER, PA 17601

SUNRISE SENIOR LIVING

RYE BROOK

PROJECT ADDRESS: 900 King St, Rye Brook, NY 10573

DOB BSCAN | DOB STAMP & SIGNATURES

SEAL & SIGNATURE

CON NO.: 111AAA
KEY PLAN

REVISION

NO.	DESCRIPTION	DATE
1	DD Progress Print	09/26/25
2	DESIGN DEVELOPMENT	11/25/25
3	EXTERIOR BUILDING PERMIT	12/23/25
4	100% DESIGN DEVELOPMENT	01/30/26
5	ISSUED FOR PERMIT	06/05/26

HKS PROJECT NUMBER
25004064.00

DATE
07/15/26

ISSUE
ISSUED FOR GMP

SHEET TITLE
INDEPENDENT LIVING FIRST FLOOR PLAN - MECHANICAL IL AREA A

SHEET NO.
M2010

DOB FILE #: DOB PAGE #:

IMEG 177 CROSSWAYS PARK DRIVE WOODBURY, NY 11797 P: 516.827.4900
www.imegcorp.com
IMEG RESERVES PROPRIETARY RIGHTS, INCLUDING COPYRIGHTS, TO THIS DRAWING AND THE DATA SHOWN THEREON. SAID DRAWING AND/OR DATA ARE NOT TO BE USED IN WHOLE OR IN PART, FOR ANY PURPOSE OTHER THAN THAT AUTHORIZED BY IMEG, AND SHALL NOT BE REPRODUCED, COPIED OR ASSIGNED TO ANY OTHERWISE DISCLOSED WITHOUT THE EXPRESS WRITTEN APPROVAL AND PARTICIPATION OF IMEG.
©2025 IMEG CONSULTANTS CORP.
REF. SCALE IN INCHES
PROJECT #25004064.00
© HKS, INC.

PRINT DATE: 7/15/2026 12:25:43 PM TEMPLATE VERSION: 23.0.4
MODEL: ...\Autodesk Docs\07292100_Sunrise Rye Brook NY - Senior & IL\AC_25004064FP25_25004064.00_A_IL Building_C+V.rvt

NORTHERN WOLVES AC - VALUE ENGINEERING MARK-UP Rev 0 10/27/2026


Sheet M2011 (GMP set 07.15.2026). For discussion - not a design document.

CANCEL VAV (6): Cancel VAV box (open area / circulation). Branch duct stays with manual volume damper, balanced to design max CFM; area served directly by the RTU (RTU space sensor here). Gas heat from the RTU.

KEEP VAV - ELEC. REHEAT (2): Keep VAV box. Electric reheat coil with SCR in lieu of hot water coil; simple standalone thermostat. No hot water piping or control valve.

KEEP VAV - NO REHEAT (2): Keep VAV box, cooling only. No reheat required: RTU is gas heat and the room is interior / back-of-house. Standalone thermostat.

ELECTRIC CABINET HEATER (4): Replace hot water cabinet heater with electric cabinet heater with integral thermostat, same location. Delete hot water piping. Power by EC.

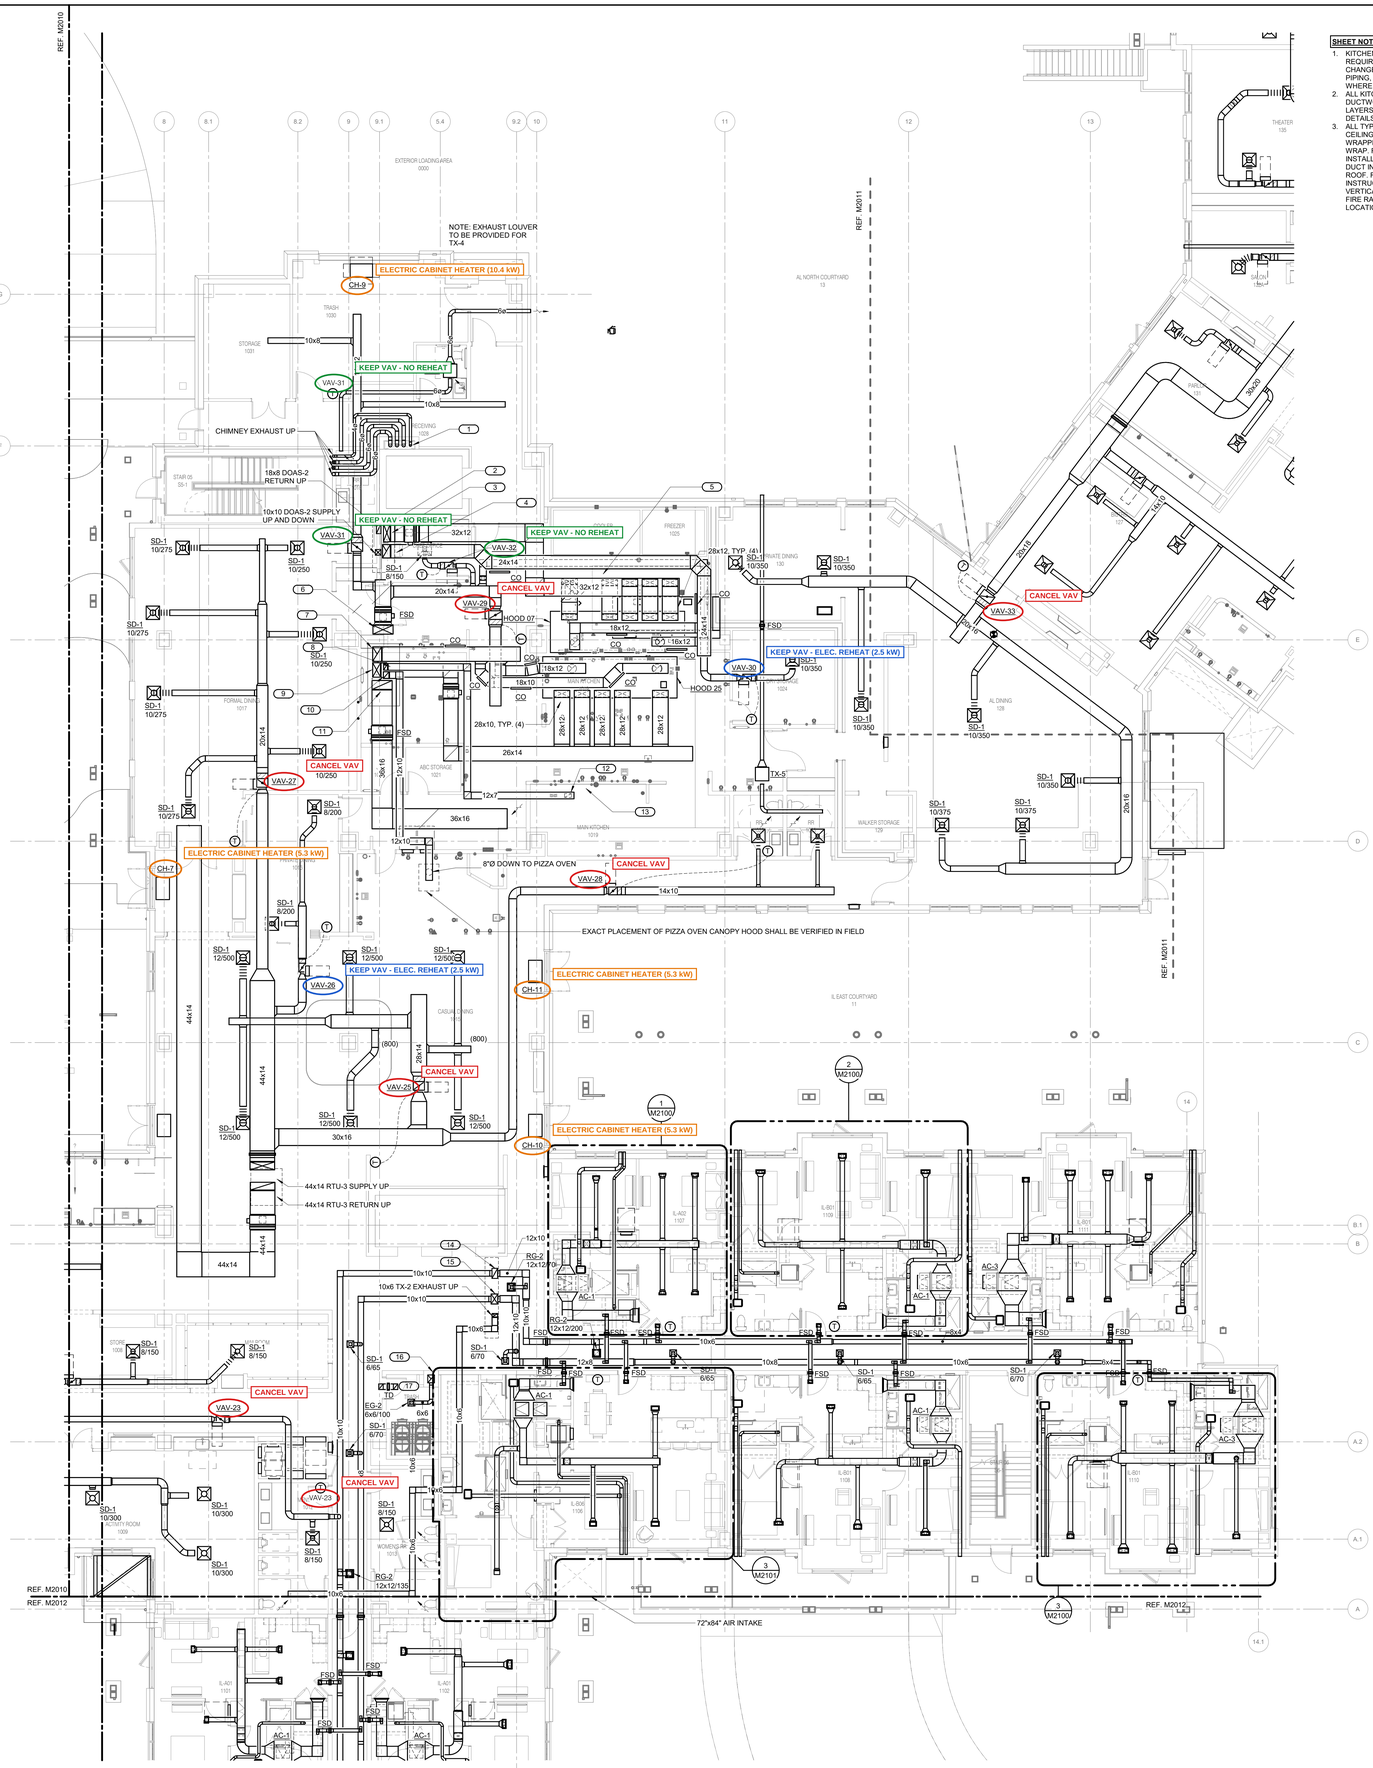

SHEET NOTES:

1. KITCHEN HOOD GREASE EXHAUST DUCTS REQUIRE CLEAN OUT ACCESS DOORS AT EVERY CHANGE IN DIRECTION. THERE SHALL BE NO PIPING, CONDUIT, OR APPLIANCES BELOW WHERE ACCESS DOORS ARE PLACED.
2. ALL KITCHEN HOOD GREASE EXHAUST DUCTWORK SHALL BE WRAPPED WITH (2) LAYERS OF MORGAN FAST WRAP. REFER TO DETAILS AND SPECIFICATIONS.
3. ALL TYPE I GREASE EXHAUST DUCTWORK IN CEILING AND IN DUCT SHAFT SHALL BE WRAPPED WITH (2) LAYERS OF MORGAN FAST WRAP. FOLLOW MANUFACTURER'S INSTALLATION RECOMMENDATIONS ON GREASE DUCT INSTALLATION UP TO UNDERSIDE OF ROOF. FOLLOW MANUFACTURER'S INSTRUCTIONS FOR ACCESS DOORS IN VERTICAL DUCT SHAFTS. GC TO COORDINATE FIRE RATED ACCESS DOORS IN CORRIDOR LOCATIONS.

KEYNOTES:

1. FIRE RATED CHIMNEY ENCLOSURE REQUIRED FROM BASEMENT CEILING TO ROOF
2. OUTLINE OF DUCT SHAFT ABOVE
3. 32x12 SUPPLY AIR DUCT UP AND DOWN (SERVING KITCHEN HOOD)THROUGH CHASE TO DOAS-6. PROVIDE FSD WHERE DUCT LEAVES CHASE.
4. 24x14 GREASE DUCT UP AND DOWN (SERVING KITCHEN HOOD 07) IN CHASE
5. 18" CLEAR FOR CO ACCESS FOR A PERSON ON LADDER BELOW
6. 36x16 RTU-4 SUPPLY UP IN SHAFT
7. 26x16 KITCHEN HOOD 25 GREASE DUCT UP IN SHAFT
8. 12x7 DISHWASHER EXHAUST UP IN SHAFT
9. 26x14 DOAS-7 KITCHEN HOOD 25 SUPPLY AIR UP IN SHAFT W/ FSD
10. 12x10 PIZZA OVEN EXHAUST UP IN SHAFT.
11. 36x16 RETURN AIR DUCT UP AND DOWN THROUGH CHASE TO RTU-4.
12. 12x8 DISH WASHER EXHAUST AIR DUCT UP AND DOWN IN CHASE.
13. EXACT PLACEMENT OF DISHWASHER SHALL BE VERIFIED.
14. 18x10 SUPPLY AIR DUCT UP AND DOWN THROUGH CHASE TO DOAS-4. PROVIDE FSD WHERE DUCT LEAVES CHASE.
15. 18x12 SUPPLY AIR DUCT UP AND DOWN THROUGH CHASE TO DOAS-4. PROVIDE FSD WHERE DUCT LEAVES CHASE.
16. 12x14 TRASH EXHAUST UP IN SHAFT.
17. PROVIDE 8"x6" TRANSFER AIR DUCT THROUGH WALL WITH FIRE/SMOKE DAMPER AS REQUIRED.

1 INDEPENDENT LIVING FIRST FLOOR PLAN - MECHANICAL IL AREA B

1/8" = 1'-0"

ARCHITECT
HKS ARCHITECTS, P.C.
30 WEST 26th STREET, 12th FLOOR
NEW YORK, NY 10010

STRUCTURAL
IMEG
1411 BROADWAY, SUITE 600
NEW YORK, NY 10018

MEP ENGINEER
IMEG
177 CROSSWAYS PARK DRIVE
WOODBURY, NY 11797

LV ENGINEER
TAZERDY
7653 HICKORY FLAT HWY, SUITE 200
WOODSTOCK, GA 301888

LANDSCAPE ARCHITECT
MPFP
120 BROADWAY, 20TH FLOOR
NEW YORK, NY 10271

POOL DESIGNER
COUNSILMAN-HUNSAKER & ASSOCIATES, INC.
12651 MANCHESTER ROAD, SUITE 120
ST. LOUIS, MO 63131

FOOD SERVICE & LAUNDRY
CLARK
2551 HORSESHOE RD.
LANCASTER, PA 17601

SUNRISE SENIOR LIVING

RYE BROOK


PROJECT ADDRESS: 900 King St, Rye Brook, NY 10573

DOB BSCAN | DOB STAMP & SIGNATURES

SEAL & SIGNATURE

CON NO.: 111AAA

KEY PLAN

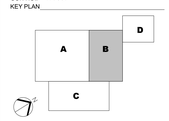

REVISION

NO.	DESCRIPTION	DATE
1	DD Progress Print	09/26/25
2	DESIGN DEVELOPMENT	11/25/25
3	EXTERIOR BUILDING PERMIT	12/23/25
4	100% DESIGN DEVELOPMENT	01/30/26
5	ISSUED FOR PERMIT	06/05/26

HKS PROJECT NUMBER
25004064.00

DATE
07/15/26

ISSUE
ISSUED FOR GMP

SHEET TITLE
INDEPENDENT LIVING FIRST FLOOR PLAN - MECHANICAL IL AREA B

SHEET NO.
M2011

DOB FILE #:_____ DOB PAGE #:_____

IMEG
177 CROSSWAYS PARK DRIVE
WOODBURY, NY 11797
P: 516.827.4900
www.imegcorp.com

IMEG RESERVES PROPRIETARY RIGHTS, INCLUDING COPYRIGHTS, TO THIS DRAWING AND THE DATA SHOWN THEREON. SAID DRAWING AND/OR DATA ARE THE EXCLUSIVE PROPERTY OF IMEG AND SHALL NOT BE USED OR REPRODUCED FOR ANY OTHER PROJECT WITHOUT THE WRITTEN AUTHORIZATION OF, AND PARTICIPATION OF IMEG.
©2025 IMEG CONSULTANTS CORP.

REF. SCALE IN INCHES 0 1 2 3 — PROJECT #25004064.00

© HKS, INC.

MODEL: Autodesk Docs://2292100 Sunrise Rye Brook NY - Senior IL+AL+MC 25004MEP25_25004MEP_Central_IL_AL_MC_Building_Cv.rvt
PRINT DATE: 7/15/2026 12:35:37 PM TEMPLATE VERSION: 23.0.4

NORTHERN WOLVES AC - VALUE ENGINEERING MARK-UP Rev 0 10/27/2026

Sheet M2013 (GMP set 07.15.2026). For discussion - not a design document.

CANCEL VAV (5): Cancel VAV box (open area / circulation). Branch duct stays with manual volume damper, balanced to design max CFM; area served directly by the RTU (RTU space sensor here). Gas heat from the RTU.

KEEP VAV - ELEC. REHEAT (8): Keep VAV box. Electric reheat coil with SCR in lieu of hot water coil; simple standalone thermostat. No hot water piping or control valve.

KEYNOTES:
1. 6" DRYER EXHAUST UP
2. FIRE RATED CHIMNEY ENCLOSURE REQUIRED FROM BASEMENT CEILING TO ROOF



1 ASSISTED LIVING FIRST FLOOR PLAN - MECHANICAL AL AREA D

1/8" = 1'-0"

NORTH

ARCHITECT
HKS ARCHITECTS, P.C.
30 WEST 26th STREET, 12th FLOOR
NEW YORK, NY 10010

STRUCTURAL
IMEG
1411 BROADWAY, SUITE 600
NEW YORK, NY 10018

MEP ENGINEER
IMEG
177 CROSSWAYS PARK DRIVE
WOODBURY, NY 11797

LV ENGINEER
TAZERDY
7653 HICKORY FLAT HWY, SUITE 200
WOODSTOCK, GA 301888

LANDSCAPE ARCHITECT
MPFP
120 BROADWAY, 20TH FLOOR
NEW YORK, NY 10271

POOL DESIGNER
COUNSILMAN-HUNSAKER & ASSOCIATES, INC.
12851 MANCHESTER ROAD, SUITE 120
ST. LOUIS, MO 63131

FOOD SERVICE & LAUNDRY
CLARK
2551 HORSESHOE RD.
LANCASTER, PA 17601

SUNRISE SENIOR LIVING

RYE BROOK


PROJECT ADDRESS: 900 King St, Rye Brook, NY 10573

DOB BSCAN | DOB STAMP & SIGNATURES

SEAL & SIGNATURE

CON NO.: 111AAA

KEY PLAN

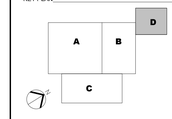

REVISION

NO.	DESCRIPTION	DATE
1	DD Progress Print	09/26/25
2	DESIGN DEVELOPMENT	11/25/25
3	EXTERIOR BUILDING PERMIT	12/23/25
4	100% DESIGN DEVELOPMENT	01/30/26
5	ISSUED FOR PERMIT	06/05/26

HKS PROJECT NUMBER
25004064.00

DATE
07/15/26

ISSUE
ISSUED FOR GMP

SHEET TITLE
ASSISTED LIVING FIRST FLOOR PLAN - MECHANICAL AL AREA D

SHEET NO.
M2013

DOB FILE #: _____ DOB PAGE #: _____

IMEG
177 CROSSWAYS PARK DRIVE
WOODBURY, NY 11797
P 516.827.4900
www.imegcorp.com

IMEG RESERVES PROPRIETARY RIGHTS, INCLUDING COPYRIGHTS, TO THIS DRAWING AND THE DATA SHOWN THEREON. SAID DRAWING AND/OR DATA ARE THE EXCLUSIVE PROPERTY OF IMEG AND SHALL NOT BE USED OR REPRODUCED FOR ANY OTHER PROJECT WITHOUT THE EXPRESS WRITTEN APPROVAL AND PARTICIPATION OF IMEG.
©2025 IMEG CONSULTANTS CORP.

REF. SCALE IN INCHES — PROJECT 425004064.00


© HKS, INC.

PRINT DATE: 7/15/2026 12:36:51 PM TEMPLATE VERSION: 23.0.4
MODEL: Autodesk Docs://2992-000 Sunrise Rye Brook NY - Senior Living AC - 2025/M/P/25_25004064.00_IL AL Building_C.rvt

NORTHERN WOLVES AC - VALUE ENGINEERING MARK-UP Rev 0 10/27/2026

Sheet M2000 (GMP set 07.15.2026). For discussion - not a design document.

DELETE FCU - ELEC. UNIT HEATER (2): Delete hot water / glycol FCU. Electric unit heater with integral thermostat. DOAS branch duct extended directly to the room diffuser; return grille deleted.

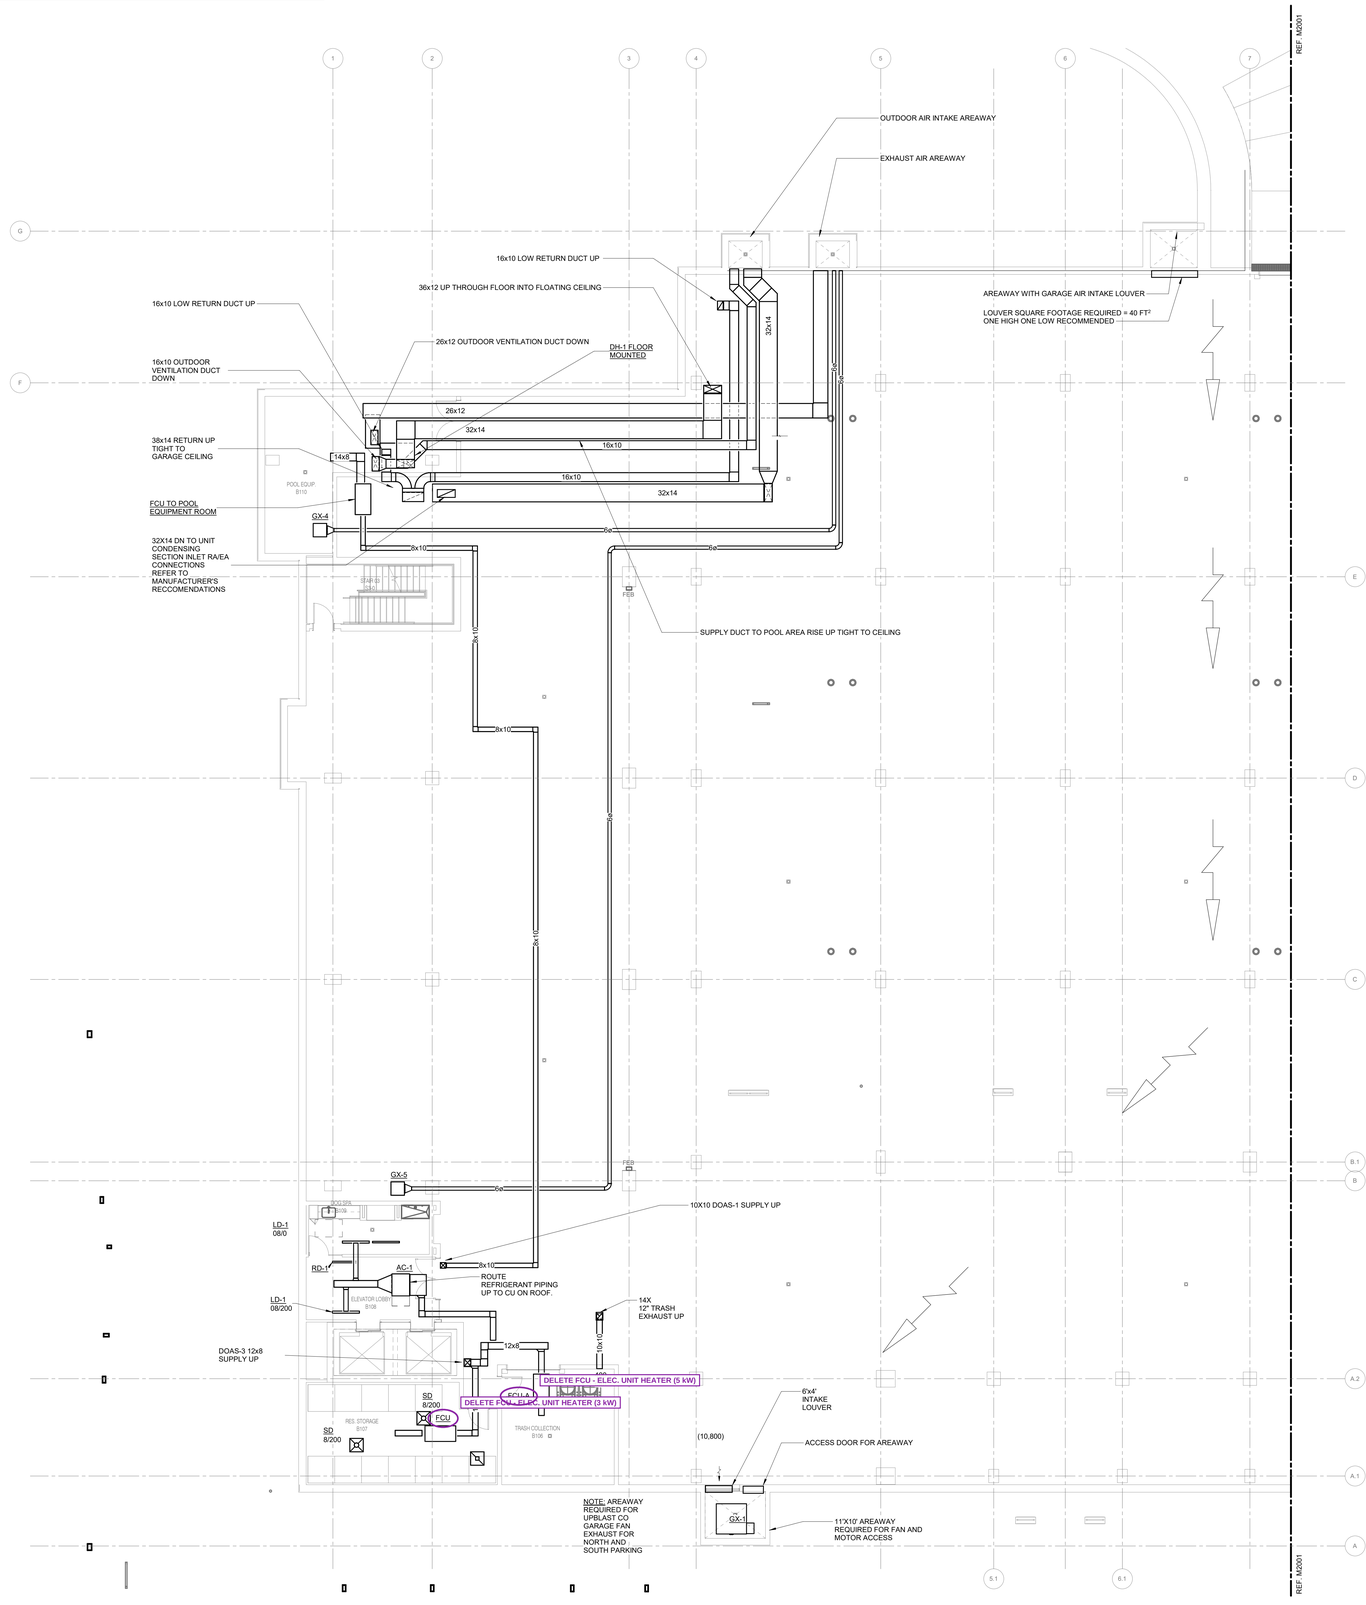

1 INDEPENDENT LIVING BASEMENT PLAN - MECHANICAL

1/8" = 1'-0"

HKS

ARCHITECT
HKS ARCHITECTS, P.C.
30 WEST 26th STREET, 12th FLOOR
NEW YORK, NY 10010

STRUCTURAL
IMEG
1411 BROADWAY, SUITE 600
NEW YORK, NY 10018

MEP ENGINEER
IMEG
177 CROSSWAYS PARK DRIVE
WOODBURY, NY 11797

LV ENGINEER
TAZERDY
7653 HICKORY FLAT HWY, SUITE 200
WOODSTOCK, GA 301888

LANDSCAPE ARCHITECT
MPFP
120 BROADWAY, 20TH FLOOR
NEW YORK, NY 10271

POOL DESIGNER
COUNSILMAN-HUNSAKER & ASSOCIATES, INC.
12851 MANCHESTER ROAD, SUITE 120
ST. LOUIS, MO 63131

FOOD SERVICE & LAUNDRY
CLARK
2551 HORSESHOE RD.
LANCASTER, PA 17601

SUNRISE SENIOR LIVING


RYE BROOK

PROJECT ADDRESS: 900 King St, Rye Brook, NY 10573

DOB BSCAN | DOB STAMP & SIGNATURES

SEAL & SIGNATURE

CON NO.: 111AAA
KEY PLAN

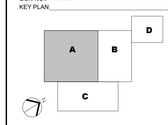

REVISION

NO.	DESCRIPTION	DATE
1	DD Progress Print	09/26/25
2	DESIGN DEVELOPMENT	11/25/25
3	EXTERIOR BUILDING PERMIT	12/23/25
4	100% DESIGN DEVELOPMENT	01/30/26
5	ISSUED FOR PERMIT	06/05/26

HKS PROJECT NUMBER
25004064.00

DATE
07/15/26

ISSUE
ISSUED FOR GMP

SHEET TITLE
INDEPENDENT LIVING BASEMENT PLAN - MECHANICAL

SHEET NO.
M2000

DOB FILE #: _____ DOB PAGE #: _____

IMEG
177 CROSSWAYS PARK DRIVE
WOODBURY, NY 11797
P: 516.827.4900
www.imegcorp.com

IMEG RESERVES PROPRIETARY RIGHTS, INCLUDING COPYRIGHTS, TO THIS DRAWING AND THE DATA SHOWN THEREON. SAID DRAWING AND/OR DATA ARE THE EXCLUSIVE PROPERTY OF IMEG AND SHALL NOT BE USED IN WHOLE OR IN PART FOR ANY OTHER PROJECT WITHOUT THE EXPRESS WRITTEN APPROVAL AND PARTICIPATION OF IMEG.
©2025 IMEG CONSULTANTS CORP.

REF. SCALE IN INCHES 0 1 2 3 — PROJECT #25004064.00

© HKS, INC.

PRINT DATE: 7/15/2026 12:25:18 PM TEMPLATE VERSION 23.0.4
MODEL: Autodesk Docs://2702.000 - Sunrise Rye Brook NY - Senior & AL-MC - 2024/MEP25_25004064.03_IL-AL Building_C.rvt

NORTHERN WOLVES AC - VALUE ENGINEERING MARK-UP Rev 0 10/27/2026


Sheet M2002 (GMP set 07.15.2026). For discussion - not a design document.

DELETE FCU - ELEC. UNIT HEATER (7): Delete hot water / glycol FCU. Electric unit heater with integral thermostat. DOAS branch duct extended directly to the room diffuser; return grille deleted.

DELETE FCU (2): Delete FCU; no heater in this scope.

DELETE - BOILERS 3 TO 2 (1): Boilers reduced from three to two; B-3 deleted, B-1 and B-2 remain.

DELETE PUMP (4): Boiler pumps BP-1 / BP-2 and primary pumps PP-1 / PP-2 deleted.

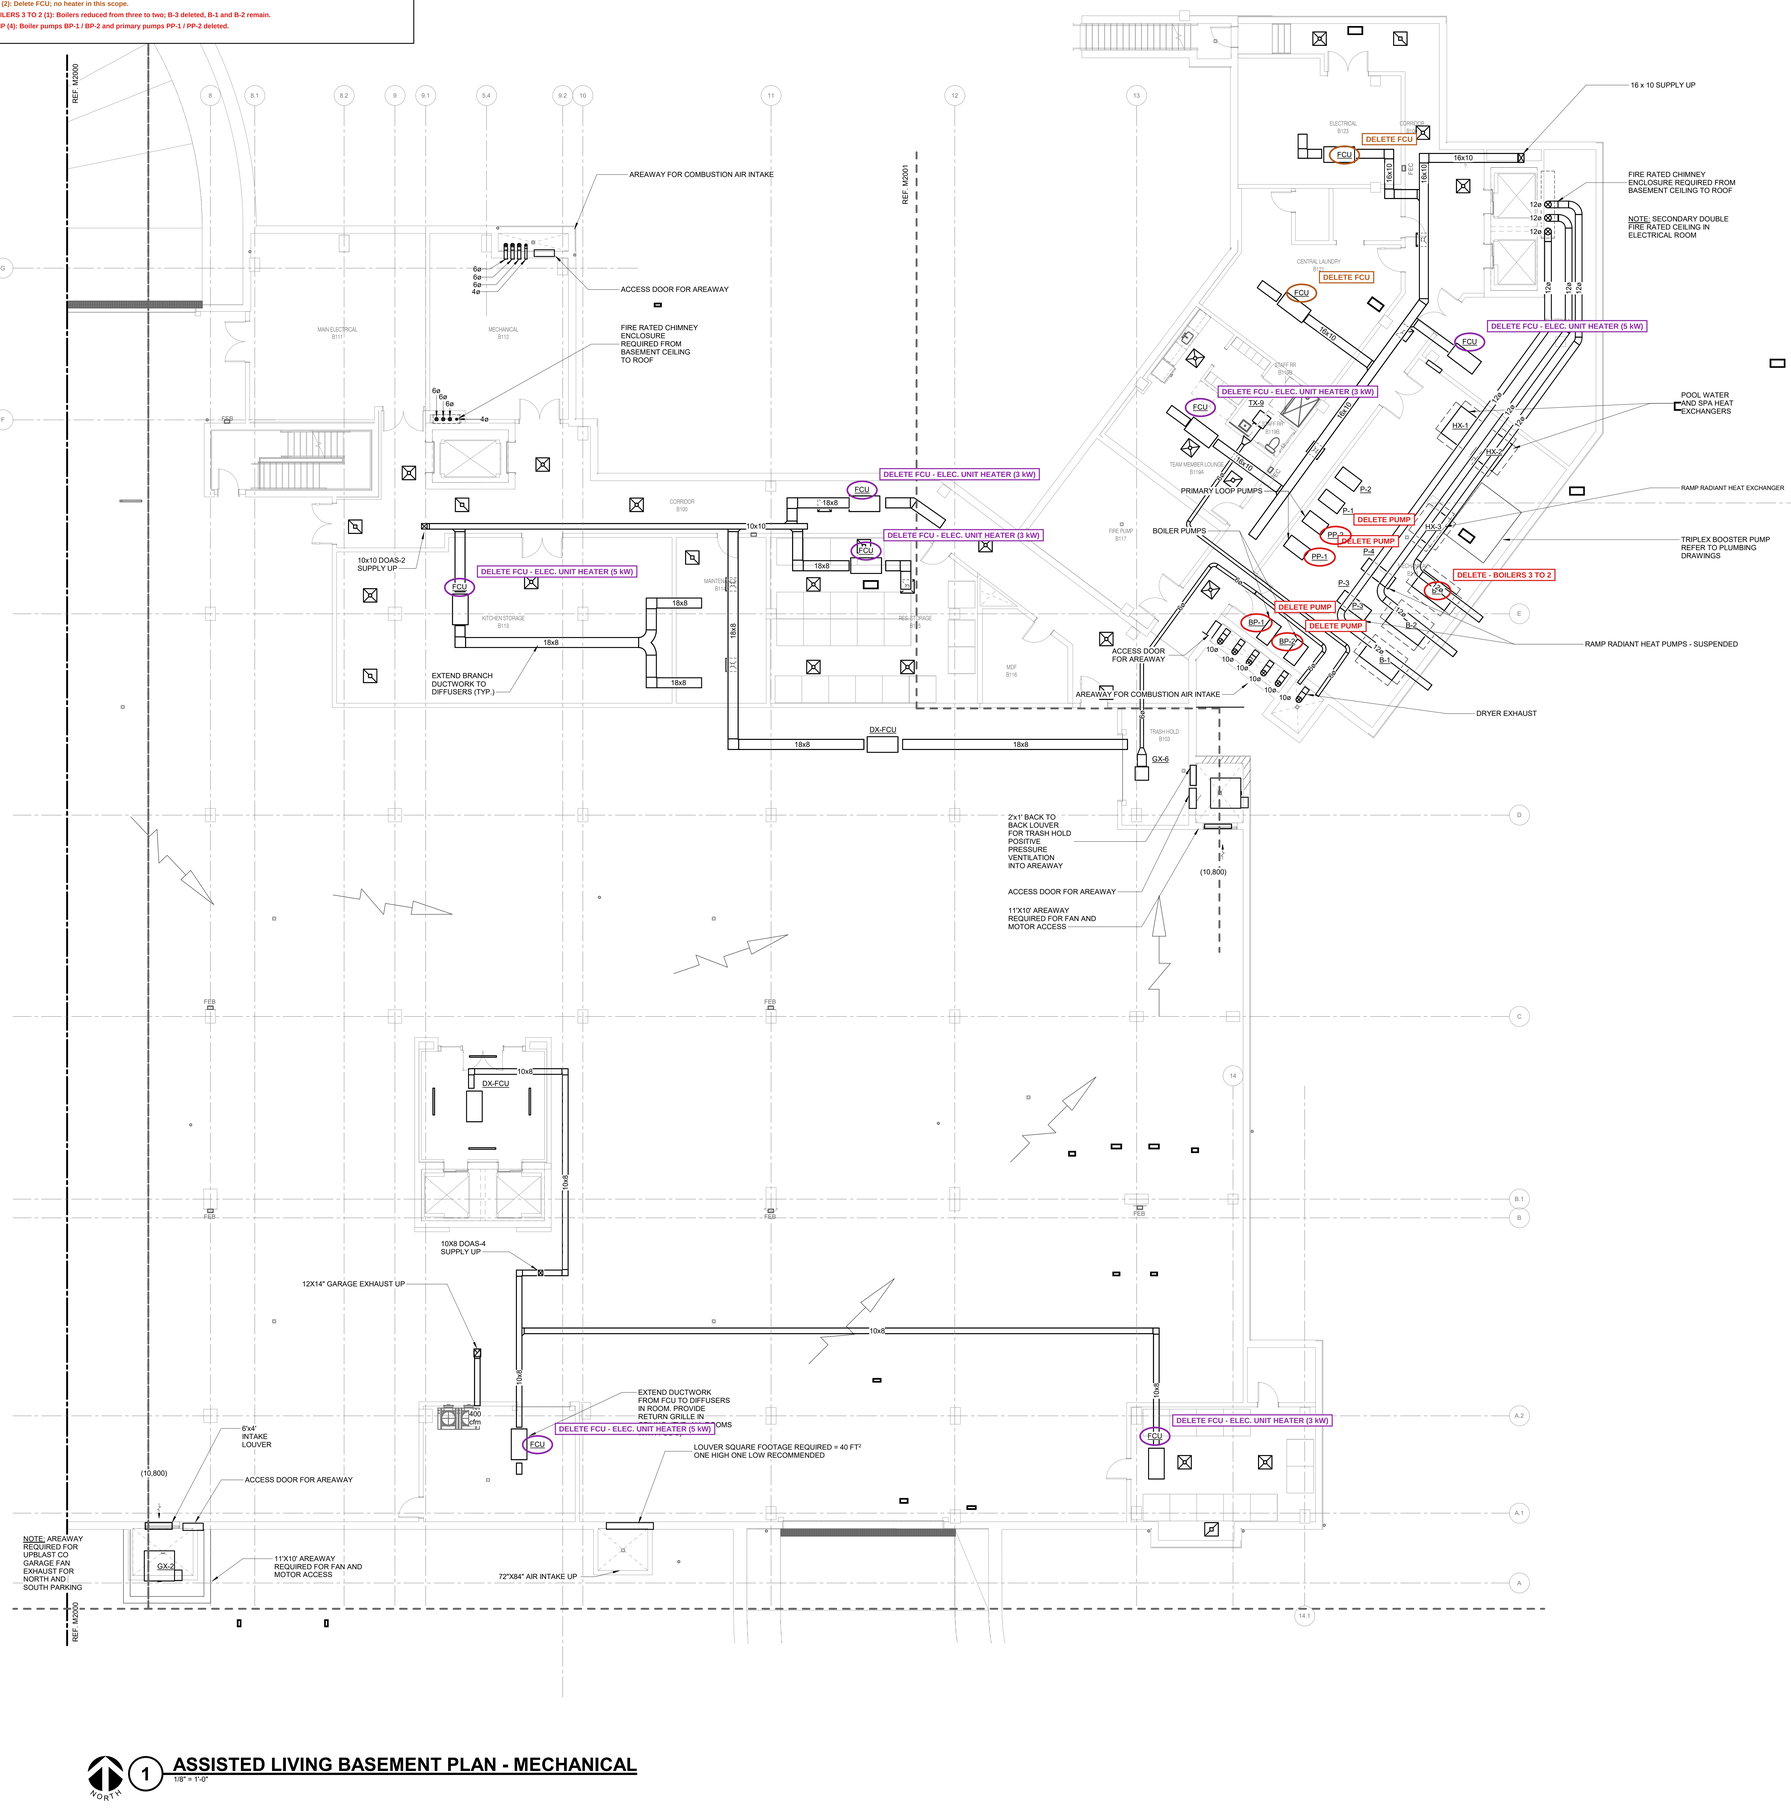

1 ASSISTED LIVING BASEMENT PLAN - MECHANICAL

1/8" = 1'-0"

NORTH

ARCHITECT
HKS ARCHITECTS, P.C.
30 WEST 26th STREET, 12th FLOOR
NEW YORK, NY 10010

STRUCTURAL
IMEG
1411 BROADWAY, SUITE 600
NEW YORK, NY 10018

MEP ENGINEER
IMEG
177 CROSSWAYS PARK DRIVE
WOODBURY, NY 11797

LV ENGINEER
TAZERDY
7653 HICKORY FLAT HWY, SUITE 200
WOODSTOCK, GA 301888

LANDSCAPE ARCHITECT
MPFP
120 BROADWAY, 20TH FLOOR
NEW YORK, NY 10271

POOL DESIGNER
COUNSILMAN-HUNSAKER & ASSOCIATES, INC.
12851 MANCHESTER ROAD, SUITE 120
ST. LOUIS, MO 63131

FOOD SERVICE & LAUNDRY
CLARK
2551 HORSESHOE RD.
LANCASTER, PA 17601

SUNRISE SENIOR LIVING

RYE BROOK


PROJECT ADDRESS: 900 King St, Rye Brook, NY 10573

DOB BSCAN | DOB STAMP & SIGNATURES

SEAL & SIGNATURE

CON NO.: 111AAA

KEY PLAN

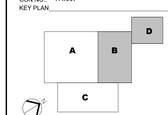

REVISION

NO	DESCRIPTION	DATE
1	DD Progress Print	09/26/25
2	DESIGN DEVELOPMENT	11/25/25
3	EXTERIOR BUILDING PERMIT	12/23/25
4	100% DESIGN DEVELOPMENT	01/30/26
5	ISSUED FOR PERMIT	06/05/26

HKS PROJECT NUMBER
25004064.00

DATE
07/15/26

ISSUE
ISSUED FOR GMP

SHEET TITLE
ASSISTED LIVING BASEMENT PLAN - MECHANICAL

SHEET NO.
M2002

DOB FILE #: _____ DOB PAGE #: _____

IMEG
www.imegcorp.com
177 CROSSWAYS PARK DRIVE
WOODBURY, NY 11797
P: 516.827.4900

IMEG RESERVES PROPRIETARY RIGHTS, INCLUDING COPYRIGHTS, TO THIS DRAWING AND THE DATA SHOWN THEREON. SAID DRAWING AND/OR DATA ARE THE EXCLUSIVE PROPERTY OF IMEG AND SHALL NOT BE USED OR REPRODUCED FOR ANY OTHER PROJECT WITHOUT THE EXPRESS WRITTEN APPROVAL AND PARTICIPATION OF IMEG.
©2025 IMEG CONSULTANTS CORP.

0 1 2 3
REF. SCALE IN INCHES
PROJECT #25004064.00

© HKS, INC.

PRINT DATE: 7/15/2026 12:25:28 PM TEMPLATE VERSION: 23.0.4
MODEL: Autodesk Docs://7292.000_Sunrise Rye Brook NY_Senior & ALMC_2025/M/EP25_25004064.00_E-AL Building_C.rvt

TITLE BLOCK VERSION: 20210630

VE: HOT WATER PIPING ON THIS SHEET DELETED (VAV REHEAT AND CABINET HEATERS CHANGED TO ELECTRIC). SEE M2010 / M2011 / M2013 FOR VAV AND HEATER CHANGES.



1 INDEPENDENT LIVING FIRST FLOOR PLAN - MECHANICAL PIPING IL AREA A

1/8" = 1'-0"

NORTH

ARCHITECT
HKS ARCHITECTS, P.C.
30 WEST 26th STREET, 12th FLOOR
NEW YORK, NY 10010

STRUCTURAL
IMEG
1411 BROADWAY, SUITE 600
NEW YORK, NY 10018

MEP ENGINEER
IMEG
177 CROSSWAYS PARK DRIVE
WOODBURY, NY 11797

LV ENGINEER
TAZERDY
7653 HICKORY FLAT HWY, SUITE 200
WOODSTOCK, GA 301888

LANDSCAPE ARCHITECT
MPFP
120 BROADWAY, 20TH FLOOR
NEW YORK, NY 10271

POOL DESIGNER
COUNSILMAN-HUNSAKER & ASSOCIATES, INC.
12851 MANCHESTER ROAD, SUITE 120
ST. LOUIS, MO 63131

FOOD SERVICE & LAUNDRY
CLARK
2551 HORSESHOE RD.
LANCASTER, PA 17601

SUNRISE SENIOR LIVING

RYE BROOK

PROJECT ADRESS: 900 King St, Rye Brook, NY 10573

DOB BSCAN | DOB STAMP & SIGNATURES

SEAL & SIGNATURE

CON NO.: 111AAA
KEY PLAN

REVISION

NO.	DESCRIPTION	DATE
1	DD Progress Print	09/26/25
2	DESIGN DEVELOPMENT	11/25/25
3	EXTERIOR BUILDING PERMIT	12/23/25
4	100% DESIGN DEVELOPMENT	01/30/26
5	ISSUED FOR PERMIT	06/05/26

HKS PROJECT NUMBER
25004064.00
DATE
07/15/26
ISSUE
ISSUED FOR GMP

SHEET TITLE
INDEPENDENT LIVING FIRST FLOOR PLAN - MECHANICAL PIPING IL AREA A

M2014

DOB FILE #:_____ DOB PAGE #:_____

IMEG
177 CROSSWAYS PARK DRIVE
WOODBURY, NY 11797
P: 516.827.4900
www.imegcorp.com

IMEG RESERVES PROPRIETARY RIGHTS, INCLUDING COPYRIGHTS, TO THIS DRAWING AND THE DATA SHOWN THEREON. SAID DRAWING AND/OR DATA ARE THE EXCLUSIVE PROPERTY OF IMEG AND SHALL NOT BE USED OR REPRODUCED FOR ANY OTHER PROJECT WITHOUT THE EXPRESS WRITTEN APPROVAL AND PARTICIPATION OF IMEG.
©2025 IMEG CONSULTANTS CORP.

REF. SCALE IN INCHES 0 1 2 3

PROJECT #25004064.00


© HKS, INC.

PRINT DATE: 7/15/2026 12:26:05 PM - TEMPLATE VERSION: 23.0.4
MODEL: Autodesk Docs://7502-205_Sunrise Rye Brook NY - Senior & IL/MC_2025MEP25_25004064.00_C4L Building C.rvt

TITLE BLOCK VERSION: 20210630

REF. M2010

VE: HOT WATER PIPING ON THIS SHEET DELETED (VAV REHEAT AND CABINET HEATERS CHANGED TO ELECTRIC). SEE M2010 / M2011 / M2013 FOR VAV AND HEATER CHANGES.

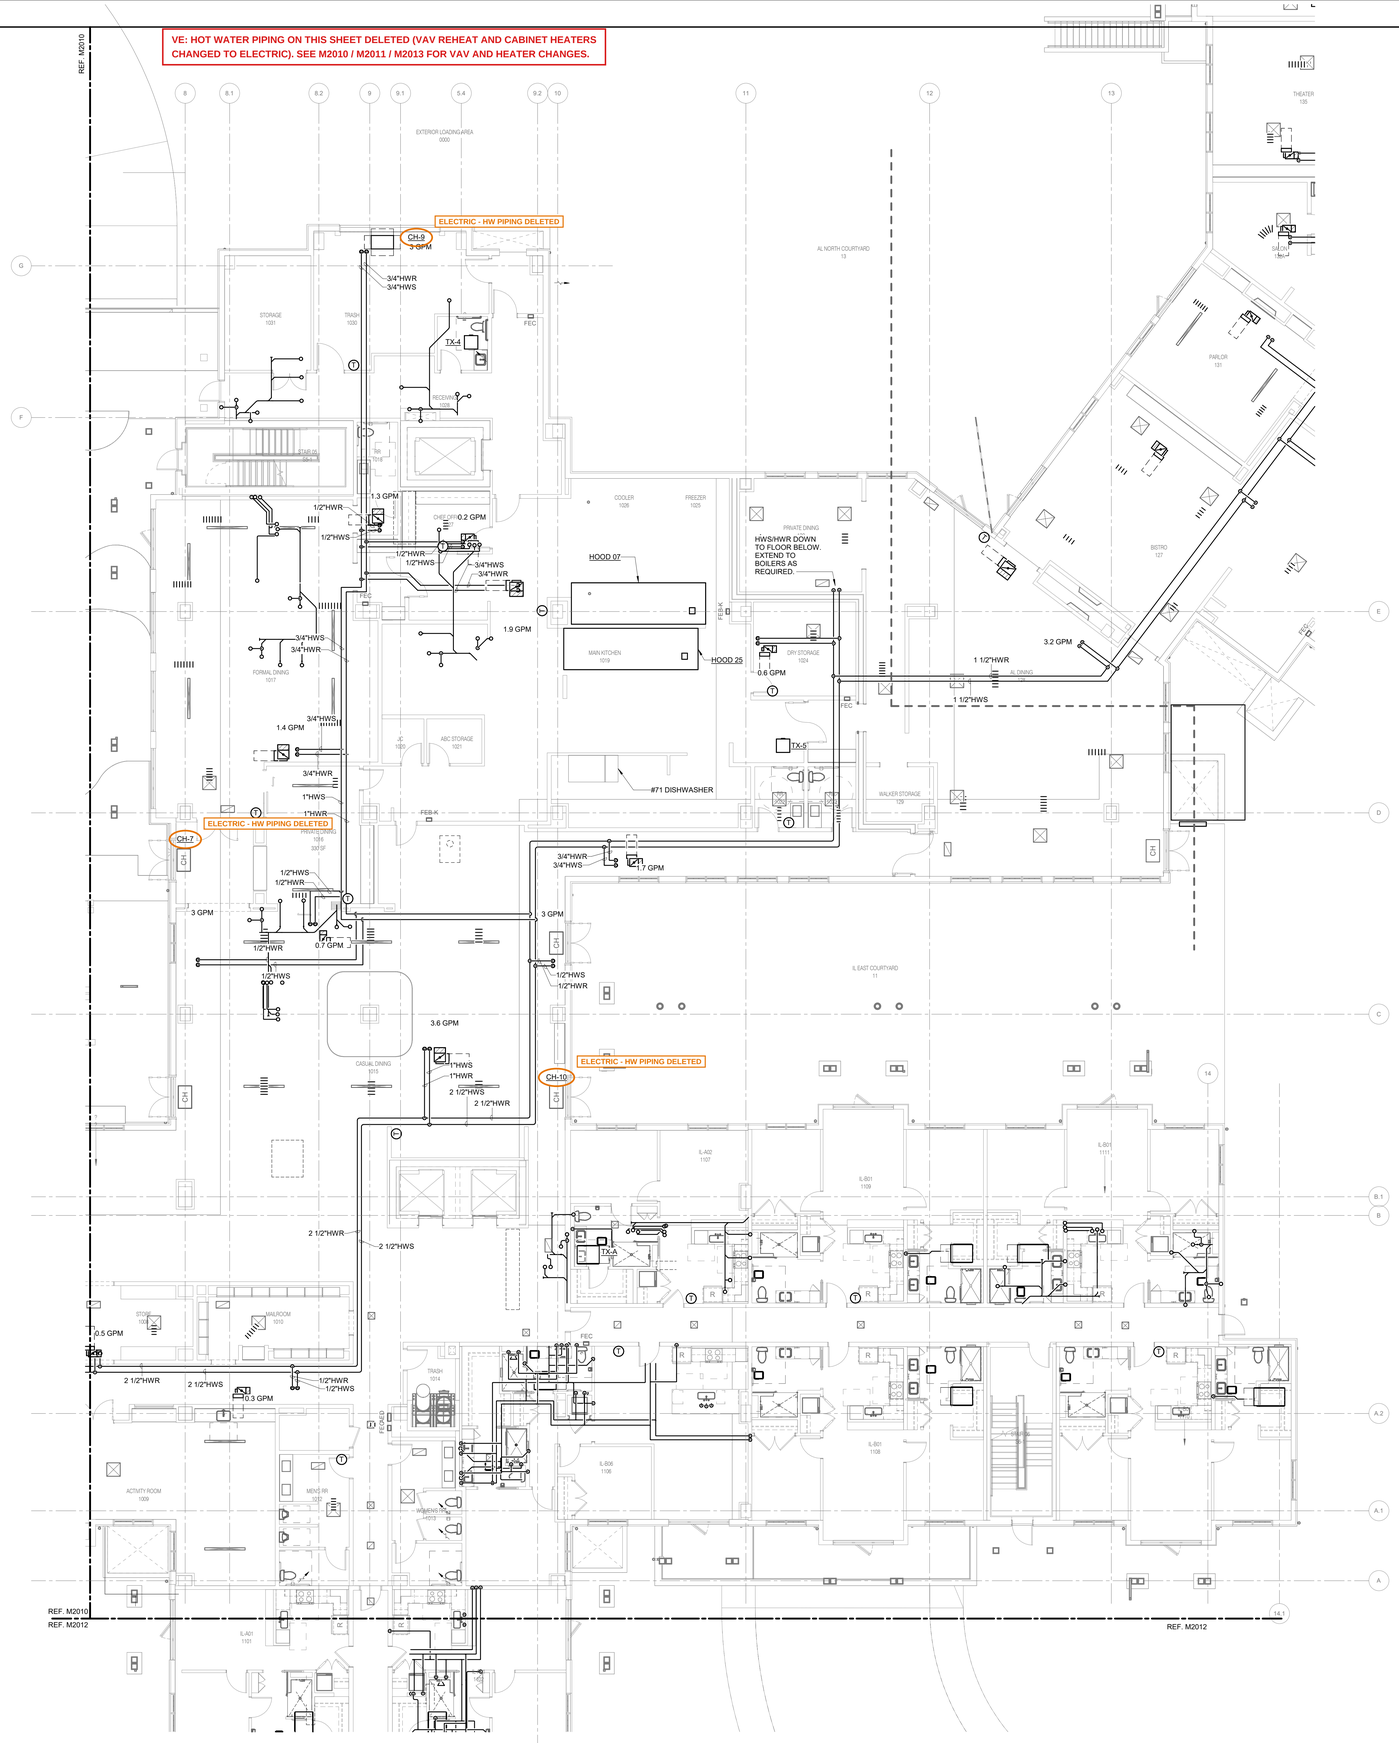

1 INDEPENDENT LIVING FIRST FLOOR PLAN - MECHANICAL PIPING IL AREA B

1/8" = 1'-0"

NORTH

ARCHITECT
HKS ARCHITECTS, P.C.
30 WEST 26th STREET, 12th FLOOR
NEW YORK, NY 10010

STRUCTURAL
IMEG
1411 BROADWAY, SUITE 600
NEW YORK, NY 10018

MEP ENGINEER
IMEG
177 CROSSWAYS PARK DRIVE
WOODBURY, NY 11797

LV ENGINEER
TAZERDY
7653 HICKORY FLAT HWY, SUITE 200
WOODSTOCK, GA 301888

LANDSCAPE ARCHITECT
MPFP
120 BROADWAY, 20TH FLOOR
NEW YORK, NY 10271

POOL DESIGNER
COUNSILMAN-HUNSAKER & ASSOCIATES, INC.
12651 MANCHESTER ROAD, SUITE 120
ST. LOUIS, MO 63131

FOOD SERVICE & LAUNDRY
CLARK
2551 HORSESHOE RD.
LANCASTER, PA 17601

SUNRISE SENIOR LIVING


RYE BROOK

PROJECT ADDRESS: 900 King St, Rye Brook, NY 10573

DOB BSCAN | DOB STAMP & SIGNATURES

SEAL & SIGNATURE

CON NO.: 111AAA
KEY PLAN

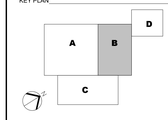

REVISION

NO.	DESCRIPTION	DATE
1	DD Progress Print	09/26/25
2	DESIGN DEVELOPMENT	11/25/25
3	EXTERIOR BUILDING PERMIT	12/23/25
4	100% DESIGN DEVELOPMENT	01/30/26
5	ISSUED FOR PERMIT	06/05/26

HKS PROJECT NUMBER
25004064.00

DATE
07/15/26

ISSUE
ISSUED FOR GMP

SHEET TITLE
INDEPENDENT LIVING FIRST FLOOR PLAN - MECHANICAL PIPING IL AREA B

M2015

DOB FILE #: _____ DOB PAGE #: _____

IMEG
177 CROSSWAYS PARK DRIVE
WOODBURY, NY 11797
P: 516.827.4900
www.imegcorp.com

IMEG RESERVES PROPRIETARY RIGHTS, INCLUDING COPYRIGHTS, TO THIS DRAWING AND THE DATA SHOWN THEREON. SAID DRAWING AND/OR DATA ARE THE EXCLUSIVE PROPERTY OF IMEG AND SHALL NOT BE USED OR REPRODUCED FOR ANY OTHER PROJECT WITHOUT THE EXPRESS WRITTEN APPROVAL AND PARTICIPATION OF IMEG.
©2025 IMEG CONSULTANTS CORP.

0 1 2 3
REF. SCALE IN INCHES
PROJECT #25004064.00

© HKS, INC.

PRINT DATE: 7/15/2026 12:27:15 PM TEMPLATE VERSION: 23.0.4 MODEL: Autodesk Docs://2025/25004064.00_Sunrise Rye Brook NY - Senior IL (A, MC, 2025)/MEP25_25004064.00_IL_Building_Civil

TITLE BLOCK VERSION: 20210930

VE: HOT WATER PIPING ON THIS SHEET DELETED (VAV REHEAT AND CABINET HEATERS CHANGED TO ELECTRIC). SEE M2010 / M2011 / M2013 FOR VAV AND HEATER CHANGES.



1 ASSISTED LIVING FIRST FLOOR PLAN - MECHANICAL AL AREA D Copy 2

1/8" = 1'-0"

NORTH

ARCHITECT
HKS ARCHITECTS, P.C.
30 WEST 26th STREET, 12th FLOOR
NEW YORK, NY 10010

STRUCTURAL
IMEG
1411 BROADWAY, SUITE 600
NEW YORK, NY 10018

MEP ENGINEER
IMEG
177 CROSSWAYS PARK DRIVE
WOODBURY, NY 11797

LV ENGINEER
TAZERDY
7653 HICKORY FLAT HWY, SUITE 200
WOODSTOCK, GA 301888

LANDSCAPE ARCHITECT
MPFP
120 BROADWAY, 20TH FLOOR
NEW YORK, NY 10271

POOL DESIGNER
COUNSILMAN-HUNSAKER & ASSOCIATES, INC.
12851 MANCHESTER ROAD, SUITE 120
ST. LOUIS, MO 63131

FOOD SERVICE & LAUNDRY
CLARK
2551 HORSESHOE RD.
LANCASTER, PA 17601

SUNRISE SENIOR LIVING


RYE BROOK

PROJECT ADDRESS: 900 King St, Rye Brook, NY 10573

DOB BSCAN | DOB STAMP & SIGNATURES

SEAL & SIGNATURE

CON NO.: 111AAA
KEY PLAN

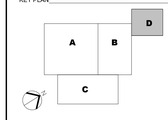

REVISION

NO.	DESCRIPTION	DATE
1	DD Progress Print	09/26/25
2	DESIGN DEVELOPMENT	11/25/25
3	EXTERIOR BUILDING PERMIT	12/23/25
4	100% DESIGN DEVELOPMENT	01/30/26
5	ISSUED FOR PERMIT	06/05/26

HKS PROJECT NUMBER
25004064.00

DATE
07/15/26

ISSUE
ISSUED FOR GMP

SHEET TITLE
ASSISTED LIVING FIRST FLOOR PLAN - MECHANICAL PIPING AL AREA D

M2016

DOB FILE #: _____ DOB PAGE #: _____

IMEG
177 CROSSWAYS PARK DRIVE
WOODBURY, NY 11797
P: 516.827.4900
www.imegcorp.com

IMEG RESERVES PROPRIETARY RIGHTS, INCLUDING COPYRIGHTS, TO THIS DRAWING AND THE DATA SHOWN THEREON. SAID DRAWING AND DATA SHALL NOT BE USED IN WHOLE OR IN PART AND SHALL NOT BE USED OR REPRODUCED FOR ANY OTHER PROJECT WITHOUT THE EXPRESS WRITTEN APPROVAL AND PARTICIPATION OF IMEG.
©2025 IMEG CONSULTANTS CORP.

REF. SCALE IN INCHES 0 1 2 3 — PROJECT #25004064.00

© HKS, INC.

PRINT DATE: 7/15/2026 12:37:19 PM - TEMPLATE VERSION: 23.3.4 - MODEL: Autodesk Docs://2302.000 Sunrise Rye Brook NY - Senior S, AL,MC_25004064.05_S_AL Building_C.rvt