NORTHERN WOLVES
AIR CONDITIONING

SUBMITTAL

TRANSMITTAL / COVER LETTER

No. 032 Rev. 3 Date 10/14/2026

PROJECT

PROJECT
Seafarers International 18 Vesey Street

PROJECT / CONTRACT NO.
30-26004

ADDRESS
18 Vesey Street, New York, NY 10007

OWNER / CUSTOMER
KBD Group

ARCHITECT / ENGINEER
—

PROJECT MANAGER
Whitney Bynoe

TO / FROM

SUBMITTED TO
KBD Group
70 Grand Ave., Suite 105, River Edge, NJ 07661

SUBMITTED BY
Northern Wolves Air Conditioning
Fatima Moutchou
55 9th Street, Unit 55A-2, Brooklyn, NY 11215
fatima@northernwolvesac.com

SUBMITTAL

TITLE / EQUIPMENT
Fuel Oil Shop Drawings

SPEC SECTION
—

TYPE
Product Data

MANUFACTURER
—

MODEL / TAGS
—


ACTION REQUESTED
For Approval

ENCLOSURES


1. 18 Vesey Street_FO_Rev.03.pdf (1 page)

Northern Wolves Air Conditioning has reviewed this submittal and certifies that it complies with the contract documents, except as noted above.


REVIEWER ACTION	REVIEWER STAMP / COMMENTS
☐ No Exceptions Taken ☐ Approved as Noted ☐ Revise and Resubmit ☐ Rejected	Reviewed by: _____ Date: _____

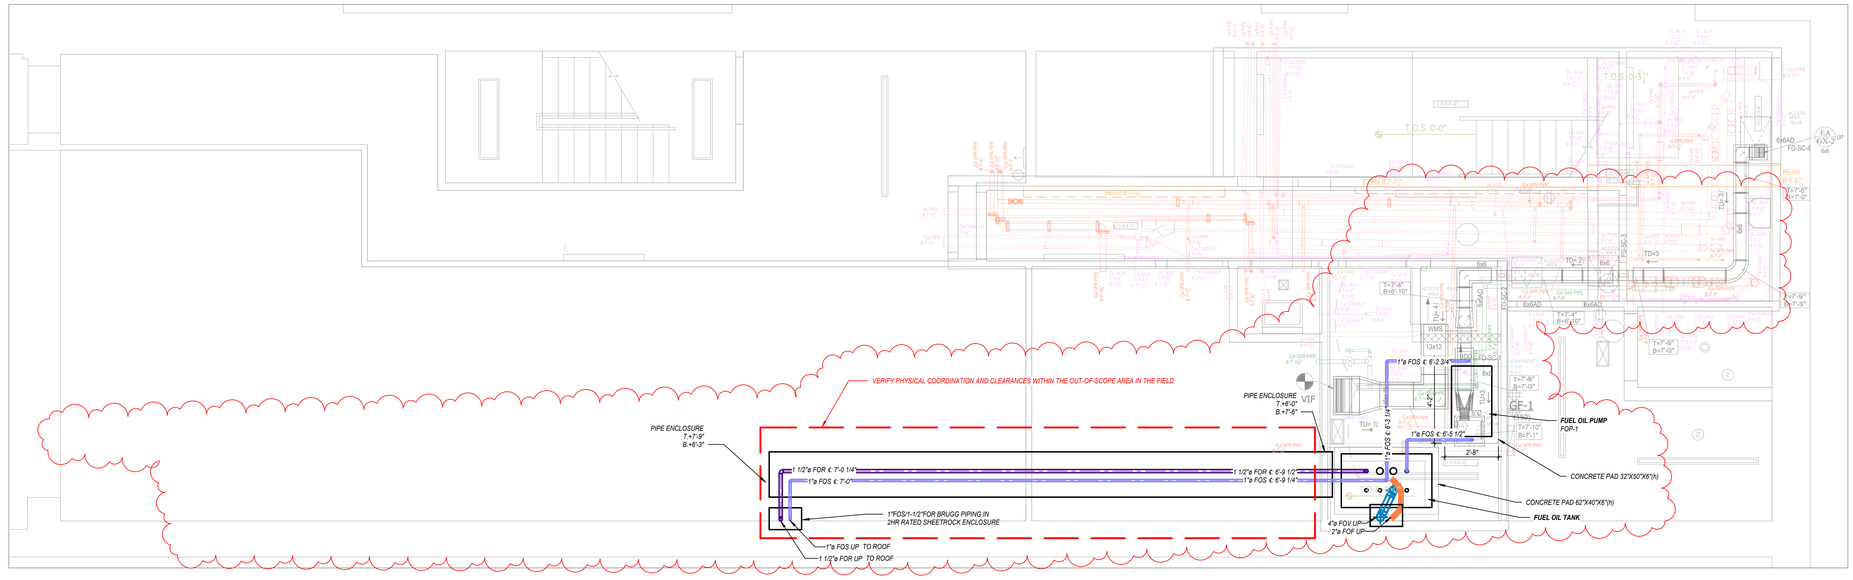


SUB-CELLAR FLOOR PLAN
3/8"=1'-0"

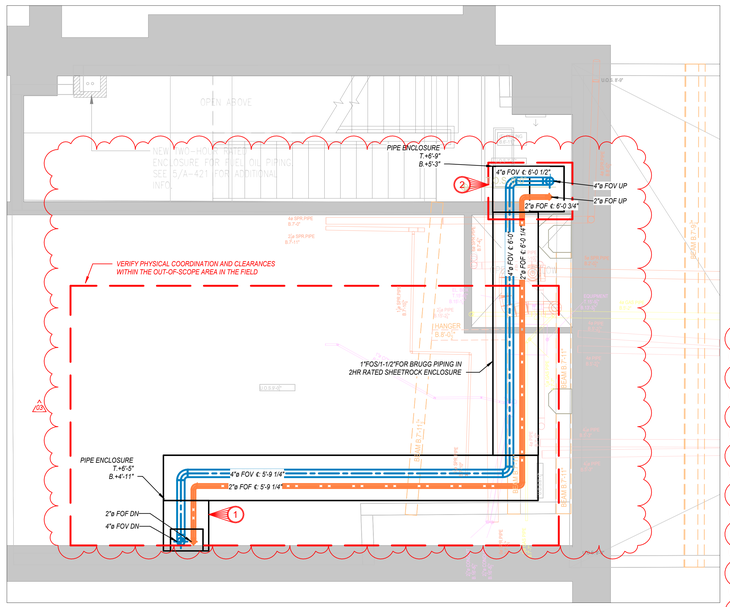


CELLAR FLOOR PLAN
3/8"=1'-0"

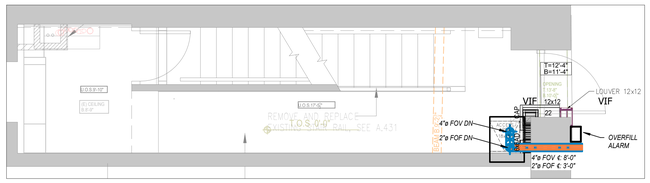


1ST FLOOR PLAN
3/8"=1'-0"

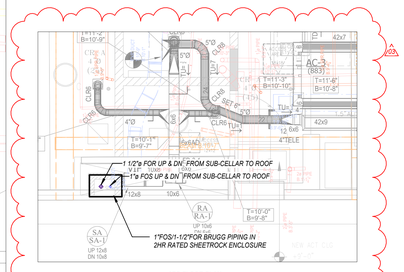


3RD FLOOR PLAN
3/8"=1'-0"

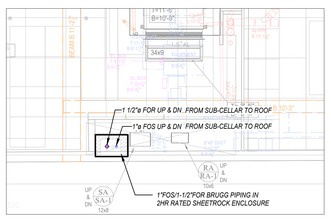


4TH FLOOR PLAN
3/8"=1'-0"

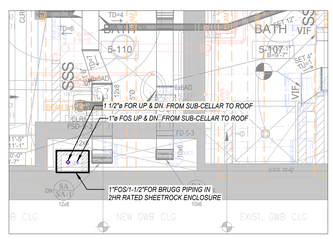

5TH FLOOR PLAN
3/8"=1'-0"

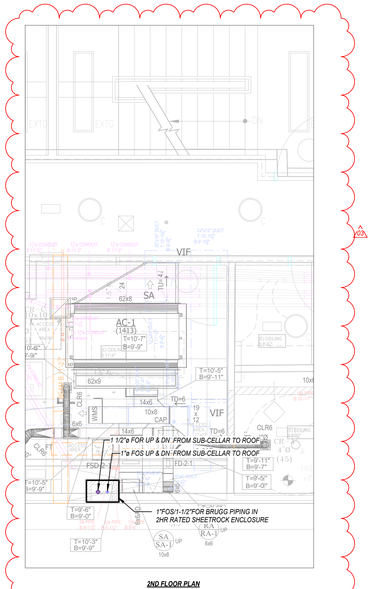

2ND FLOOR PLAN
3/8"=1'-0"

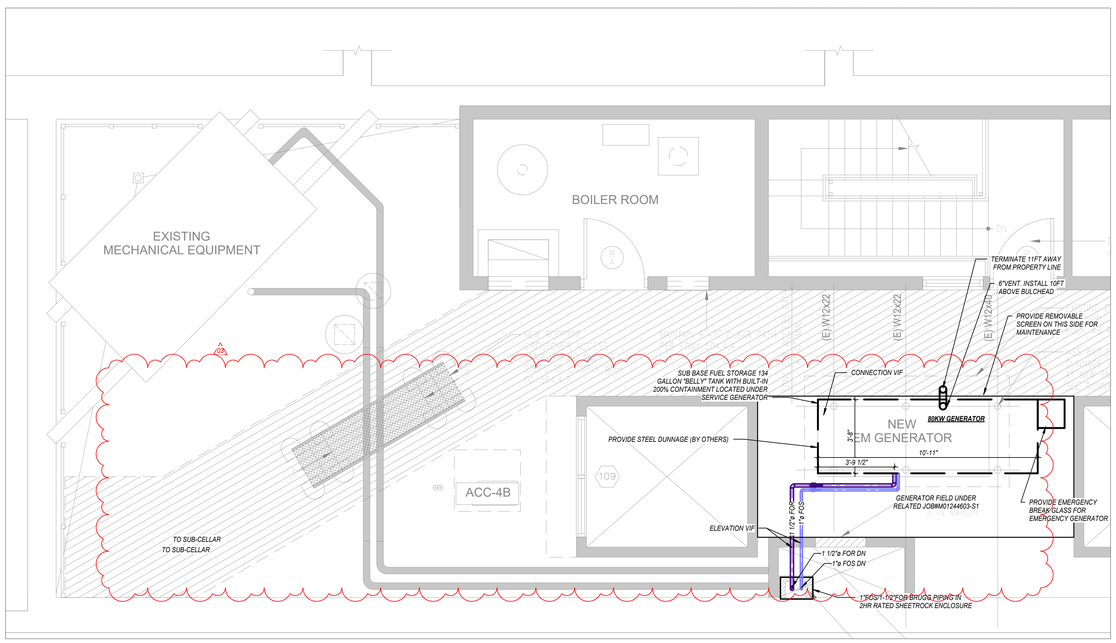

ROOF PLAN
3/8"=1'-0"

TOTAL PIPE LENGTH SCHEDULE

Size	System Abbreviation	Length
1 1/2"ø	FOR	142'-4 1/2"
1"ø	FOS	164'-6 1/2"
2"ø	FOF	93'-7 1/4"
4"ø	FOV	95'-1 3/4"

FLAGS

#	THIS SYMBOL INDICATES A QUESTION THAT REQUIRES A RESPONSE FROM THE ARCHITECT AND/OR ENGINEER. IF NOT ADDRESSED, IT WILL BE ASSUMED TO BE ACCEPTABLE AS SHOWN. CONSTRUCTION MANAGER, PLEASE ENSURE THAT ALL QUESTIONS ARE ANSWERED.
1	2HR RATED SHEETROCK ENCLOSURE FOR THE OIL PIPES IS VERY LOW (8.4'-11") DUE TO A LOT OF EXISTING SYSTEMS ABOVE. PLEASE CONFIRM ENCLOSURE ELEVATION. OTHERWISE ADVISE.
2	2HR RATED SHEETROCK ENCLOSURE FOR THE OIL PIPES IS VERY LOW (8.5'-3") DUE TO A LOT OF EXISTING SYSTEMS ABOVE. PLEASE CONFIRM ENCLOSURE ELEVATION. OTHERWISE ADVISE.

INSULATION SCHEDULE

SYSTEM TYPE	INSULATION THICKNESS

BACKGROUND LEGEND:

- EXISTING WALLS AND COLUMNS
- BEAM B.12'-0" — EXISTING BEAM WITH ELEVATION
- 4"ø SPR.PIPE B.12'-0" — EXISTING SPRINKLER PIPE WITH SIZE AND ELEVATION
- 4"ø PIPE B.12'-0" — EXISTING PIPE WITH SIZE AND ELEVATION
- 18"x8" DUCT T.13'-0" B.12'-0" — EXISTING DUCT WITH SIZE AND ELEVATION
- 4"ø CONDUIT B.12'-0" — EXISTING CONDUIT WITH SIZE AND ELEVATION
- 18"x6" CABLE TRAY B.12'-0" — EXISTING CABLE TRAY WITH SIZE AND ELEVATION
- 4"ø CONDUIT B.12'-0" — LIKELY EXISTING ELEMENT WITH SIZE AND ELEVATION

GENERAL NOTES:

1. ALL PIPE ELEVATIONS ARE FROM EXISTING CONCRETE FLOOR. PLEASE ALLOW FOR FLOOR VARIATIONS AND FINISHED FLOOR.
2. ø INDICATES PIPE DIMENSION WITHOUT INSULATION.
3. WATER PIPING SHALL SLOPE UPWARD IN THE DIRECTION OF FLOW.
4. CONDENSATE DRAIN PIPING SHALL HAVE A MINIMUM SLOPE OF 1/8" PER 1' IN THE DIRECTION OF FLOW.

SLAB ELEVATION: -	SLAB TYPE: CONCRETE	BEAMS: AS SHOWN	NO FLEX

REFERENCE DRAWINGS

DISCIPLINE	SHEET #	DESCRIPTION	DATE
MECHANICAL			
ARCHITECTURAL			
STRUCTURAL			

KEY PLAN: N

No.	DESCRIPTION	DATE
03	AS PER RETURNED DRAWING 10/6/2026	10/13/2026
02	UPDATED	9/17/2026
01	AS PER COORDINATION	9/15/2026

ISSUED FOR:

☐ APPROVAL ☐ RECORD
☒ RESUBMISSION ☐ FABRICATION

CONTRACTOR:
NORTHERN WOLVES INC

DRAFTING COMPANY:
ALL-CITY SKETCHERS, INC.
958 BRUSH HOLLOW RD,
WESTBURY, NY 11590
929-214-1022

PROJECT:
SEAFARERS INTERNATIONAL HOUSE
18 VESEY ST, NEW YORK, NY 10007

SHEET TITLE:
FUEL OIL PIPING LAYOUT

DRAWN BY: P.T.	DATE: 6/19/2026
CHECKED BY: A.K.	PROJECT #: R26-78
SCALE: 3/8" = 1'-0"	SHEET #: FO-1

A WxH: 48x36 in