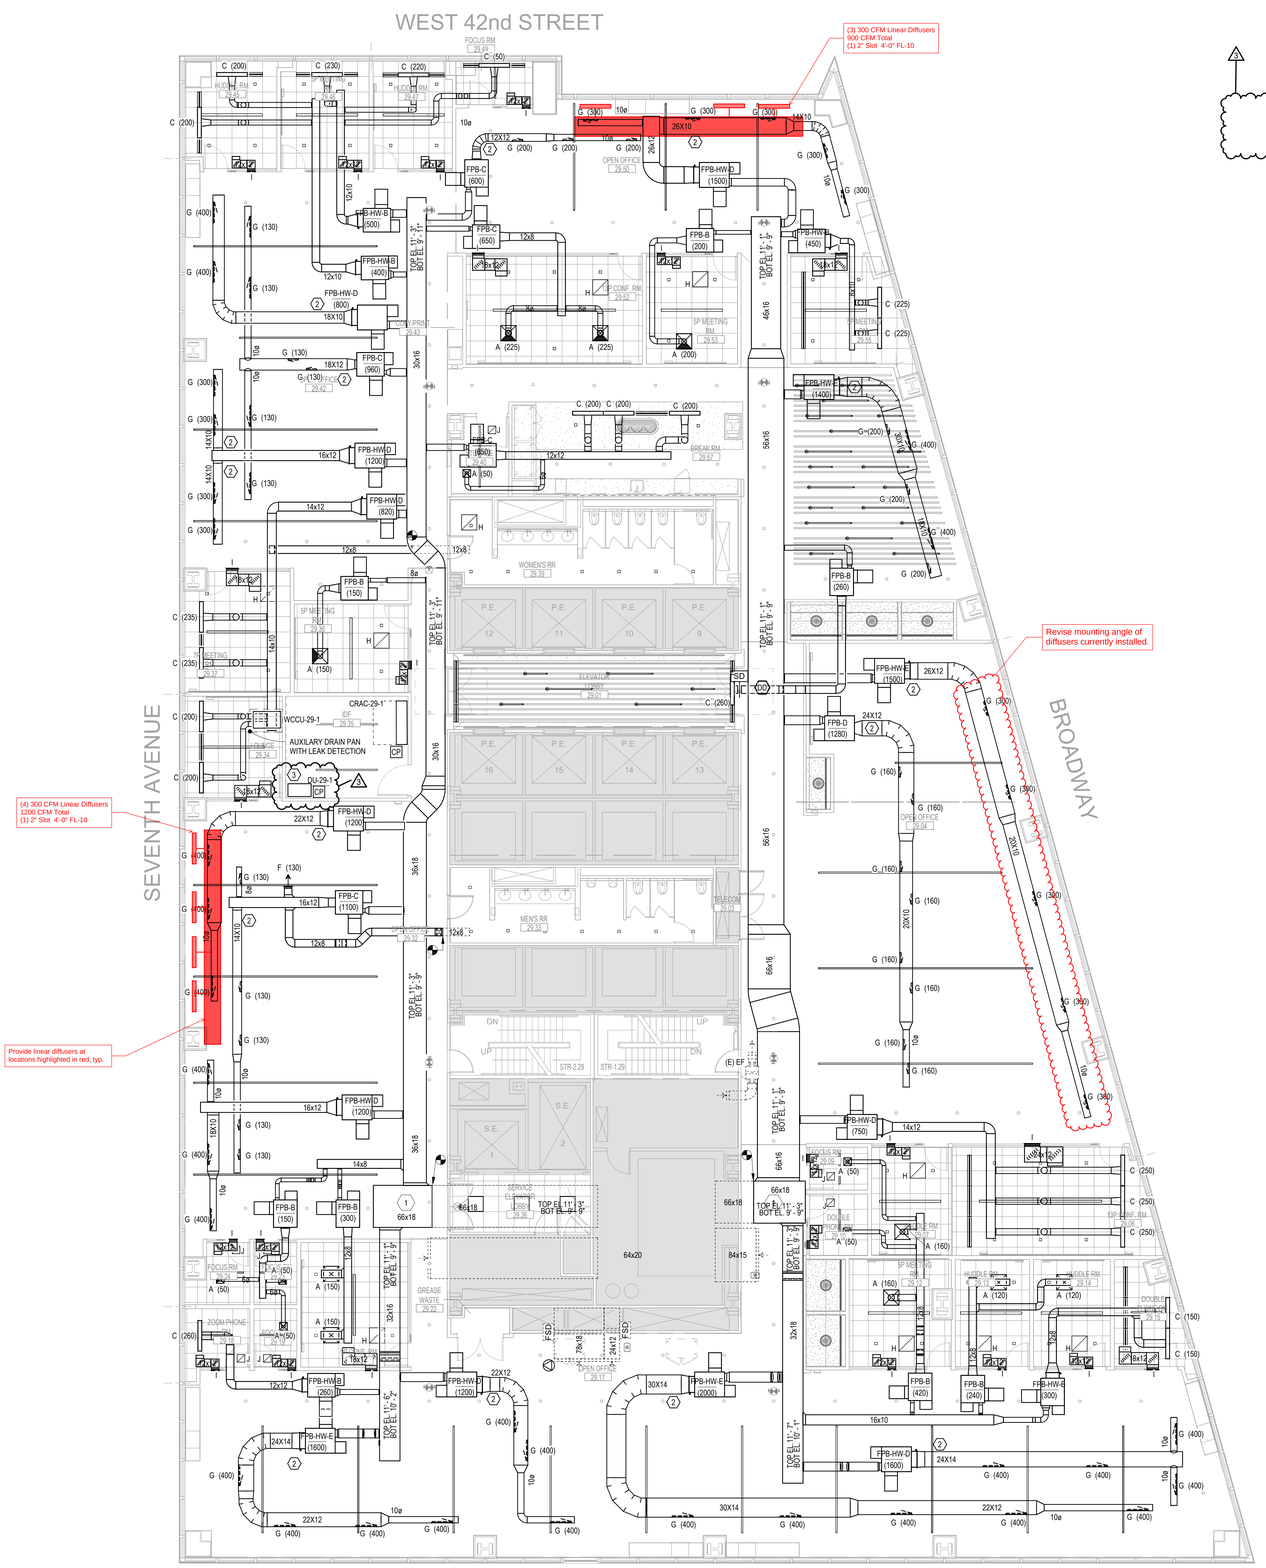


KEY NOTES

1. DUCTWORK TO BE CONSTRUCTED OF RECTANGULAR 16-GAUGE OUTER DUCT W/1" ACOUSTICAL LINING, TEDLAR LINER AND STANDARD GAUGE PERFORATED INNER DUCT TO MATCH BUILDING STANDARD FOR FAN DISCHARGE DUCTWORK.
2. EXPOSED DUCTWORK SHALL BE OVAL OR ROUND SPIRAL DUCT CONSTRUCTED OF GALVANIZED STEEL WITH ACOUSTICAL LINING AS PER SPECIFICATIONS. FABRICATE AND INSTALL AS PER SMACNA STANDARDS. WITH ALL SEAMS AIRTIGHT AND CONNECTIONS SUITABLE FOR PRESSURE CLASS, SUPPORT AND HANG DUCT PER CODE REQUIREMENTS.
3. UNIT LOCATION TO BE COORDINATED WITH IDF LAYOUT. LOCATION AND POSITIONING SHOULD ALLOW FOR ALL CLEARANCES AS SPECIFIED BY MANUFACTURER. IF CEILING HUNG, UNIT SHOULD BE VIBRATION INSULATED AS DESCRIBED FOR MECHANICAL EQUIPMENT IN SPECIFICATIONS.

MECHANICAL NOTES

1. ALL WORK SHALL CONFORM TO THE LATEST BUILDING STANDARDS. IT IS THE RESPONSIBILITY OF THE CONTRACTOR TO OBTAIN A COPY OF THE BUILDING STANDARDS AND MEET WITH BUILDING MANAGEMENT IN ORDER TO BECOME TOTALLY FAMILIAR WITH THE BUILDING CONSTRUCTION RULES. THERE SHALL BE NO DEVIATION FROM THE BUILDING STANDARDS WITHOUT PRIOR WRITTEN APPROVAL FROM THE BUILDING MANAGEMENT.
2. WHEN MECHANICAL WORK IS SUBCONTRACTED IT SHALL BE THE MECHANICAL CONTRACTORS RESPONSIBILITY TO COORDINATE SUBCONTRACTORS AND THE ASSOCIATED CONTRACTS. WHEN DISCREPANCIES ARISE PERTAINING TO WHICH CONTRACTOR PROVIDES A PARTICULAR ITEM OF THE MECHANICAL CONTRACT OR WHICH CONTRACTOR PROVIDES FINAL CONNECTIONS FOR A PARTICULAR ITEM OF THE MECHANICAL CONTRACT. IT SHALL BE BROUGHT TO THE ATTENTION OF THE MECHANICAL CONTRACTOR, WHOSE DECISION SHALL BE FINAL.
3. ALL MISCELLANEOUS STEEL REQUIRED TO ENSURE PROPER INSTALLATION AND AS SHOWN IN DETAILS FOR PIPING, DUCTWORK, AND EQUIPMENT SHALL BE FURNISHED AND INSTALLED BY THE MECHANICAL CONTRACTOR AND COORDINATED WITH THE GENERAL CONTRACTOR FOR COORDINATION AMONG ALL TRADES.
4. PROVIDE ALL MATERIALS, EQUIPMENT AND PERFORM ALL LABOR REQUIRED TO INSTALL COMPLETE MECHANICAL SYSTEMS AS INDICATED ON THE DRAWINGS, AS SPECIFIED AND AS REQUIRED BY CODE.
5. INSTALL ALL MECHANICAL EQUIPMENT AND APPURTENANCES IN ACCORDANCE WITH MANUFACTURERS' RECOMMENDATIONS, CONTRACT DOCUMENTS, AND APPLICABLE CODES AND REGULATIONS.
6. PROVIDE VIBRATION ISOLATION FOR ALL MECHANICAL EQUIPMENT TO PREVENT TRANSMISSION OF VIBRATION TO BUILDING STRUCTURE.
7. PROVIDE VIBRATION ISOLATORS FOR ALL PIPING SUPPORTS CONNECTED TO AND WITHIN 50 FEET OR 50 PIPE DIAMETERS IF ISOLATED EQUIPMENT REFER TO SPECIFICATIONS FOR EXACT REQUIREMENTS OF ALL PIPING, DUCTWORK AND EQUIPMENT VIBRATION ISOLATION.
8. LOCATE ALL TEMPERATURE, PRESSURE AND FLOW MEASURING DEVICES IN ACCESSIBLE LOCATIONS WITH STRAIGHT SECTION OF PIPE OR DUCT UP- AND DOWNSTREAM AS RECOMMENDED BY THE MANUFACTURER.
9. COORDINATE ALL EQUIPMENT CONNECTIONS WITH MANUFACTURER 'S CERTIFIED DRAWINGS. COORDINATE AND PROVIDE ALL DUCT AND PIPING TRANSITIONS REQUIRED FOR THE FINAL EQUIPMENT CONNECTIONS TO FURNISHED EQUIPMENT. FIELD VERIFY COORDINATE ALL DUCT AND PIPING DIMENSIONS BEFORE FABRICATIONS.
10. THE LOCATIONS OF ALL ITEMS SHOWN ON THE DRAWINGS OR CALLED FOR IN THE SPECIFICATIONS THAT ARE NOT DEFINITELY FIXED BY DIMENSIONS ARE APPROXIMATELY ONLY. THE EXACT LOCATIONS NECESSARY TO SECURE THE BEST CONDITIONS AND RESULTS MUST BE DETERMINED BY THE PROJECT SITE CONDITIONS AND SHALL HAVE THE APPROVAL OF THE ENGINEER BEFORE BEING INSTALLED. DO NOT SCALE DRAWINGS.
11. PROVIDE ACCESS PANELS FOR INSTALLATION IN WALLS AND CEILINGS, WHERE REQUIRED, TO SERVICE DAMPERS, VALVES, SMOKE DETECTORS, AND OTHER CONCEALED MECHANICAL EQUIPMENT. ACCESS PANELS SHALL BE TURNED OVER TO GENERAL CONTRACTOR INSTALLATION.
12. ALL DUCTWORK, PIPING AND EQUIPMENT SUPPORTED FORM STRUCTURAL STEEL SHALL BE COORDINATED WITH GENERAL CONTRACTOR. ALL ATTACHMENTS TO STEEL BAR JOISTS, TRUSSES, OR JOIST GIRDERS SHALL BE AT PANEL POINTS. PROVIDE BEAM CLAMPS MEETING SMACNA STANDARDS.
13. ALL OPENINGS IN FIRE WALLS DUE TO DUCTWORK, PIPING, CONDUIT, ETC, SHALL BE FIRE STOPPED WITH A PRODUCT SIMILAR TO 3M OR APPROVED EQUAL AS SPECIFIED IN THE ARCHITECTURAL DOCUMENTS
14. ALL AIR CONDITIONING CONDENSATE DRAIN LINES FORM EACH AIR HANDLING UNIT AND ROOFTOP UNIT SHALL BE PIPED FULL SIZE OF THE UNIT DRAIN OUTLET, WITH "P" TRAP, AND PIPED TO NEAREST DRAIN. SEE DETAILS SHOWN ON THE DRAWINGS OR THE CONTRACT SPECIFICATIONS FOR DEPTH OF AIR CONDITIONING CONDENSATE TRAP.
15. CERTAIN ITEMS SUCH AS RISERS AND DROPS IN DUCTWORK, ACCESS DOORS, VOLUME DAMPERS, ETC., ARE INDICATED ON THE CONTRACT DOCUMENT DRAWINGS FOR CLARITY FOR A SPECIFIC LOCATION REQUIREMENT AND SHALL NOT BE INTERPRETED AS THE EXTENT OF THE REQUIREMENTS FOR THESE ITEMS. LOCATIONS OF ALL SUCH ITEMS SHALL BE INDICATED ON SHOP DRAWINGS BY THE INSTALLING CONTRACTOR FOR REVIEW AND APPROVAL DURING THE SHOP DRAWING PROCESS.
16. EXACT LOCATIONS OF ALL THERMOSTATS SHALL BE AS PER ARCHITECT/ENGINEER. REFER TO ARCHITECTURAL DWGS FOR THERMOSTAT MOUNTING HEIGHT. MECHANICAL CONTRACTOR SHALL SUBMIT THERMOSTAT LOCATIONS FOR REVIEW PRIOR TO INSTALLATION.
17. ALL DUCTWORK DIMENSIONS, AS SHOWN ON THE DRAWINGS, ARE INTERIOR DIMENSIONS AND DO NOT INCLUDE INCREASED DIMENSION TO ACCOUNT FOR DUCT LINING THICKNESS. REFER TO MECHANICAL SPECIFICATIONS FOR EXACT REQUIREMENTS OF ALL DUCT LINING.
18. COORDINATE DIFFUSER, REGISTER, AND GRILLE LOCATIONS WITH ARCHITECTURAL REFLECTED CEILING PLANS, LIGHTING, AND OTHER CEILING ITEMS.
19. LOCATE ALL MECHANICAL EQUIPMENT FOR UNOBSTRUCTED ACCESS TO UNIT ACCESS PANELS, CONTROLS AND VALVING.
20. PROVIDE FLEXIBLE CONNECTIONS IN ALL DUCTWORK SYSTEMS CONNECTED TO AIR HANDLING UNITS, FANS AND OTHER EQUIPMENT WHICH REQUIRE VIBRATION ISOLATION. FLEXIBLE CONNECTIONS SHALL BE PROVIDED AT THE POINT OF CONNECTION TO THE EQUIPMENT UNLESS OTHERWISE INDICATED.
21. ALL EQUIPMENT, DUCTWORK & PIPING SHALL BE INSTALLED AT MAXIMUM HEIGHTS ALLOWABLE OR AS REQUIRED TO CLEAR NEW CEILING. DUCTWORK & PIPING SHALL BE OFFSET AS REQUIRED TO AVOID CONFLICTS EVEN IF NOT SPECIFICALLY INDICATED ON PLAN.
22. ALL EXPOSED SUPPLY DUCTWORK SHALL HAVE FLANGED AND GASKETTED CONNECTIONS AND SHALL NOT HAVE EXTERNAL INSULATION WRAP. PROVIDE ACOUSTIC LINING AS REQUIRED BY SPECIFICATIONS.
23. ALL EXPOSED DUCTWORK SHALL BE FREE OF DEFORMITIES, WRITING, STICKERS OR ANY OTHER MARKINGS. DUCT SURFACES SHALL BE TREATED AS REQUIRED FOR PAINTING. REFER TO ARCHITECTURAL DWGS FOR LOCATIONS OF DUCTWORK TO BE PAINTED.
24. ALL DUCTWORK EXPOSED TO MOISTURE SHALL BE ALUMINUM FOR A MIN. OF 10 FEET.
25. ALL SUPPLY DUCTWORK SHOWN TO HAVE ROUND DIMENSIONS SHALL BE SPIRAL ROUND DUCTWORK.
26. MOUNT ALL SUPPLY REGISTERS AT SAME ELEVATION. ELEVATIONS SHALL BE INDICATED ON THE SHEETMETAL SHOP DWGS FOR REVIEW BY ARCHITECT/ENGINEER.
27. FOR ROOMS WITH EQUIPMENT RACKS: PRODUCTION OF SHEETMETAL SHOP DRAWINGS SHALL INCLUDE ALL COORDINATION REQUIRED TO INDICATE EXACT LOCATIONS OF ALL TECHNICAL EQUIPMENT, EQUIPMENT & LADDER RACK SYSTEMS, ETC. SO AS TO ACCURATELY REVIEW COORDINATED PLACEMENT OF ALL AIR OUTLETS SERVING CRITICAL AREAS.
28. PROVIDE ACCESS DOORS IN DUCTWORK TO PROVIDE ACCESS FOR ALL SMOKE DETECTORS, FIRE DAMPERS, SMOKE DAMPERS, VOLUME DAMPERS, HUMIDIFIERS, COILS, AND OTHER ITEMS LOCATED IN THE DUCTWORK WHICH REQUIRE SERVICE AND/OR INSPECTION.
29. SMOKE DETECTORS SHALL BE FURNISHED AND WIRED BY THE ELECTRICAL CONTRACTOR. THE MECHANICAL CONTRACTOR SHALL BE RESPONSIBLE FOR MOUNTING THE SMOKE DETECTOR IN DUCTWORK AS SHOWN ON THE DRAWINGS AND IN ACCORDANCE WITH MANUFACTURERS PRINTED INSTRUCTIONS.
30. MECHANICAL CONTRACTOR TO TAKE PRE-CONSTRUCTION AIR READINGS AT ALL BASE BUILDING MAIN DUCTWORK SERVING SCOPE OF WORK AREA. INCLUDE KEYED PLAN SHOWING READING LOCATIONS AND SUBMIT TO ENGINEER PRIOR TO PRODUCTION OF SHEET METAL SHOP DWGS. REFER TO SPECIFICATIONS FOR MORE INFORMATION.
31. AIR BALANCING WORK SHALL BE WITNESSED BY THE BUILDING'S CHIEF ENGINEER OR HIS REPRESENTATIVE AND A COPY OF THE CERTIFIED BALANCING REPORT SHALL BE SUBMITTED TO THE BUILDING MANAGEMENT. PROVIDE 48 HOUR NOTICE TO BUILDING MANAGEMENT FOR THIS WORK.
32. MECHANICAL CONTRACTOR TO BALANCE SCOPE OF WORK TO NEW AIR AND WATER QUANTITIES INDICATED UPON PROJECT COMPLETION. BALANCING TO BE PERFORMED BY BASE BUILDING APPROVED CONTRACTOR.
33. CONTRACTOR TO PROVIDE TRAVERSE VOLUMETRIC, STATIC PRESSURE AND TEMPERATURE READINGS AT ALL BASE BUILDING MAIN SUPPLY, RETURN AND EXHAUST SHAFTS. READINGS TO BE INCLUDED IN FINAL BALANCING REPORT.
34. REFER TO MECHANICAL PIPING PLAN FOR THERMOSTAT LOCATIONS AND THERMOSTAT CONTROL PLAN.

MKDA
902 BROADWAY, NEW YORK, NY 10010 | 212.532.9800

ARCHITECT OF RECORD:
JOHN F. GIUSEFFI, ARCHITECT, PC.
902 BROADWAY, NEW YORK, NY 10010 | 212.532.9800

CLIENT:
snowflake
7 TIMES SQUARE
NEW YORK, NY 10036

MEP CONSULTANT:
AMA CONSULTING ENGINEERS
825 8TH AVE #18
NEW YORK, NY 10019
212.944.7722

AV/IT/SEC CONSULTANT:
NORTHLAND CONTROLS
44150 S GRIMMER BLVD
FREMONT, CA 94538

FOOD SERVICE DESIGN CONSULTANT:
COLBURN GUYETTE
100 LEDGEWOOD PL #104
ROCKLAND, MA 02370

DESIGN CONSULTANT:
JPC ARCHITECTS
909 112th Ave NE Suite 206
Bellevue, WA 98004

NO.	DATE	ISSUE
3	07/01/2026	ISSUE FOR ADD ALTERNATE
	05/22/2026	ISSUE FOR FILING
	04/03/2026	ISSUE FOR PRICING

REVISIONS

PROJECT:
SNOWFLAKE
7 TIMES SQUARE, NEW YORK, NY
FLOORS 29, 30, 31

DRAWING TITLE:
LEVEL 29 - MECHANICAL DUCTWORK PLAN


SEAL & SIGNATURE

DATE: 05.22.2026
SCALE: As indicated
PROJECT NO. ----
DRAWN: CHECKED:

DRAWING NO.
M-529.00

2026 MKDA, INC. ©
THESE PLANS ARE THE SOLE PROPERTY OF MKDA. USE WITHOUT PERMISSION IS STRICTLY FORBIDDEN AND WILL RESULT IN THE INITIATION OF LEGAL PROCEEDINGS

NYC DOB NUMBER
M01397257-S1

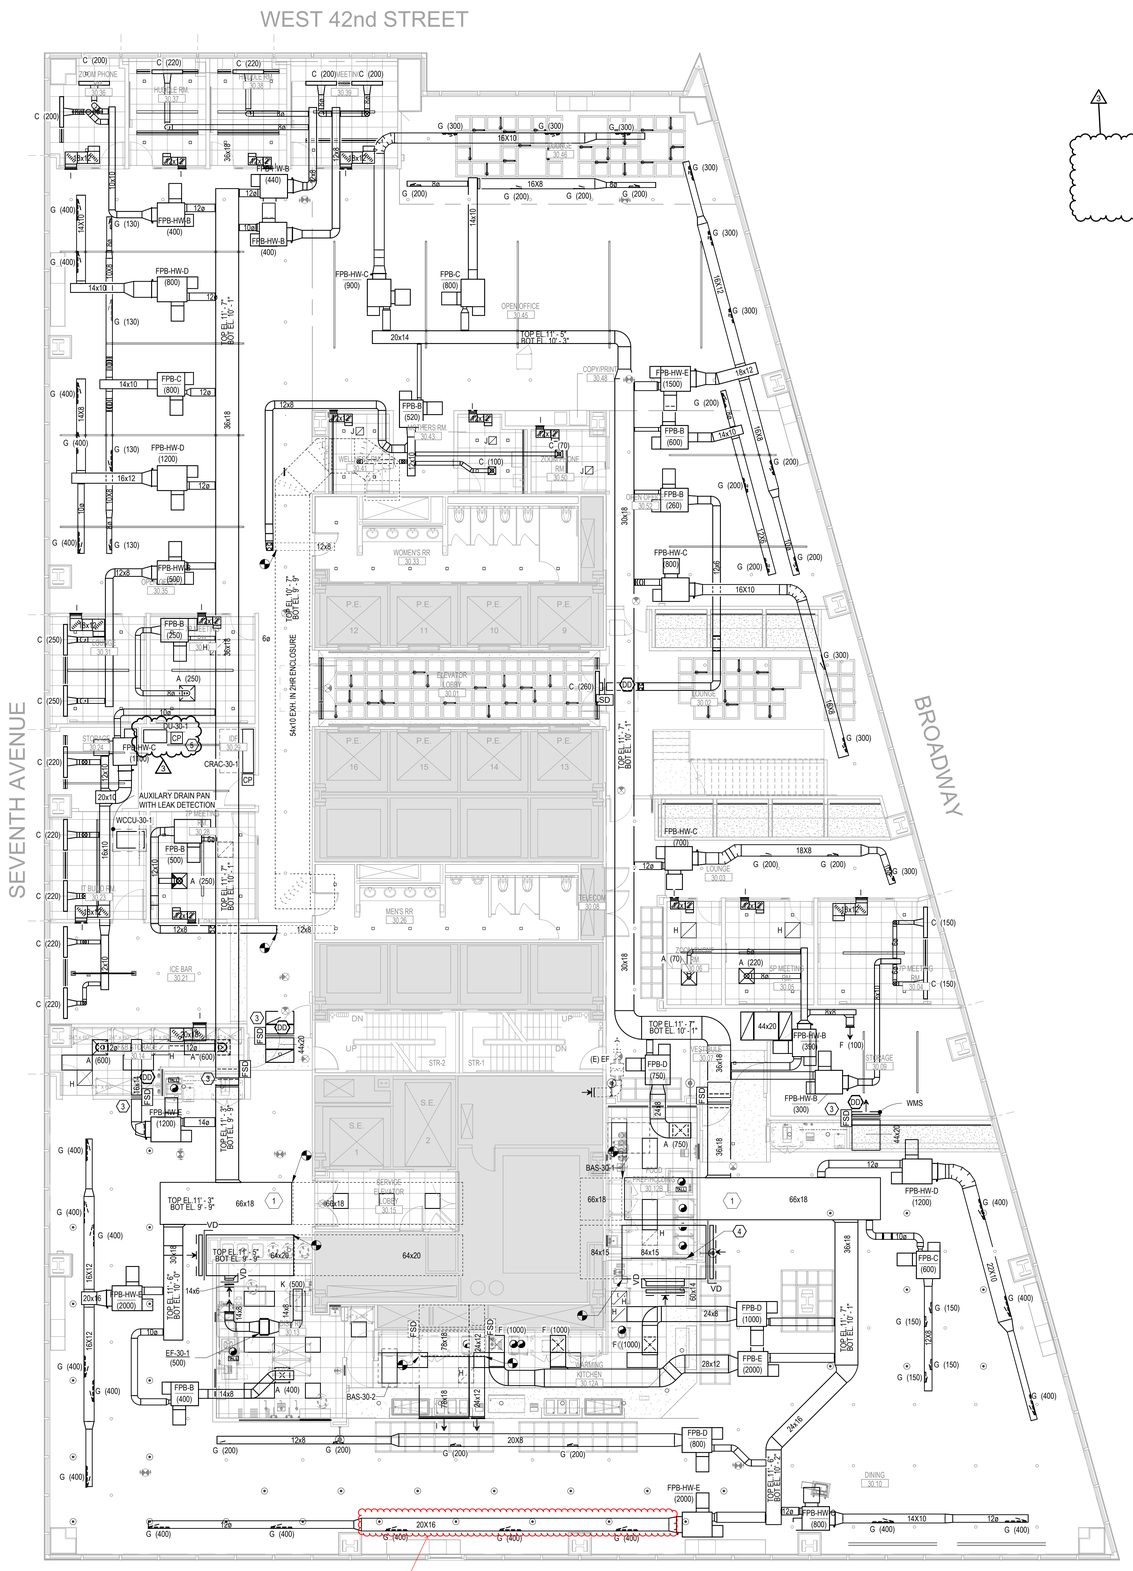

KEY NOTES

1. DUCTWORK TO BE CONSTRUCTED OF 16-GAUGE OUTER DUCT W/1" ACOUSTICAL LINING, TEDLAR LINER AND STANDARD GAUGE PERFORATED INNER DUCT TO MATCH BUILDING STANDARD FOR FAN DISCHARGE DUCTWORK.
2. EXPOSED DUCTWORK SHALL BE OVAL OR ROUND SPIRAL DUCT CONSTRUCTED OF GALVANIZED STEEL WITH ACOUSTICAL LINING AS PER SPECIFICATIONS. FABRICATE AND INSTALL AS PER SMACNA STANDARDS, WITH ALL SEAMS AIRTIGHT AND CONNECTIONS SUITABLE FOR PRESSURE CLASS. SUPPORT AND HANG DUCT PER CODE REQUIREMENTS.
3. PROVIDE PNEUMATIC PIPING AND WIRING AS REQUIRED FOR FIRE SMOKE DAMPER PER BUILDING RULES AND REGULATIONS. COORDINATE WITH BMS VENDOR.
4. PROVIDE RETURN AIR TRANSFER OPENINGS ABOVE THE CEILING WITH MINIMUM OF 1.90 SQ FEET FREE AREA AT PARTITION INDICATED. GC TO COORDINATE.
5. UNIT LOCATION TO BE COORDINATED WITH IDF LAYOUT. LOCATION AND POSITIONING SHOULD ALLOW FOR ALL CLEARANCES AS SPECIFIED BY MANUFACTURER. IF CEILING HUNG, UNIT SHOULD BE VIBRATION INSULATED AS DESCRIBED FOR MECHANICAL EQUIPMENT IN SPECIFICATIONS.

MECHANICAL NOTES

1. ALL WORK SHALL CONFORM TO THE LATEST BUILDING STANDARDS. IT IS THE RESPONSIBILITY OF THE CONTRACTOR TO OBTAIN A COPY OF THE BUILDING STANDARDS AND MEET WITH BUILDING MANAGEMENT IN ORDER TO BECOME TOTALLY FAMILIAR WITH THE BUILDING CONSTRUCTION RULES. THERE SHALL BE NO DEVIATION FROM THE BUILDING STANDARDS WITHOUT PRIOR WRITTEN APPROVAL FROM THE BUILDING MANAGEMENT.
2. WHEN MECHANICAL WORK IS SUBCONTRACTED IT SHALL BE THE MECHANICAL CONTRACTORS RESPONSIBILITY TO COORDINATE SUBCONTRACTORS AND THE ASSOCIATED CONTRACTS. WHEN DISCREPANCIES ARISE PERTAINING TO WHICH CONTRACTOR PROVIDES A PARTICULAR ITEM OF THE MECHANICAL CONTRACT OR WHICH CONTRACTOR PROVIDES FINAL CONNECTIONS FOR A PARTICULAR ITEM OF THE MECHANICAL CONTRACT. IT SHALL BE BROUGHT TO THE ATTENTION OF THE MECHANICAL CONTRACTOR, WHOSE DECISION SHALL BE FINAL.
3. ALL MISCELLANEOUS STEEL REQUIRED TO ENSURE PROPER INSTALLATION AND AS SHOWN IN DETAILS FOR PIPING, DUCTWORK, AND EQUIPMENT SHALL BE FURNISHED AND INSTALLED BY THE MECHANICAL CONTRACTOR AND COORDINATED WITH THE GENERAL CONTRACTOR FOR COORDINATION AMONG ALL TRADES.
4. PROVIDE ALL MATERIALS, EQUIPMENT AND PERFORM ALL LABOR REQUIRED TO INSTALL COMPLETE MECHANICAL SYSTEMS AS INDICATED ON THE DRAWINGS, AS SPECIFIED AND AS REQUIRED BY CODE.
5. INSTALL ALL MECHANICAL EQUIPMENT AND APPURTENANCES IN ACCORDANCE WITH MANUFACTURERS' RECOMMENDATIONS, CONTRACT DOCUMENTS, AND APPLICABLE CODES AND REGULATIONS.
6. PROVIDE VIBRATION ISOLATION FOR ALL MECHANICAL EQUIPMENT TO PREVENT TRANSMISSION OF VIBRATION TO BUILDING STRUCTURE.
7. PROVIDE VIBRATION ISOLATORS FOR ALL PIPING SUPPORTS CONNECTED TO AND WITHIN 50 FEET OR 50 PIPE DIAMETERS IF ISOLATED EQUIPMENT REFER TO SPECIFICATIONS FOR EXACT REQUIREMENTS OF ALL PIPING, DUCTWORK AND EQUIPMENT VIBRATION ISOLATION.
8. LOCATE ALL TEMPERATURE, PRESSURE AND FLOW MEASURING DEVICES IN ACCESSIBLE LOCATIONS WITH STRAIGHT SECTION OF PIPE OR DUCT UP- AND DOWNSTREAM AS RECOMMENDED BY THE MANUFACTURER.
9. COORDINATE ALL EQUIPMENT CONNECTIONS WITH MANUFACTURER 'S CERTIFIED DRAWINGS. COORDINATE AND PROVIDE ALL DUCT AND PIPING TRANSITIONS REQUIRED FOR THE FINAL EQUIPMENT CONNECTIONS TO FURNISHED EQUIPMENT. FIELD VERIFY COORDINATE ALL DUCT AND PIPING DIMENSIONS BEFORE FABRICATIONS.
10. THE LOCATIONS OF ALL ITEMS SHOWN ON THE DRAWINGS OR CALLED FOR IN THE SPECIFICATIONS THAT ARE NOT DEFINITELY FIXED BY DIMENSIONS ARE APPROXIMATELY ONLY. THE EXACT LOCATIONS NECESSARY TO SECURE THE BEST CONDITIONS AND RESULTS MUST BE DETERMINED BY THE PROJECT SITE CONDITIONS AND SHALL HAVE THE APPROVAL OF THE ENGINEER BEFORE BEING INSTALLED. DO NOT SCALE DRAWINGS.
11. PROVIDE ACCESS PANELS FOR INSTALLATION IN WALLS AND CEILINGS, WHERE REQUIRED. TO SERVICE DAMPERS, VALVES, SMOKE DETECTORS, AND OTHER CONCEALED MECHANICAL EQUIPMENT. ACCESS PANELS SHALL BE TURNED OVER TO GENERAL CONTRACTOR INSTALLATION.
12. ALL DUCTWORK, PIPING AND EQUIPMENT SUPPORTED FORM STRUCTURAL STEEL SHALL BE COORDINATED WITH GENERAL CONTRACTOR. ALL ATTACHMENTS TO STEEL BAR JOISTS, TRUSSES, OR JOIST GIRDERS SHALL BE AT PANEL POINTS. PROVIDE BEAM CLAMPS MEETING SMACNA STANDARDS.
13. ALL OPENINGS IN FIRE WALLS DUE TO DUCTWORK, PIPING, CONDUIT, ETC, SHALL BE FIRE STOPPED WITH A PRODUCT SIMILAR TO 3M OR APPROVED EQUAL AS SPECIFIED IN THE ARCHITECTURAL DOCUMENTS
14. ALL AIR CONDITIONING CONDENSATE DRAIN LINES FORM EACH AIR HANDLING UNIT AND ROOFTOP UNIT SHALL BE PIPED FULL SIZE OF THE UNIT. DRAIN OUTLET, WITH 1"P" TRAP, AND PIPED TO NEAREST DRAIN. SEE DETAILS SHOWN ON THE DRAWINGS OR THE CONTRACT SPECIFICATIONS FOR DEPTH OF AIR CONDITIONING CONDENSATE TRAP.
15. CERTAIN ITEMS SUCH AS RISERS AND DROPS IN DUCTWORK, ACCESS DOORS, VOLUME DAMPERS, ETC., ARE INDICATED ON THE CONTRACT DOCUMENT DRAWINGS FOR CLARITY FOR A SPECIFIC LOCATION REQUIREMENT AND SHALL NOT BE INTERPRETED AS THE EXTENT OF THE REQUIREMENTS FOR THESE ITEMS. LOCATIONS OF ALL SUCH ITEMS SHALL BE INDICATED ON SHOP DRAWINGS BY THE INSTALLING CONTRACTOR FOR REVIEW AND APPROVAL DURING THE SHOP DRAWING PROCESS.
16. EXACT LOCATIONS OF ALL THERMOSTATS SHALL BE AS PER ARCHITECT/ENGINEER. REFER TO ARCHITECTURAL DWGS FOR THERMOSTAT MOUNTING HEIGHT. MECHANICAL CONTRACTOR SHALL SUBMIT THERMOSTAT LOCATIONS FOR REVIEW PRIOR TO INSTALLATION.
17. ALL DUCTWORK DIMENSIONS, AS SHOWN ON THE DRAWINGS, ARE INTERIOR DIMENSIONS AND DO NOT INCLUDE INCREASED DIMENSION TO ACCOUNT FOR DUCT LINING THICKNESS. REFER TO MECHANICAL SPECIFICATIONS FOR EXACT REQUIREMENTS OF ALL DUCT LINING.
18. COORDINATE DIFFUSER, REGISTER, AND GRILLE LOCATIONS WITH ARCHITECTURAL REFLECTED CEILING PLANS, LIGHTING, AND OTHER CEILING ITEMS.
19. LOCATE ALL MECHANICAL EQUIPMENT FOR UNOBSTRUCTED ACCESS TO UNIT ACCESS PANELS, CONTROLS AND VALVING.
20. PROVIDE FLEXIBLE CONNECTIONS IN ALL DUCTWORK SYSTEMS CONNECTED TO AIR HANDLING UNITS, FANS AND OTHER EQUIPMENT WHICH REQUIRE VIBRATION ISOLATION. FLEXIBLE CONNECTIONS SHALL BE PROVIDED AT THE POINT OF CONNECTION TO THE EQUIPMENT UNLESS OTHERWISE INDICATED.
21. ALL EQUIPMENT, DUCTWORK & PIPING SHALL BE INSTALLED AT MAXIMUM HEIGHTS ALLOWABLE OR AS REQUIRED TO CLEAR NEW CEILING. DUCTWORK & PIPING SHALL BE OFFSET AS REQUIRED TO AVOID CONFLICTS EVEN IF NOT SPECIFICALLY INDICATED ON PLAN.
22. ALL EXPOSED SUPPLY DUCTWORK SHALL HAVE FLANGED AND GASKETTED CONNECTIONS AND SHALL NOT HAVE EXTERNAL INSULATION WRAP. PROVIDE ACOUSTIC LINING AS REQUIRED BY SPECIFICATIONS.
23. ALL EXPOSED DUCTWORK SHALL BE FREE OF DEFORMITIES, WRITING, STICKERS OR ANY OTHER MARKINGS. DUCT SURFACES SHALL BE TREATED AS REQUIRED FOR PAINTING. REFER TO ARCHITECTURAL DWGS FOR LOCATIONS OF DUCTWORK TO BE PAINTED.
24. ALL DUCTWORK EXPOSED TO MOISTURE SHALL BE ALUMINUM FOR A MIN. OF 10 FEET.
25. ALL SUPPLY DUCTWORK SHOWN TO HAVE ROUND DIMENSIONS SHALL BE SPIRAL ROUND DUCTWORK.
26. MOUNT ALL SUPPLY REGISTERS AT SAME ELEVATION. ELEVATIONS SHALL BE INDICATED ON THE SHEETMETAL SHOP DWGS FOR REVIEW BY ARCHITECT/ENGINEER.
27. FOR ROOMS WITH EQUIPMENT RACKS: PRODUCTION OF SHEETMETAL SHOP DRAWINGS SHALL INCLUDE ALL COORDINATION REQUIRED TO INDICATE EXACT LOCATIONS OF ALL TECHNICAL EQUIPMENT, EQUIPMENT & LADDER RACK SYSTEMS, ETC. SO AS TO ACCURATELY REVIEW COORDINATED PLACEMENT OF ALL AIR OUTLETS SERVING CRITICAL AREAS.
28. PROVIDE ACCESS DOORS IN DUCTWORK TO PROVIDE ACCESS FOR ALL SMOKE DETECTORS, FIRE DAMPERS, SMOKE DAMPERS, VOLUME DAMPERS, HUMIDIFIERS, COILS, AND OTHER ITEMS LOCATED IN THE DUCTWORK WHICH REQUIRE SERVICE AND/OR INSPECTION.
29. SMOKE DETECTORS SHALL BE FURNISHED AND WIRED BY THE ELECTRICAL CONTRACTOR. THE MECHANICAL CONTRACTOR SHALL BE RESPONSIBLE FOR MOUNTING THE SMOKE DETECTOR IN DUCTWORK AS SHOWN ON THE DRAWINGS AND IN ACCORDANCE WITH MANUFACTURERS PRINTED INSTRUCTIONS.
30. MECHANICAL CONTRACTOR TO TAKE PRE-CONSTRUCTION AIR READINGS AT ALL BASE BUILDING MAIN DUCTWORK SERVING SCOPE OF WORK AREA. INCLUDE KEYED PLAN SHOWING READING LOCATIONS AND SUBMIT TO ENGINEER PRIOR TO PRODUCTION OF SHEET METAL SHOP DWGS. REFER TO SPECIFICATIONS FOR MORE INFORMATION.
31. AIR BALANCING WORK SHALL BE WITNESSED BY THE BUILDING'S CHIEF ENGINEER OR HIS REPRESENTATIVE AND A COPY OF THE CERTIFIED BALANCING REPORT SHALL BE SUBMITTED TO THE BUILDING MANAGEMENT. PROVIDE 48 HOUR NOTICE TO BUILDING MANAGEMENT FOR THIS WORK.
32. MECHANICAL CONTRACTOR TO BALANCE SCOPE OF WORK TO NEW AIR AND WATER QUANTITIES INDICATED UPON PROJECT COMPLETION. BALANCING TO BE PERFORMED BY BASE BUILDING APPROVED CONTRACTOR.
33. CONTRACTOR TO PROVIDE TRAVERSE VOLUMETRIC, STATIC PRESSURE AND TEMPERATURE READINGS AT ALL BASE BUILDING MAIN SUPPLY, RETURN AND EXHAUST SHAFTS. READINGS TO BE INCLUDED IN FINAL BALANCING REPORT.
34. REFER TO MECHANICAL PIPING PLAN FOR THERMOSTAT LOCATIONS AND THERMOSTAT CONTROL PLAN.

MKDA
902 BROADWAY, NEW YORK, NY 10010 | 212.532.9800

ARCHITECT OF RECORD:
JOHN F. GIUSEFFI, ARCHITECT, PC.
902 BROADWAY, NEW YORK, NY 10010 | 212.532.9800

CLIENT:
snowflake
7 TIMES SQUARE
NEW YORK, NY 10036

MEP CONSULTANT:
AMA CONSULTING ENGINEERS
825 8TH AVE #18
NEW YORK, NY 10019
212.944.7722

AV/IT/SEC CONSULTANT:
NORTHLAND CONTROLS
44150 S GRIMMER BLVD
FREMONT, CA 94538

FOOD SERVICE DESIGN CONSULTANT:
COLBURN GUYETTE
100 LEDGEWOOD PL #104
ROCKLAND, MA 02370

DESIGN CONSULTANT:
JPC ARCHITECTS
909 112th Ave NE Suite 206
Bellevue, WA 98004

NO.	DATE	ISSUE
		REVISIONS
3	07/01/2026	ISSUE FOR ADD ALTERNATE
	05/22/2026	ISSUE FOR FILING
	04/03/2026	ISSUE FOR PRICING

PROJECT:
SNOWFLAKE
7 TIMES SQUARE, NEW YORK, NY
FLOORS 29, 30, 31

DRAWING TITLE:
LEVEL 30 - MECHANICAL DUCTWORK PLAN


SEAL & SIGNATURE

DATE: 05.22.2026
SCALE: As indicated
PROJECT NO. ----
DRAWN: CHECKED:

DRAWING NO.
M-530.00

2026 MKDA, INC. ©
THESE PLANS ARE THE SOLE PROPERTY OF MKDA. USE WITHOUT PERMISSION IS STRICTLY FORBIDDEN AND WILL RESULT IN THE INITIATION OF LEGAL PROCEEDINGS

NYC DOB NUMBER
M01397257-S1

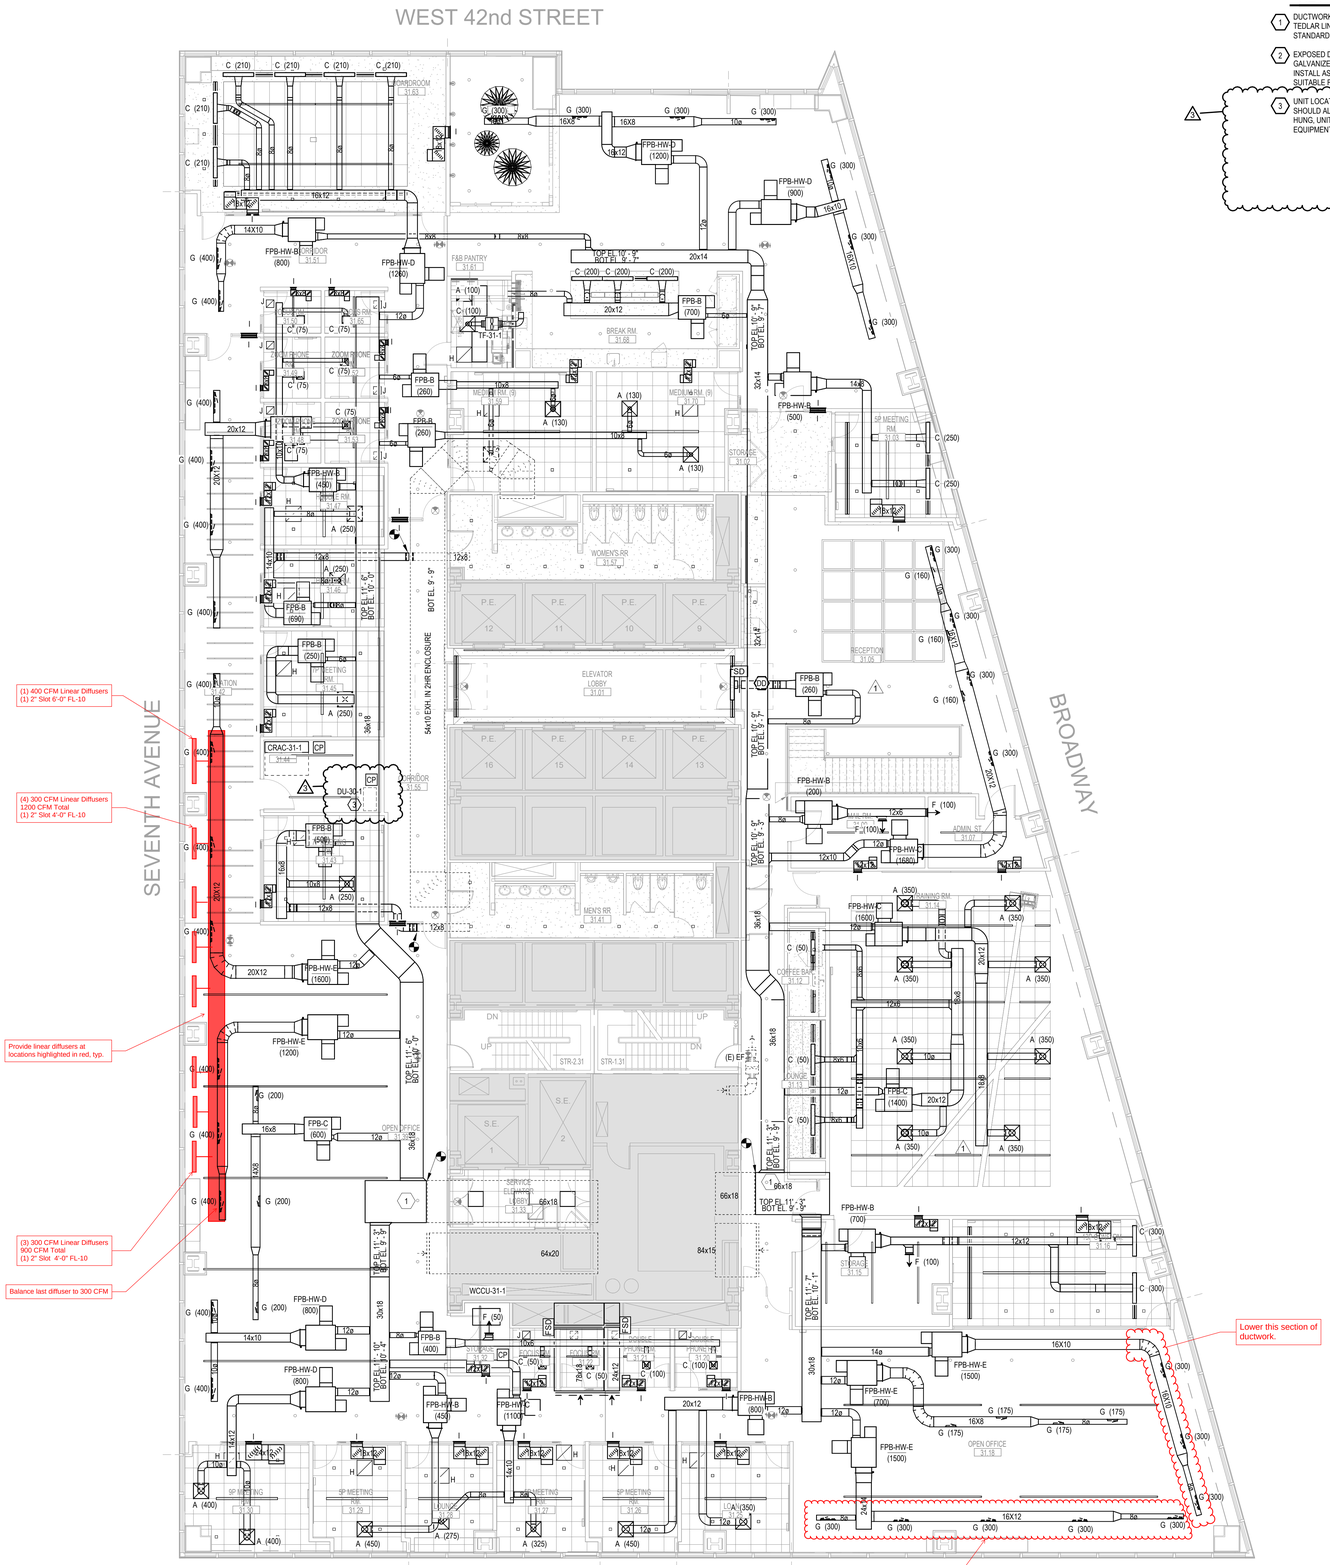

KEY NOTES

1. DUCTWORK TO BE CONSTRUCTED OF 16-GAUGE OUTER DUCT W/1" ACOUSTICAL LINING, TEDLAR LINER AND STANDARD GAUGE PERFORATED INNER DUCT TO MATCH BUILDING STANDARD FOR FAN DISCHARGE DUCTWORK.
2. EXPOSED DUCTWORK SHALL BE OVAL OR ROUND SPIRAL DUCT CONSTRUCTED OF GALVANIZED STEEL WITH ACOUSTICAL LINING AS PER SPECIFICATIONS. FABRICATE AND INSTALL AS PER SMACNA STANDARDS. WITH ALL SEAMS AIRTIGHT AND CONNECTIONS SUITABLE FOR PRESSURE CLASS, SUPPORT AND HANG DUCT PER CODE REQUIREMENTS.
3. UNIT LOCATION TO BE COORDINATED WITH IDF LAYOUT. LOCATION AND POSITIONING SHOULD ALLOW FOR ALL CLEARANCES AS SPECIFIED BY MANUFACTURER. IF CEILING HUNG, UNIT SHOULD BE VIBRATION INSULATED AS DESCRIBED FOR MECHANICAL EQUIPMENT IN SPECIFICATIONS.

MECHANICAL NOTES

1. ALL WORK SHALL CONFORM TO THE LATEST BUILDING STANDARDS. IT IS THE RESPONSIBILITY OF THE CONTRACTOR TO OBTAIN A COPY OF THE BUILDING STANDARDS AND MEET WITH BUILDING MANAGEMENT IN ORDER TO BECOME TOTALLY FAMILIAR WITH THE BUILDING CONSTRUCTION RULES. THERE SHALL BE NO DEVIATION FROM THE BUILDING STANDARDS WITHOUT PRIOR WRITTEN APPROVAL FROM THE BUILDING MANAGEMENT.
2. WHEN MECHANICAL WORK IS SUBCONTRACTED IT SHALL BE THE MECHANICAL CONTRACTORS RESPONSIBILITY TO COORDINATE SUBCONTRACTORS AND THE ASSOCIATED CONTRACTS. WHEN DISCREPANCIES ARISE PERTAINING TO WHICH CONTRACTOR PROVIDES A PARTICULAR ITEM OF THE MECHANICAL CONTRACT OR WHICH CONTRACTOR PROVIDES FINAL CONNECTIONS FOR A PARTICULAR ITEM OF THE MECHANICAL CONTRACT. IT SHALL BE BROUGHT TO THE ATTENTION OF THE MECHANICAL CONTRACTOR, WHOSE DECISION SHALL BE FINAL.
3. ALL MISCELLANEOUS STEEL REQUIRED TO ENSURE PROPER INSTALLATION AND AS SHOWN IN DETAILS FOR PIPING, DUCTWORK, AND EQUIPMENT SHALL BE FURNISHED AND INSTALLED BY THE MECHANICAL CONTRACTOR AND COORDINATED WITH THE GENERAL CONTRACTOR FOR COORDINATION AMONG ALL TRADES.
4. PROVIDE ALL MATERIALS, EQUIPMENT AND PERFORM ALL LABOR REQUIRED TO INSTALL COMPLETE MECHANICAL SYSTEMS AS INDICATED ON THE DRAWINGS, AS SPECIFIED AND AS REQUIRED BY CODE.
5. INSTALL ALL MECHANICAL EQUIPMENT AND APPURTENANCES IN ACCORDANCE WITH MANUFACTURERS' RECOMMENDATIONS, CONTRACT DOCUMENTS, AND APPLICABLE CODES AND REGULATIONS.
6. PROVIDE VIBRATION ISOLATION FOR ALL MECHANICAL EQUIPMENT TO PREVENT TRANSMISSION OF VIBRATION TO BUILDING STRUCTURE.
7. PROVIDE VIBRATION ISOLATORS FOR ALL PIPING SUPPORTS CONNECTED TO AND WITHIN 50 FEET OR 50 PIPE DIAMETERS IF ISOLATED EQUIPMENT REFER TO SPECIFICATIONS FOR EXACT REQUIREMENTS OF ALL PIPING, DUCTWORK AND EQUIPMENT VIBRATION ISOLATION.
8. LOCATE ALL TEMPERATURE, PRESSURE AND FLOW MEASURING DEVICES IN ACCESSIBLE LOCATIONS WITH STRAIGHT SECTION OF PIPE OR DUCT UP- AND DOWNSTREAM AS RECOMMENDED BY THE MANUFACTURER.
9. COORDINATE ALL EQUIPMENT CONNECTIONS WITH MANUFACTURER 'S CERTIFIED DRAWINGS. COORDINATE AND PROVIDE ALL DUCT AND PIPING TRANSITIONS REQUIRED FOR THE FINAL EQUIPMENT CONNECTIONS TO FURNISHED EQUIPMENT. FIELD VERIFY COORDINATE ALL DUCT AND PIPING DIMENSIONS BEFORE FABRICATIONS.
10. THE LOCATIONS OF ALL ITEMS SHOWN ON THE DRAWINGS OR CALLED FOR IN THE SPECIFICATIONS THAT ARE NOT DEFINITELY FIXED BY DIMENSIONS ARE APPROXIMATELY ONLY. THE EXACT LOCATIONS NECESSARY TO SECURE THE BEST CONDITIONS AND RESULTS MUST BE DETERMINED BY THE PROJECT SITE CONDITIONS AND SHALL HAVE THE APPROVAL OF THE ENGINEER BEFORE BEING INSTALLED. DO NOT SCALE DRAWINGS.
11. PROVIDE ACCESS PANELS FOR INSTALLATION IN WALLS AND CEILINGS, WHERE REQUIRED, TO SERVICE DAMPERS, VALVES, SMOKE DETECTORS, AND OTHER CONCEALED MECHANICAL EQUIPMENT. ACCESS PANELS SHALL BE TURNED OVER TO GENERAL CONTRACTOR INSTALLATION.
12. ALL DUCTWORK, PIPING AND EQUIPMENT SUPPORTED FORM STRUCTURAL STEEL SHALL BE COORDINATED WITH GENERAL CONTRACTOR. ALL ATTACHMENTS TO STEEL BAR JOISTS, TRUSSES, OR JOIST GIRDERS SHALL BE AT PANEL POINTS. PROVIDE BEAM CLAMPS MEETING SMACNA STANDARDS.
13. ALL OPENINGS IN FIRE WALLS DUE TO DUCTWORK, PIPING, CONDUIT, ETC, SHALL BE FIRE-STOPPED WITH A PRODUCT SIMILAR TO 3M OR APPROVED EQUAL AS SPECIFIED IN THE ARCHITECTURAL DOCUMENTS
14. ALL AIR CONDITIONING CONDENSATE DRAIN LINES FORM EACH AIR HANDLING UNIT AND ROOFTOP UNIT SHALL BE PIPED FULL SIZE OF THE UNIT DRAIN OUTLET, WITH " P" TRAP, AND PIPED TO NEAREST DRAIN. SEE DETAILS SHOWN ON THE DRAWINGS OR THE CONTRACT SPECIFICATIONS FOR DEPTH OF AIR CONDITIONING CONDENSATE TRAP.
15. CERTAIN ITEMS SUCH AS RISERS AND DROPS IN DUCTWORK, ACCESS DOORS, VOLUME DAMPERS, ETC., ARE INDICATED ON THE CONTRACT DOCUMENT DRAWINGS FOR CLARITY FOR A SPECIFIC LOCATION REQUIREMENT AND SHALL NOT BE INTERPRETED AS THE EXTENT OF THE REQUIREMENTS FOR THESE ITEMS. LOCATIONS OF ALL SUCH ITEMS SHALL BE INDICATED ON SHOP DRAWINGS BY THE INSTALLING CONTRACTOR FOR REVIEW AND APPROVAL DURING THE SHOP DRAWING PROCESS.
16. EXACT LOCATIONS OF ALL THERMOSTATS SHALL BE AS PER ARCHITECT/ENGINEER. REFER TO ARCHITECTURAL DWGS FOR THERMOSTAT MOUNTING HEIGHT. MECHANICAL CONTRACTOR SHALL SUBMIT THERMOSTAT LOCATIONS FOR REVIEW PRIOR TO INSTALLATION.
17. ALL DUCTWORK DIMENSIONS, AS SHOWN ON THE DRAWINGS, ARE INTERIOR DIMENSIONS AND DO NOT INCLUDE INCREASED DIMENSION TO ACCOUNT FOR DUCT LINING THICKNESS. REFER TO MECHANICAL SPECIFICATIONS FOR EXACT REQUIREMENTS OF ALL DUCT LINING.
18. COORDINATE DIFFUSER, REGISTER, AND GRILLE LOCATIONS WITH ARCHITECTURAL REFLECTED CEILING PLANS, LIGHTING, AND OTHER CEILING ITEMS.
19. LOCATE ALL MECHANICAL EQUIPMENT FOR UNOBSTRUCTED ACCESS TO UNIT ACCESS PANELS, CONTROLS AND VALVING.
20. PROVIDE FLEXIBLE CONNECTIONS IN ALL DUCTWORK SYSTEMS CONNECTED TO AIR HANDLING UNITS, FANS AND OTHER EQUIPMENT WHICH REQUIRE VIBRATION ISOLATION. FLEXIBLE CONNECTIONS SHALL BE PROVIDED AT THE POINT OF CONNECTION TO THE EQUIPMENT UNLESS OTHERWISE INDICATED.
21. ALL EQUIPMENT, DUCTWORK & PIPING SHALL BE INSTALLED AT MAXIMUM HEIGHTS ALLOWABLE OR AS REQUIRED TO CLEAR NEW CEILING. DUCTWORK & PIPING SHALL BE OFFSET AS REQUIRED TO AVOID CONFLICTS EVEN IF NOT SPECIFICALLY INDICATED ON PLAN.
22. ALL EXPOSED SUPPLY DUCTWORK SHALL HAVE FLANGED AND GASKETTED CONNECTIONS AND SHALL NOT HAVE EXTERNAL INSULATION WRAP. PROVIDE ACOUSTIC LINING AS REQUIRED BY SPECIFICATIONS.
23. ALL EXPOSED DUCTWORK SHALL BE FREE OF DEFORMITIES, WRITING, STICKERS OR ANY OTHER MARKINGS. DUCT SURFACES SHALL BE TREATED AS REQUIRED FOR PAINTING. REFER TO ARCHITECTURAL DWGS FOR LOCATIONS OF DUCTWORK TO BE PAINTED.
24. ALL DUCTWORK EXPOSED TO MOISTURE SHALL BE ALUMINUM FOR A MIN. OF 10 FEET.
25. ALL SUPPLY DUCTWORK SHOWN TO HAVE ROUND DIMENSIONS SHALL BE SPIRAL ROUND DUCTWORK.
26. MOUNT ALL SUPPLY REGISTERS AT SAME ELEVATION. ELEVATIONS SHALL BE INDICATED ON THE SHEETMETAL SHOP DWGS FOR REVIEW BY ARCHITECT/ENGINEER.
27. FOR ROOMS WITH EQUIPMENT RACKS: PRODUCTION OF SHEETMETAL SHOP DRAWINGS SHALL INCLUDE ALL COORDINATION REQUIRED TO INDICATE EXACT LOCATIONS OF ALL TECHNICAL EQUIPMENT, EQUIPMENT & LADDER RACK SYSTEMS, ETC. SO AS TO ACCURATELY REVIEW COORDINATED PLACEMENT OF ALL AIR OUTLETS SERVING CRITICAL AREAS.
28. PROVIDE ACCESS DOORS IN DUCTWORK TO PROVIDE ACCESS FOR ALL SMOKE DETECTORS, FIRE DAMPERS, SMOKE DAMPERS, VOLUME DAMPERS, HUMIDIFIERS, COILS, AND OTHER ITEMS LOCATED IN THE DUCTWORK WHICH REQUIRE SERVICE AND/OR INSPECTION.
29. SMOKE DETECTORS SHALL BE FURNISHED AND WIRED BY THE ELECTRICAL CONTRACTOR. THE MECHANICAL CONTRACTOR SHALL BE RESPONSIBLE FOR MOUNTING THE SMOKE DETECTOR IN DUCTWORK AS SHOWN ON THE DRAWINGS AND IN ACCORDANCE WITH MANUFACTURERS PRINTED INSTRUCTIONS.
30. MECHANICAL CONTRACTOR TO TAKE PRE-CONSTRUCTION AIR READINGS AT ALL BASE BUILDING MAIN DUCTWORK SERVING SCOPE OF WORK AREA. INCLUDE KEYED PLAN SHOWING READING LOCATIONS AND SUBMIT TO ENGINEER PRIOR TO PRODUCTION OF SHEET METAL SHOP DWGS. REFER TO SPECIFICATIONS FOR MORE INFORMATION.
31. AIR BALANCING WORK SHALL BE WITNESSED BY THE BUILDING'S CHIEF ENGINEER OR HIS REPRESENTATIVE AND A COPY OF THE CERTIFIED BALANCING REPORT SHALL BE SUBMITTED TO THE BUILDING MANAGEMENT. PROVIDE 48 HOUR NOTICE TO BUILDING MANAGEMENT FOR THIS WORK.
32. MECHANICAL CONTRACTOR TO BALANCE SCOPE OF WORK TO NEW AIR AND WATER QUANTITIES INDICATED UPON PROJECT COMPLETION. BALANCING TO BE PERFORMED BY BASE BUILDING APPROVED CONTRACTOR.
33. CONTRACTOR TO PROVIDE TRAVERSE VOLUMETRIC, STATIC PRESSURE AND TEMPERATURE READINGS AT ALL BASE BUILDING MAIN SUPPLY, RETURN AND EXHAUST SHAFTS. READINGS TO BE INCLUDED IN FINAL BALANCING REPORT.
34. REFFER TO MECHANICAL PIPING PLAN FOR THERMOSTAT LOCATIONS AND THERMOSTAT CONTROL PLAN.

MKDA
902 BROADWAY, NEW YORK, NY 10010 | 212.532.9800

ARCHITECT OF RECORD:
JOHN F. GIUSEFFI, ARCHITECT, PC.
902 BROADWAY, NEW YORK, NY 10010 | 212.532.9800

CLIENT:
snowflake
7 TIMES SQUARE
NEW YORK, NY 10036

MEP CONSULTANT:
AMA CONSULTING ENGINEERS
825 8TH AVE #18
NEW YORK, NY 10019
212.944.7722

AV/IT/SEC CONSULTANT:
NORTHLAND CONTROLS
44150 S GRIMMER BLVD
FREMONT, CA 94538

FOOD SERVICE DESIGN CONSULTANT:
COLBURN GUYETTE
100 LEDGEWOOD PL #104
ROCKLAND, MA 02370

DESIGN CONSULTANT:
JPC ARCHITECTS
909 112th Ave NE Suite 206
Bellevue, WA 98004

NO.	DATE	ISSUE
3	07/01/2026	ISSUE FOR ADD ALTERNATE
	05/22/2026	ISSUE FOR FILING
1	04/22/2026	ADDENDUM #1
	04/03/2026	ISSUE FOR PRICING

REVISIONS

PROJECT:
SNOWFLAKE
7 TIMES SQUARE, NEW YORK, NY
FLOORS 29, 30, 31


DRAWING TITLE:
LEVEL 31 - MECHANICAL DUCTWORK PLAN

SEAL & SIGNATURE

DATE: 05.22.2026
SCALE: As indicated
PROJECT NO. ----
DRAWN: CHECKED:
DRAWING NO.
M-531.00


2026 MKDA, INC. ©
THESE PLANS ARE THE SOLE PROPERTY OF MKDA. USE WITHOUT PERMISSION IS STRICTLY FORBIDDEN AND WILL RESULT IN THE INITIATION OF LEGAL PROCEEDINGS

NYC DOB NUMBER
M01397257-S1

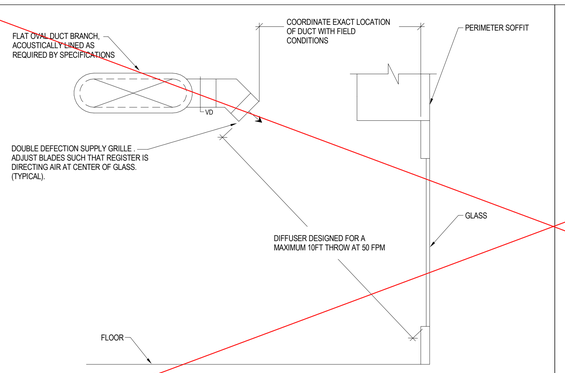


TYPICAL PERIMETER DIFFUSER CONNECTION TO OVAL DUCTWORK

NOT TO SCALE

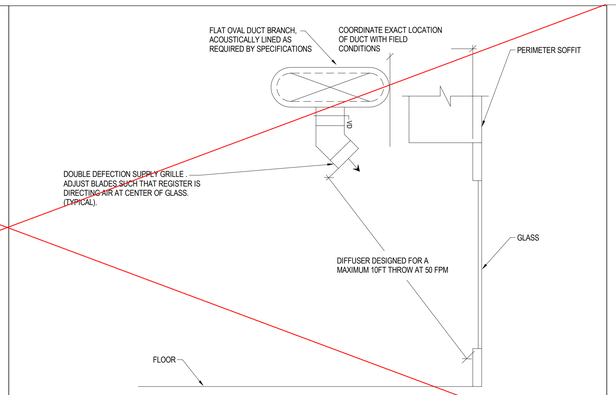


PERIMETER DIFFUSER CONNECTION TO DUCTWORK (BASED ON FIELD CONDITION)

NOT TO SCALE

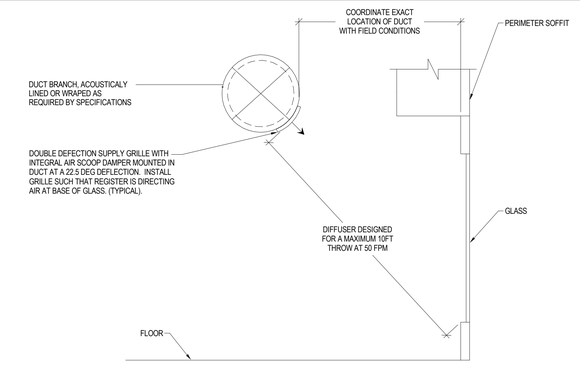

TYPICAL PERIMETER DIFFUSER CONNECTION TO ROUND DUCTWORK

NOT TO SCALE

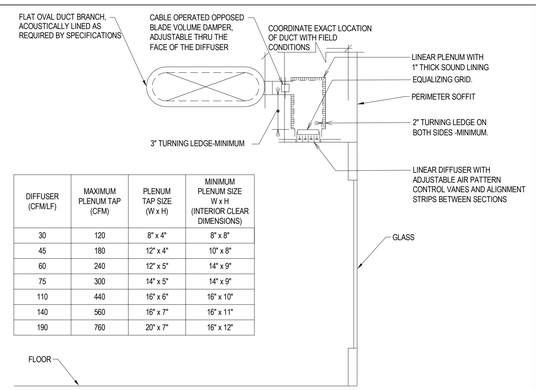

DIFFUSER (CFM/LF)	MAXIMUM PLENUM TAP (CFM)	PLENUM TAP SIZE (W x H)	MINIMUM PLENUM SIZE W x H (INTERIOR CLEAR DIMENSIONS)
30	120	8" x 4"	8" x 8"
45	180	12" x 4"	10" x 8"
60	240	12" x 5"	14" x 9"
75	300	14" x 5"	14" x 9"
110	440	16" x 6"	16" x 10"
140	560	16" x 7"	16" x 11"
190	760	20" x 7"	16" x 12"

PERIMETER LINEAR DIFFUSER CONNECTION TO DUCTWORK

NOT TO SCALE

MKDA
902 BROADWAY, NEW YORK, NY 10010 | 212.532.9800

ARCHITECT OF RECORD:
JOHN F. GIUSEFFI, ARCHITECT, PC.
902 BROADWAY, NEW YORK, NY 10010 | 212.532.9800

CLIENT:
snowflake
7 TIMES SQUARE
NEW YORK, NY 10036

MEP CONSULTANT:
AMA CONSULTING ENGINEERS
825 8TH AVE #18
NEW YORK, NY 10019
212.944.7722

AV/IT/SEC CONSULTANT:
NORTHLAND CONTROLS
44150 S GRIMMER BLVD
FREMONT, CA 94538

FOOD SERVICE DESIGN CONSULTANT:
COLBURN GUYETTE
100 LEDGEWOOD PL #104
ROCKLAND, MA 02370

DESIGN CONSULTANT:
JPC ARCHITECTS
909 112th Ave NE Suite 206
Bellevue, WA 98004

NO.	DATE	ISSUE
3	07/01/2026	ISSUE FOR ADD ALTERNATE
	05/22/2026	ISSUE FOR FILING
	04/03/2026	ISSUE FOR PRICING

REVISIONS

PROJECT:
SNOWFLAKE
7 TIMES SQUARE, NEW YORK, NY
FLOORS 29, 30, 31

DRAWING TITLE:
MECHANICAL DETAILS

SEAL & SIGNATURE

DATE: 05.22.2026
SCALE: N.T.S.
PROJECT NO. ----
DRAWN: CHECKED:
DRAWING NO. **M-904.00**

2026 MKDA, INC. ©
THESE PLANS ARE THE SOLE PROPERTY OF MKDA. USE WITHOUT PERMISSION IS STRICTLY FORBIDDEN AND WILL RESULT IN THE INITIATION OF LEGAL PROCEEDINGS

NYC DOB NUMBER
M01397257-S1